

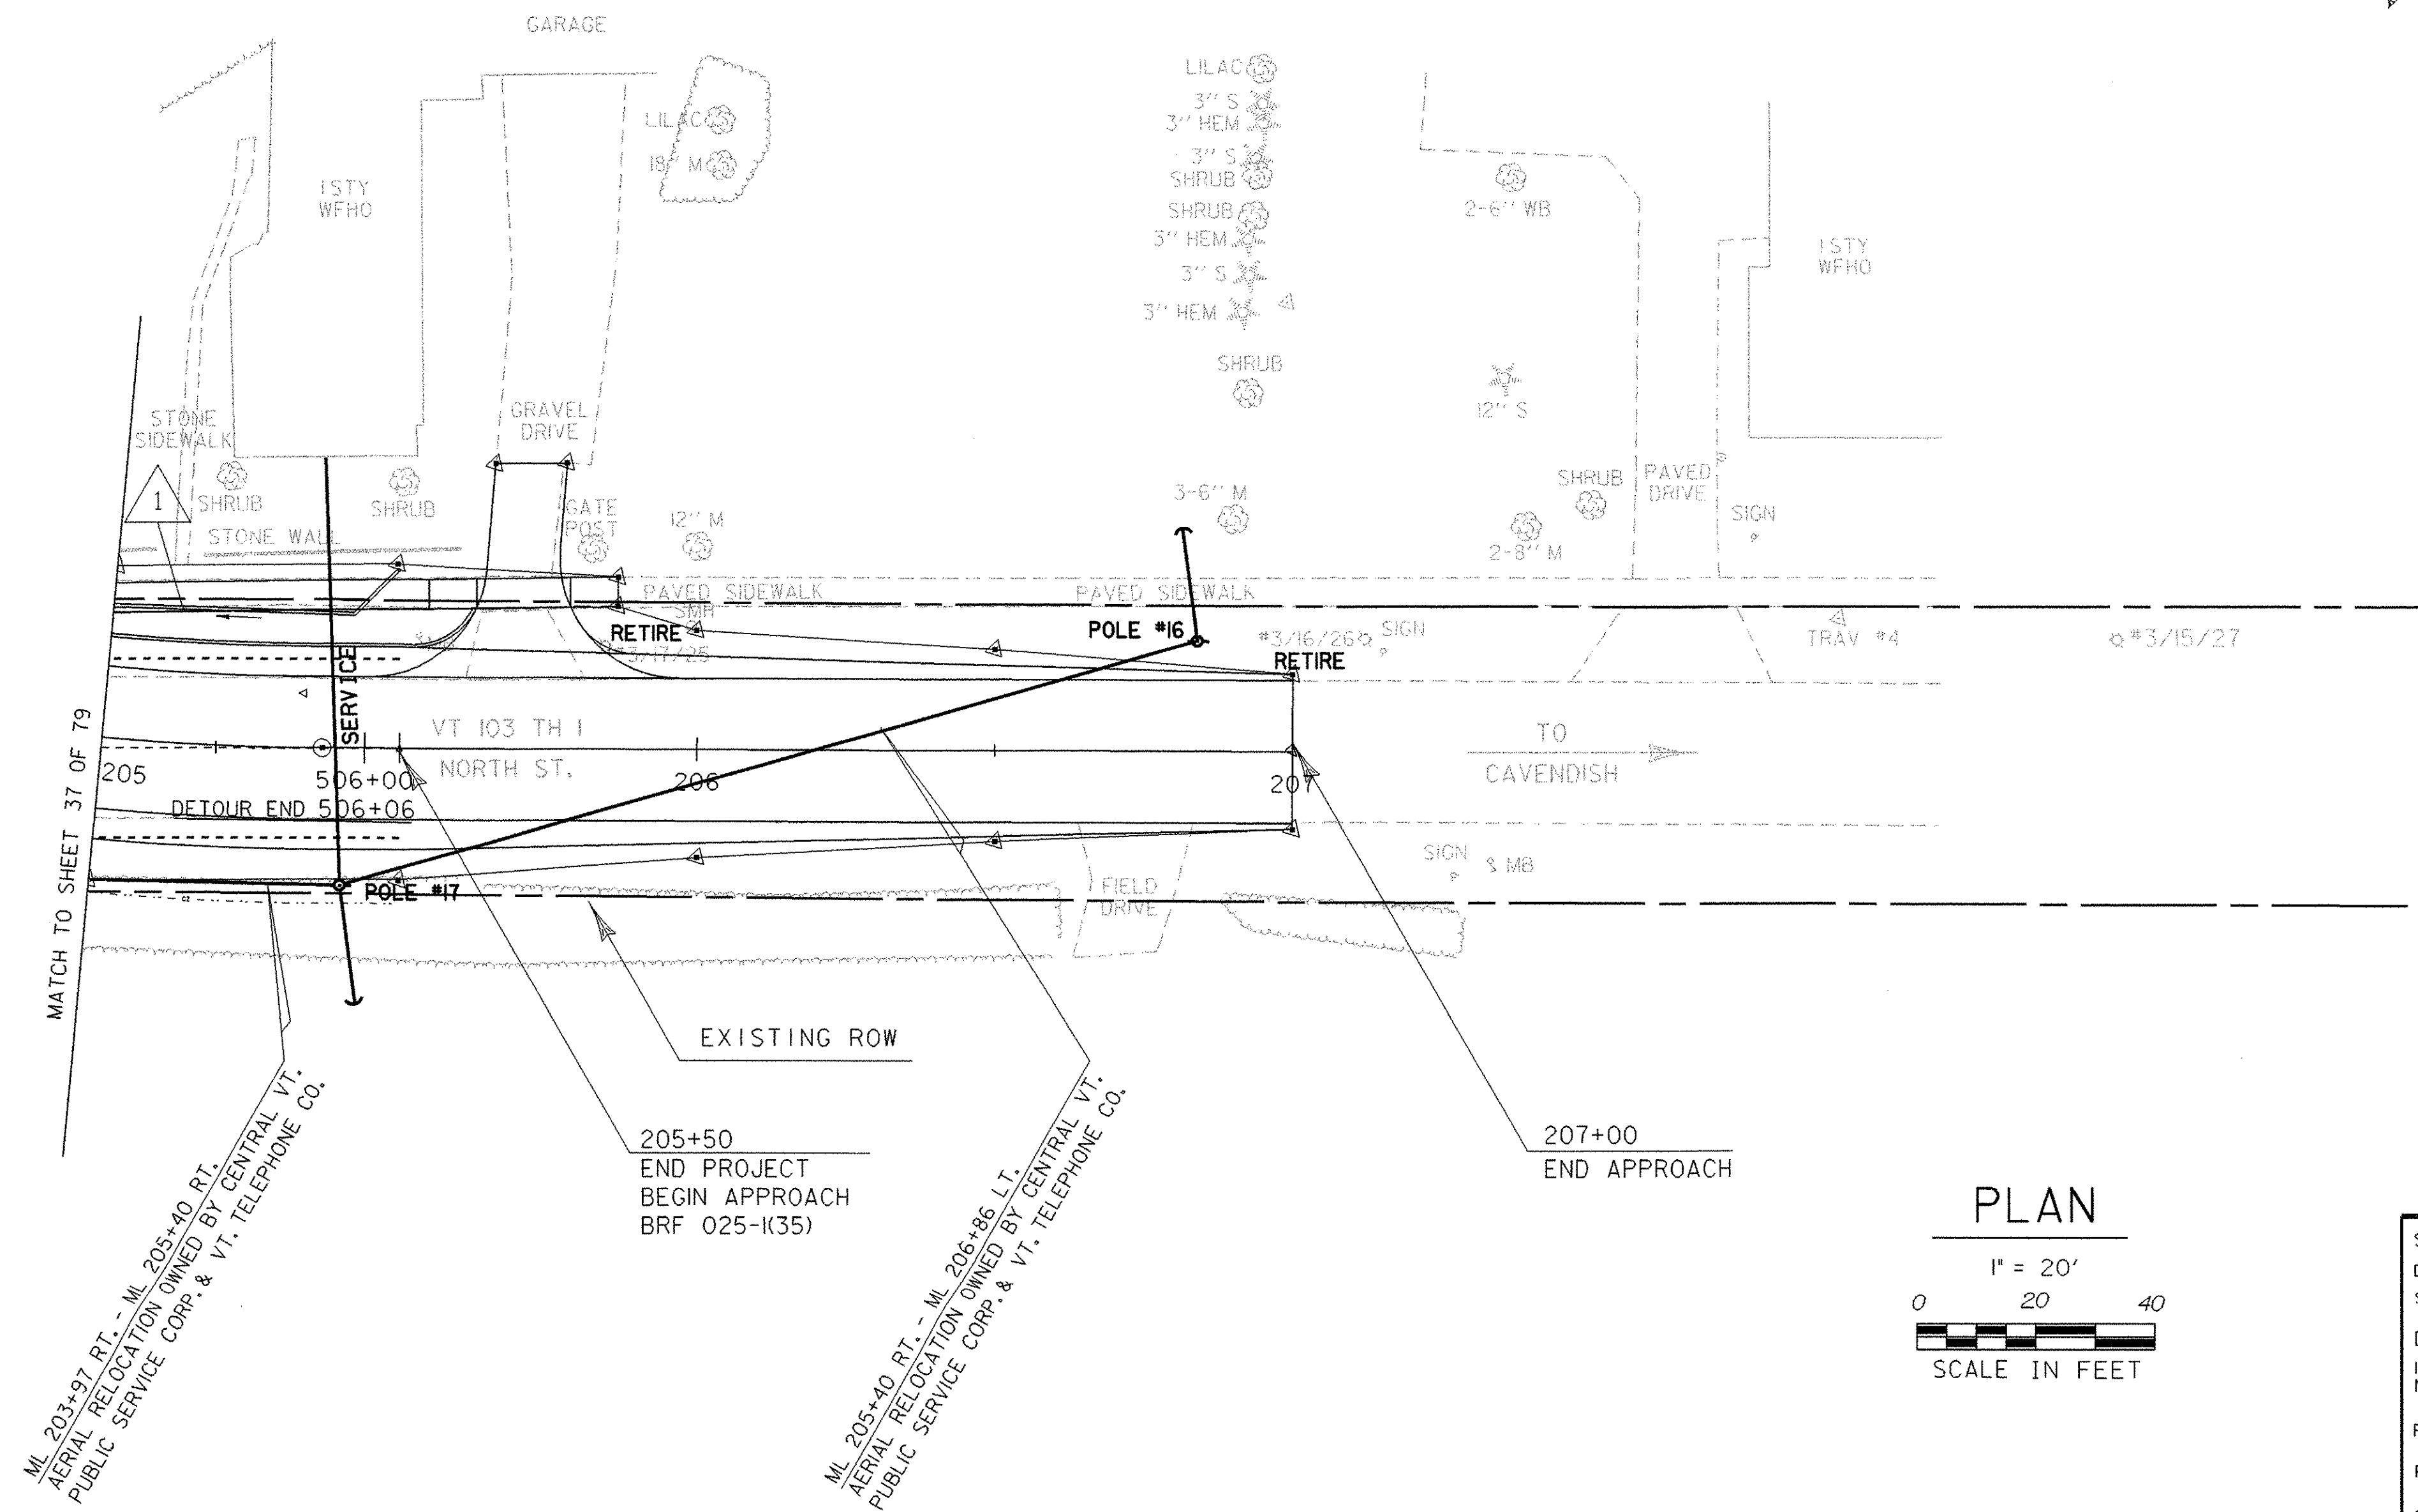


# UTILITY SHEET

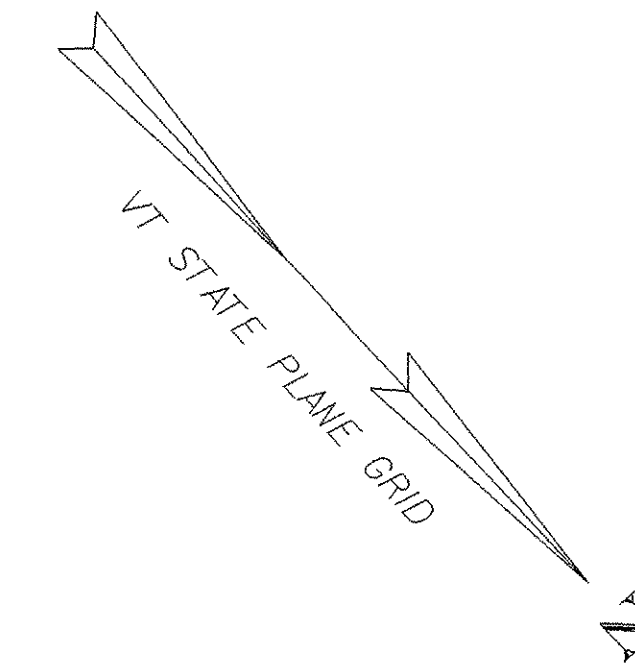

<b>DATUM</b>	
VERTICAL	NGVD 1929
HORIZONTAL	NAD 1927

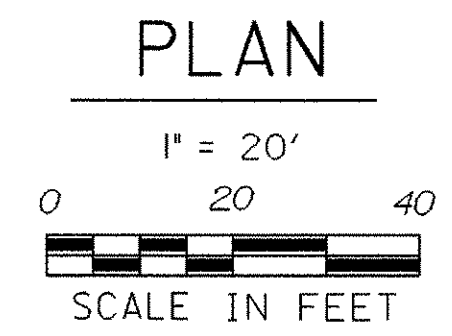

SURVEYED BY	SHERIDAN	DATE	08-90
DRAWN BY	L. BULLOCK	DATE	11-90
SQUAD LEADER	PORTALUPI		
DESIGN FILE NO.	M:\1549101\VA0T-Chester_Curv\HWY\DRAW\zfi34bdr.dgn		
IPARM NAME	zfi34ut3.1	DATE PLOTTED	28-MAY-2003
PROJ. NAME	CHESTER		
PROJ. NO.	BRF 025-1(35)		
SHEET	38	OF	79 SHEETS