

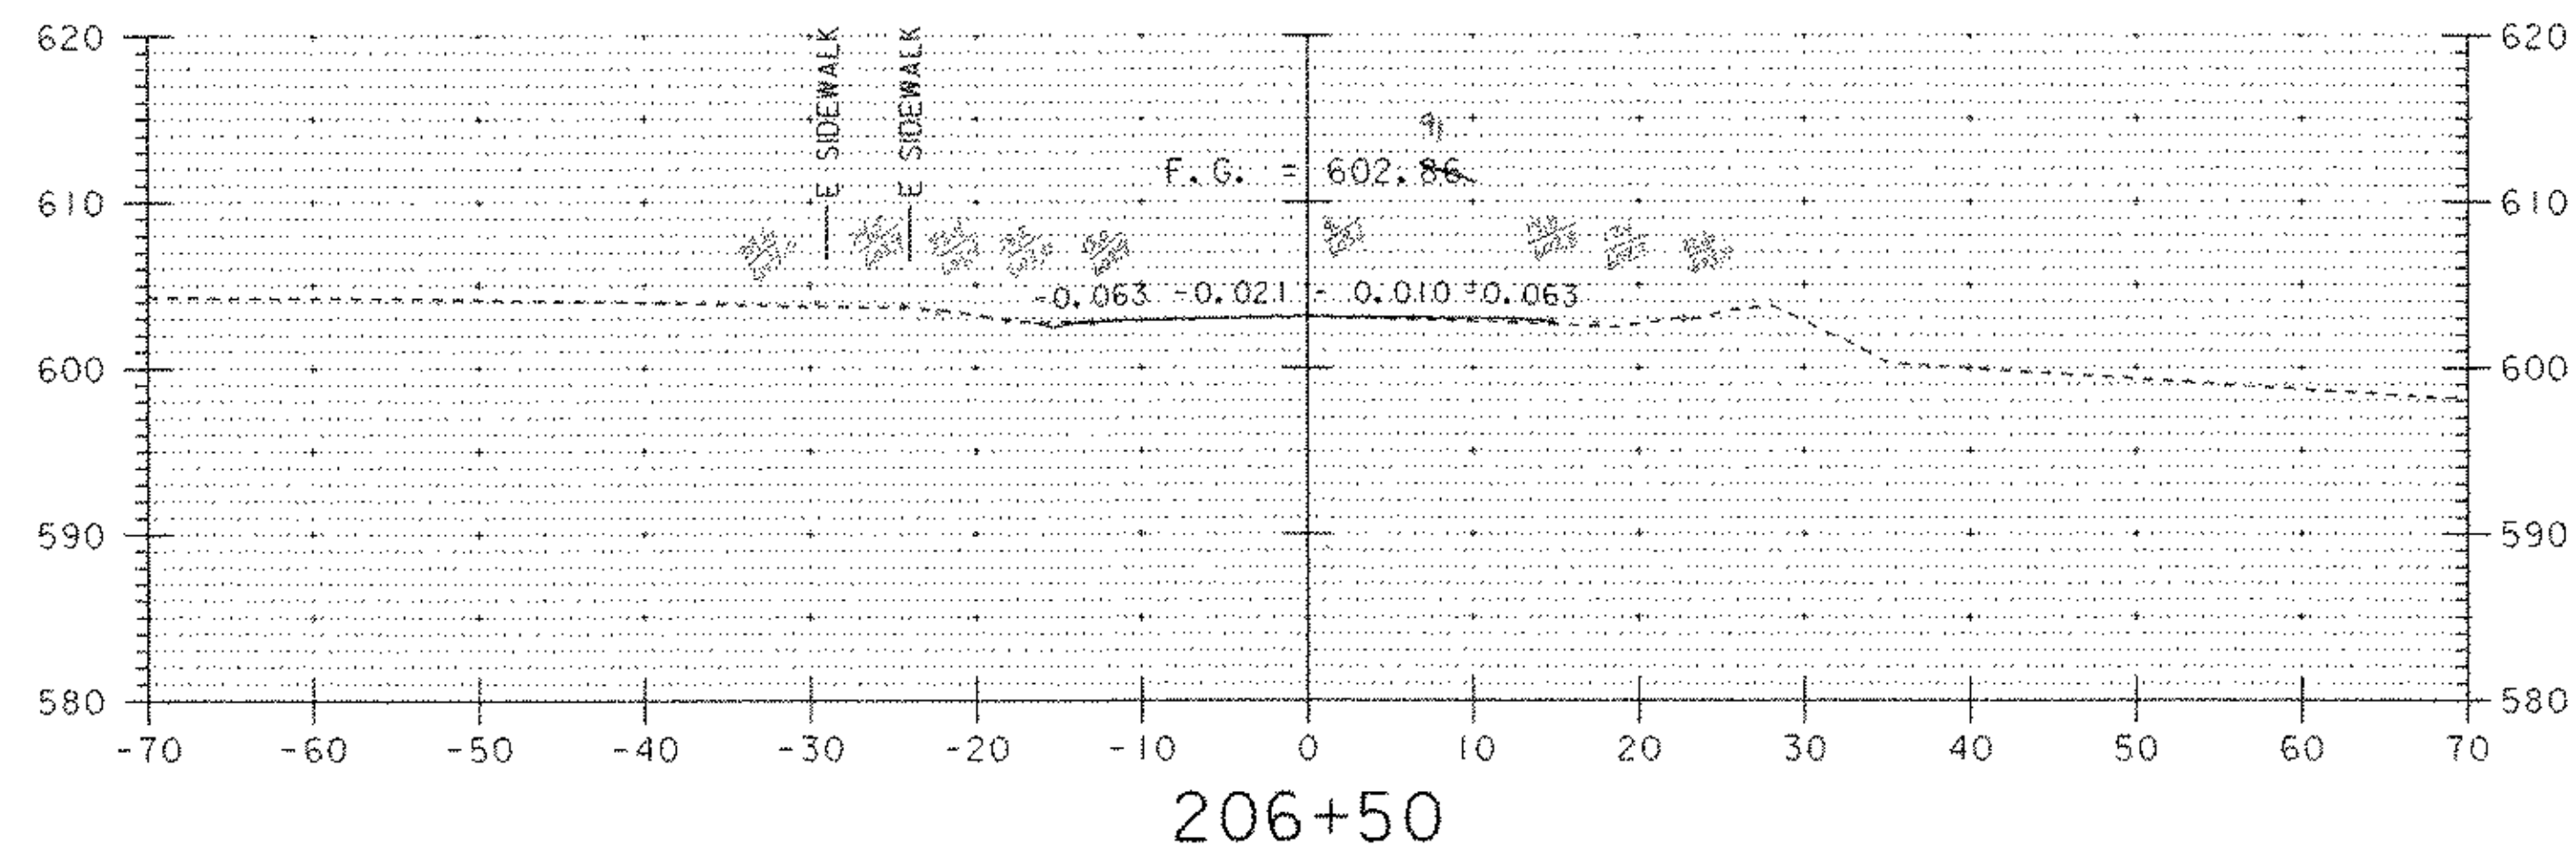
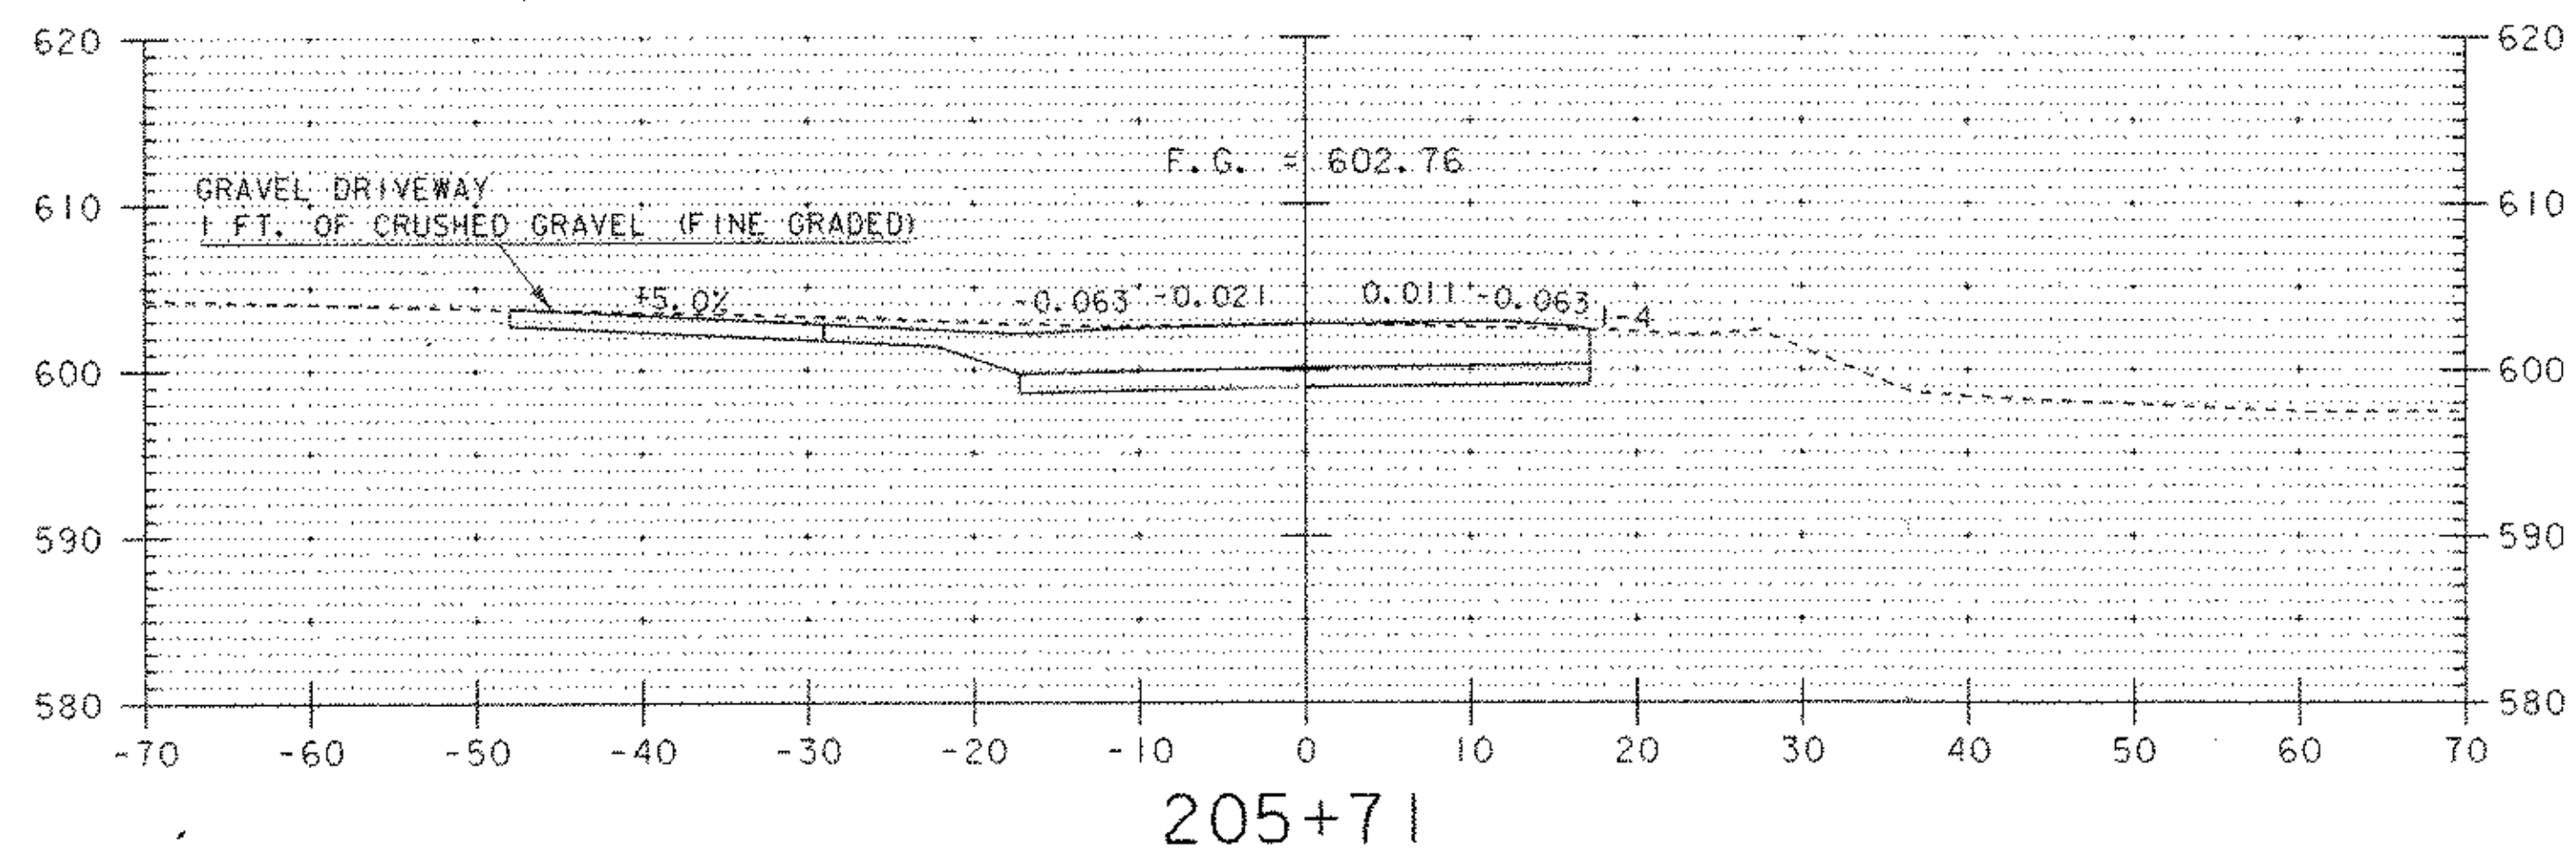
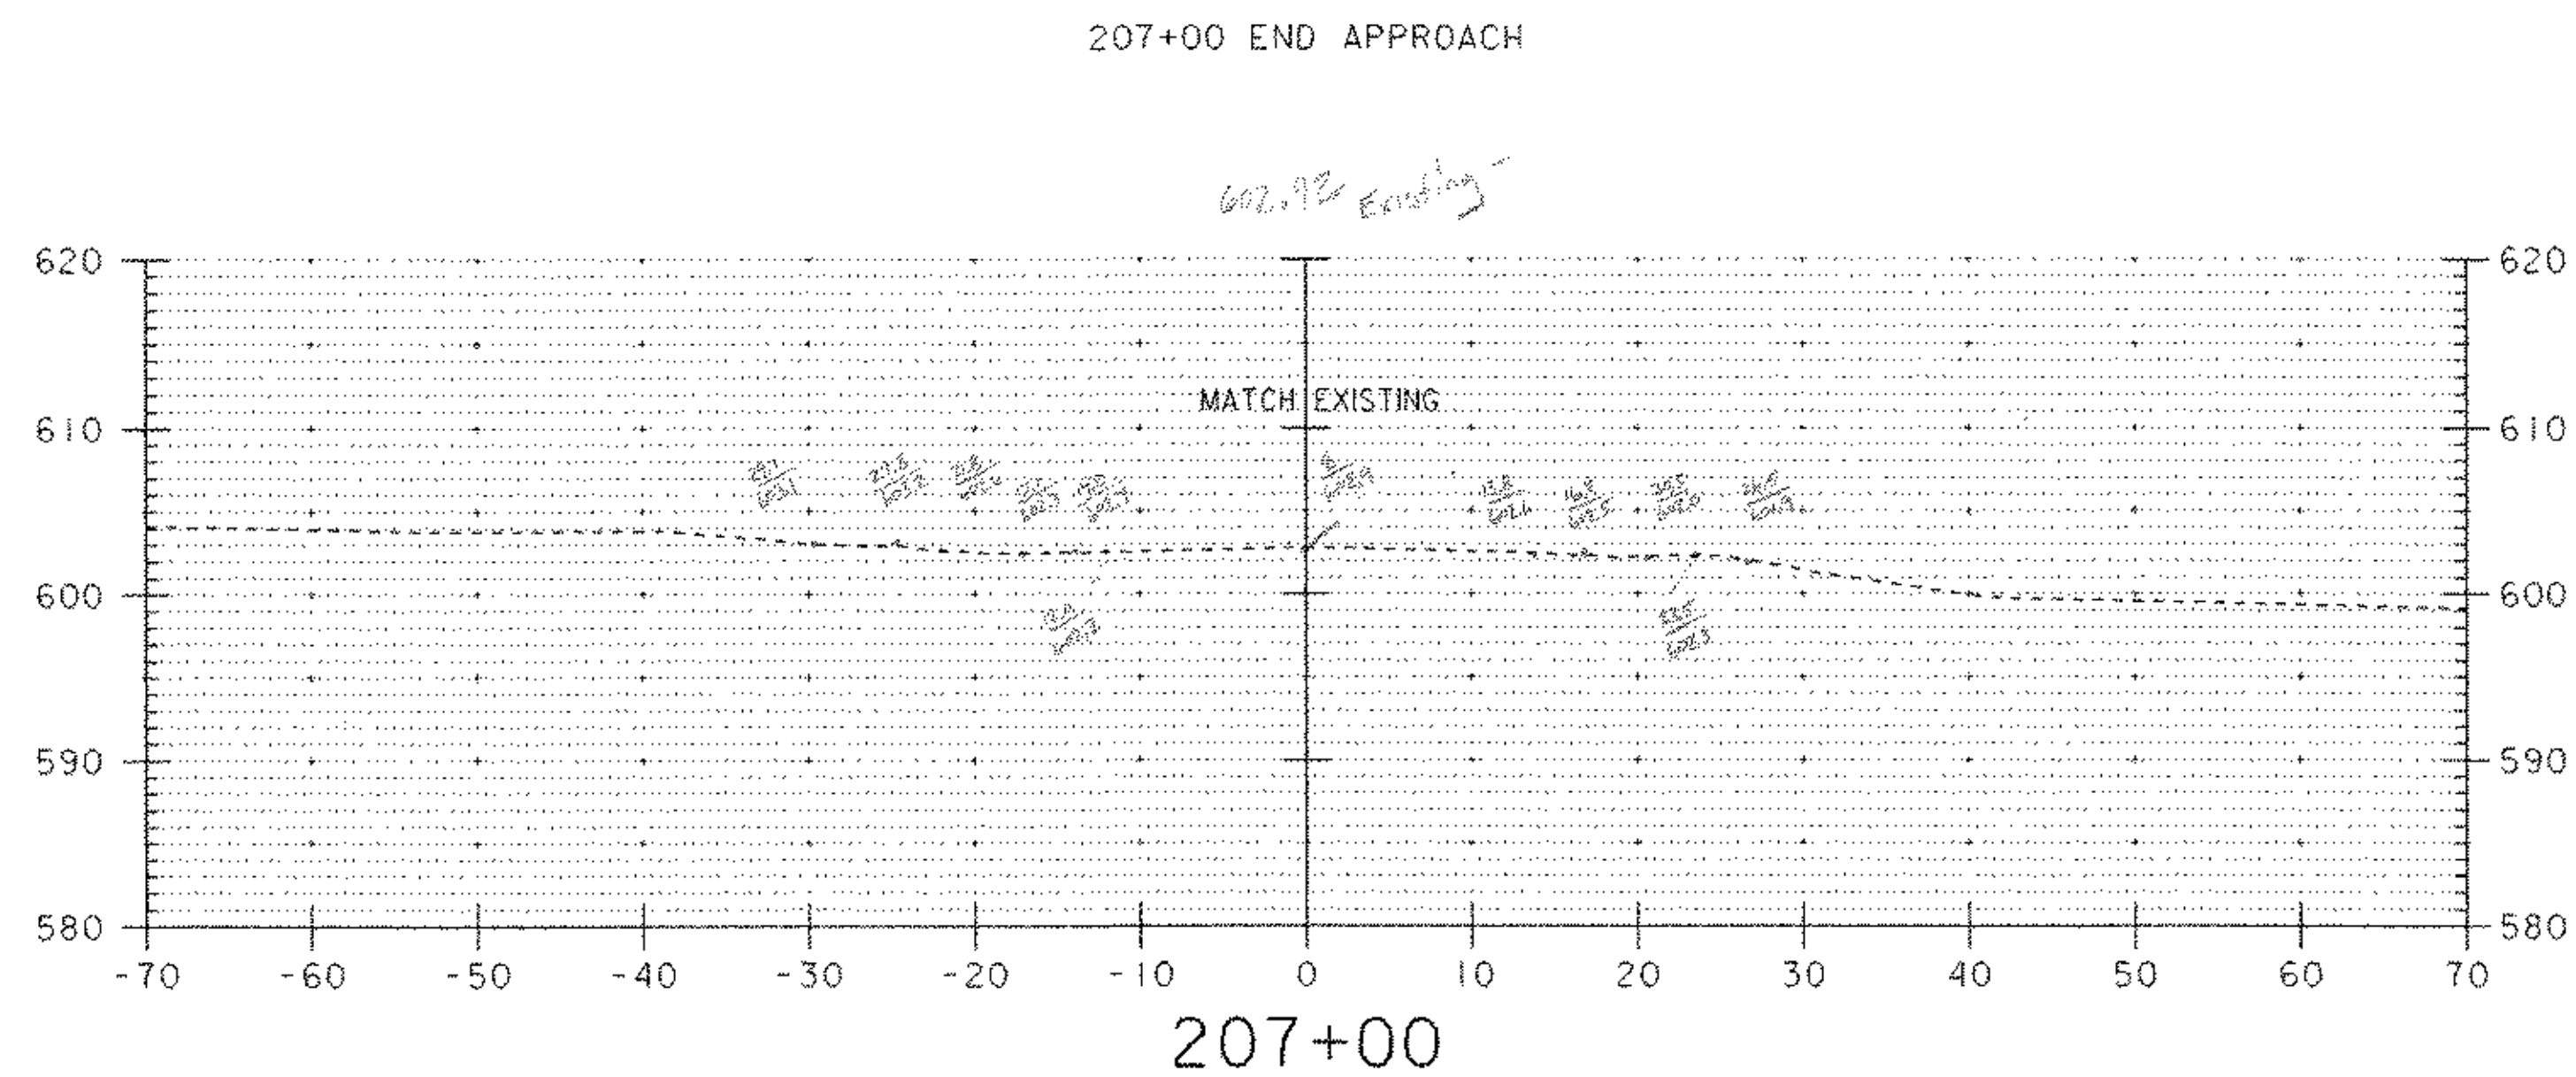


VT 103

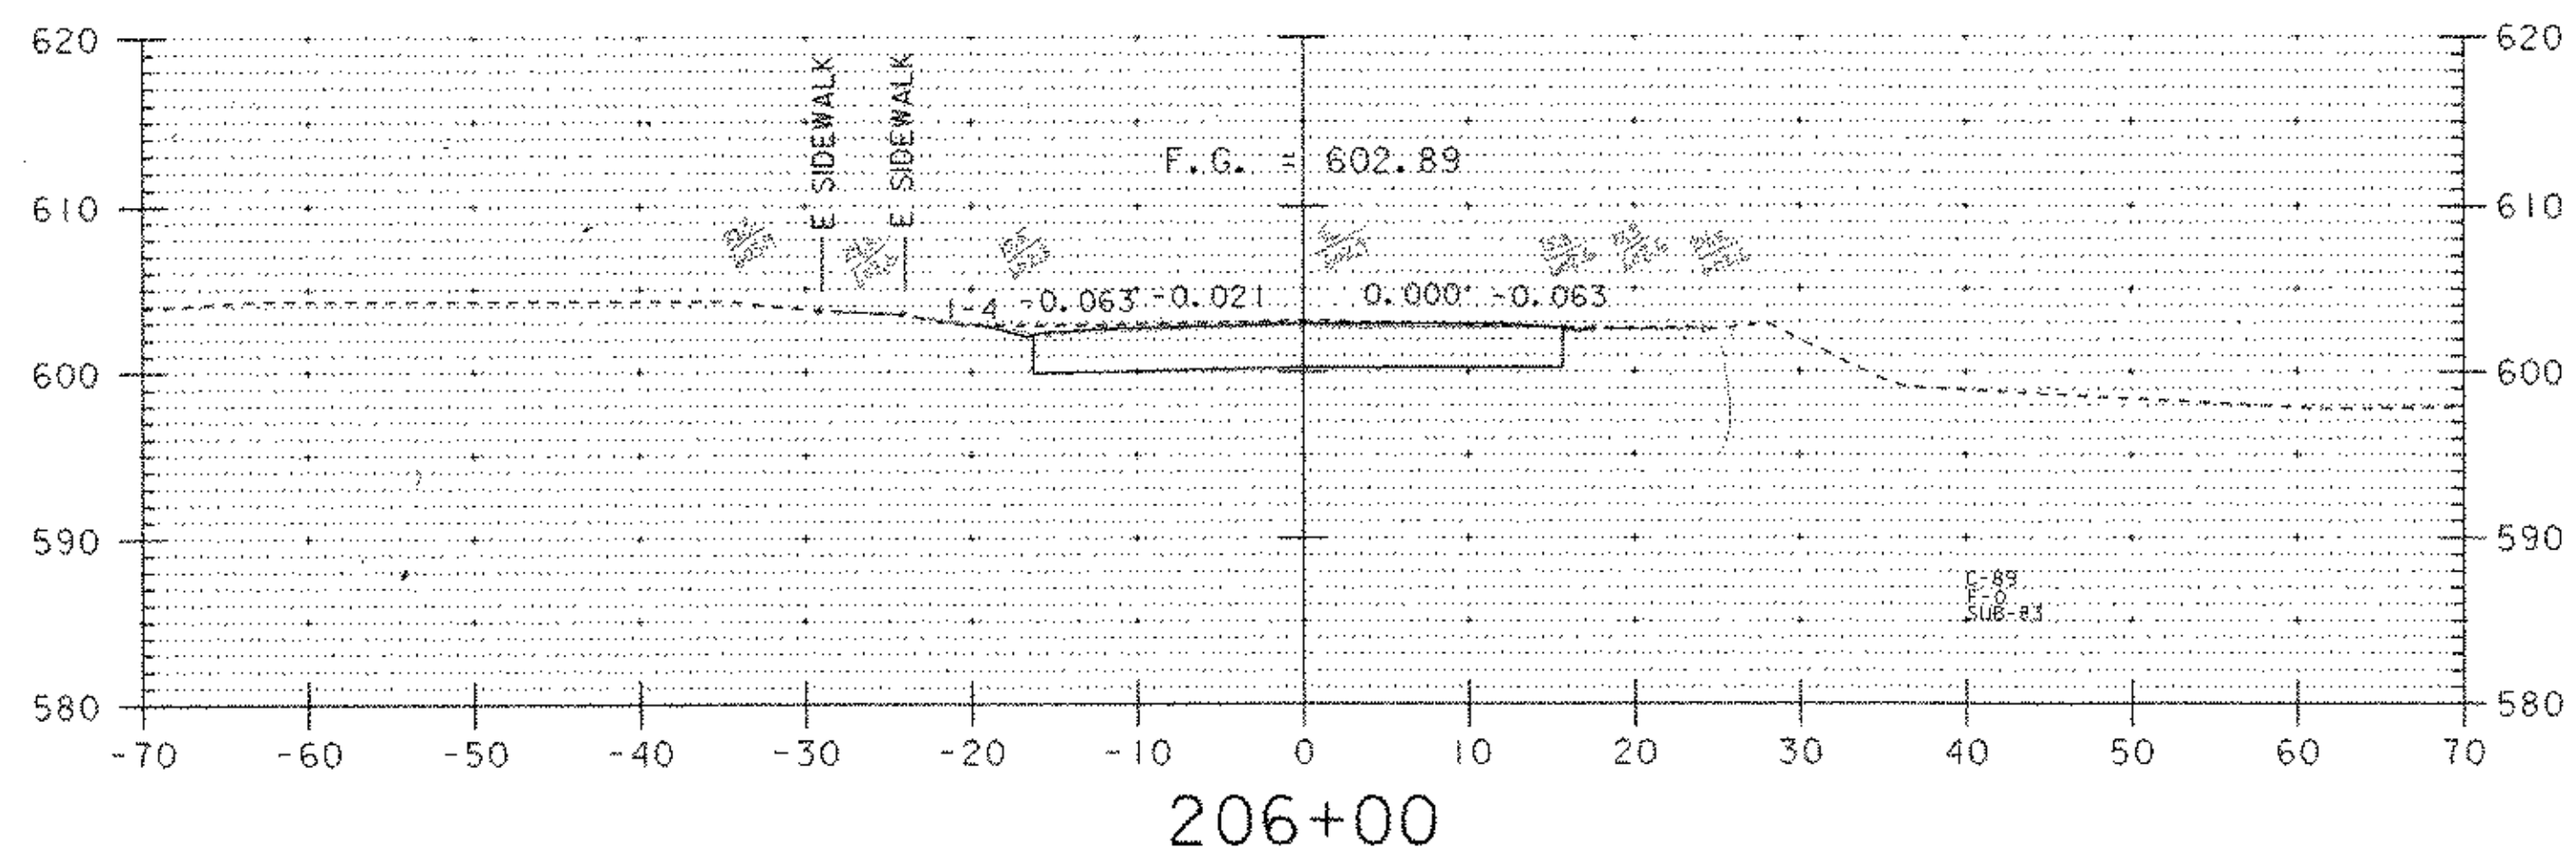

DATUM
 VERTICAL NCVD 1929
 HORIZONTAL NAD 1927

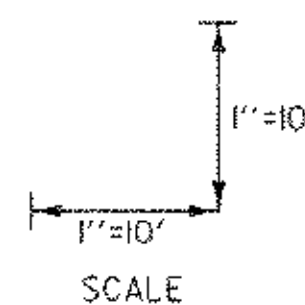

PROJECT: CHESTER	PROJECT NO.: BRF 025-1(35)
DESIGN FILE NAME: M:\154910\A01 Chester Curv\HWY\DRAW\zf134xs5.dgn	
IPARM FILE NAME: zf134xs4.i	
SURVEYED BY: SHERIDAN	PLOT DATE: 28-MAY-2003
SQUAD LEADER: PORTALUPI	SURVEY DATE: 8/90
VT 103 SECTIONS	DRAWN BY: L. BULLOCK
	SHEET: 73 OF 79