
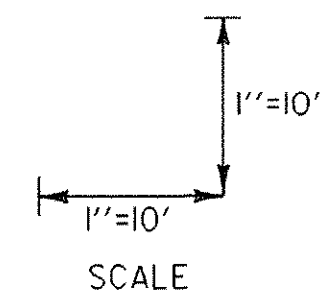
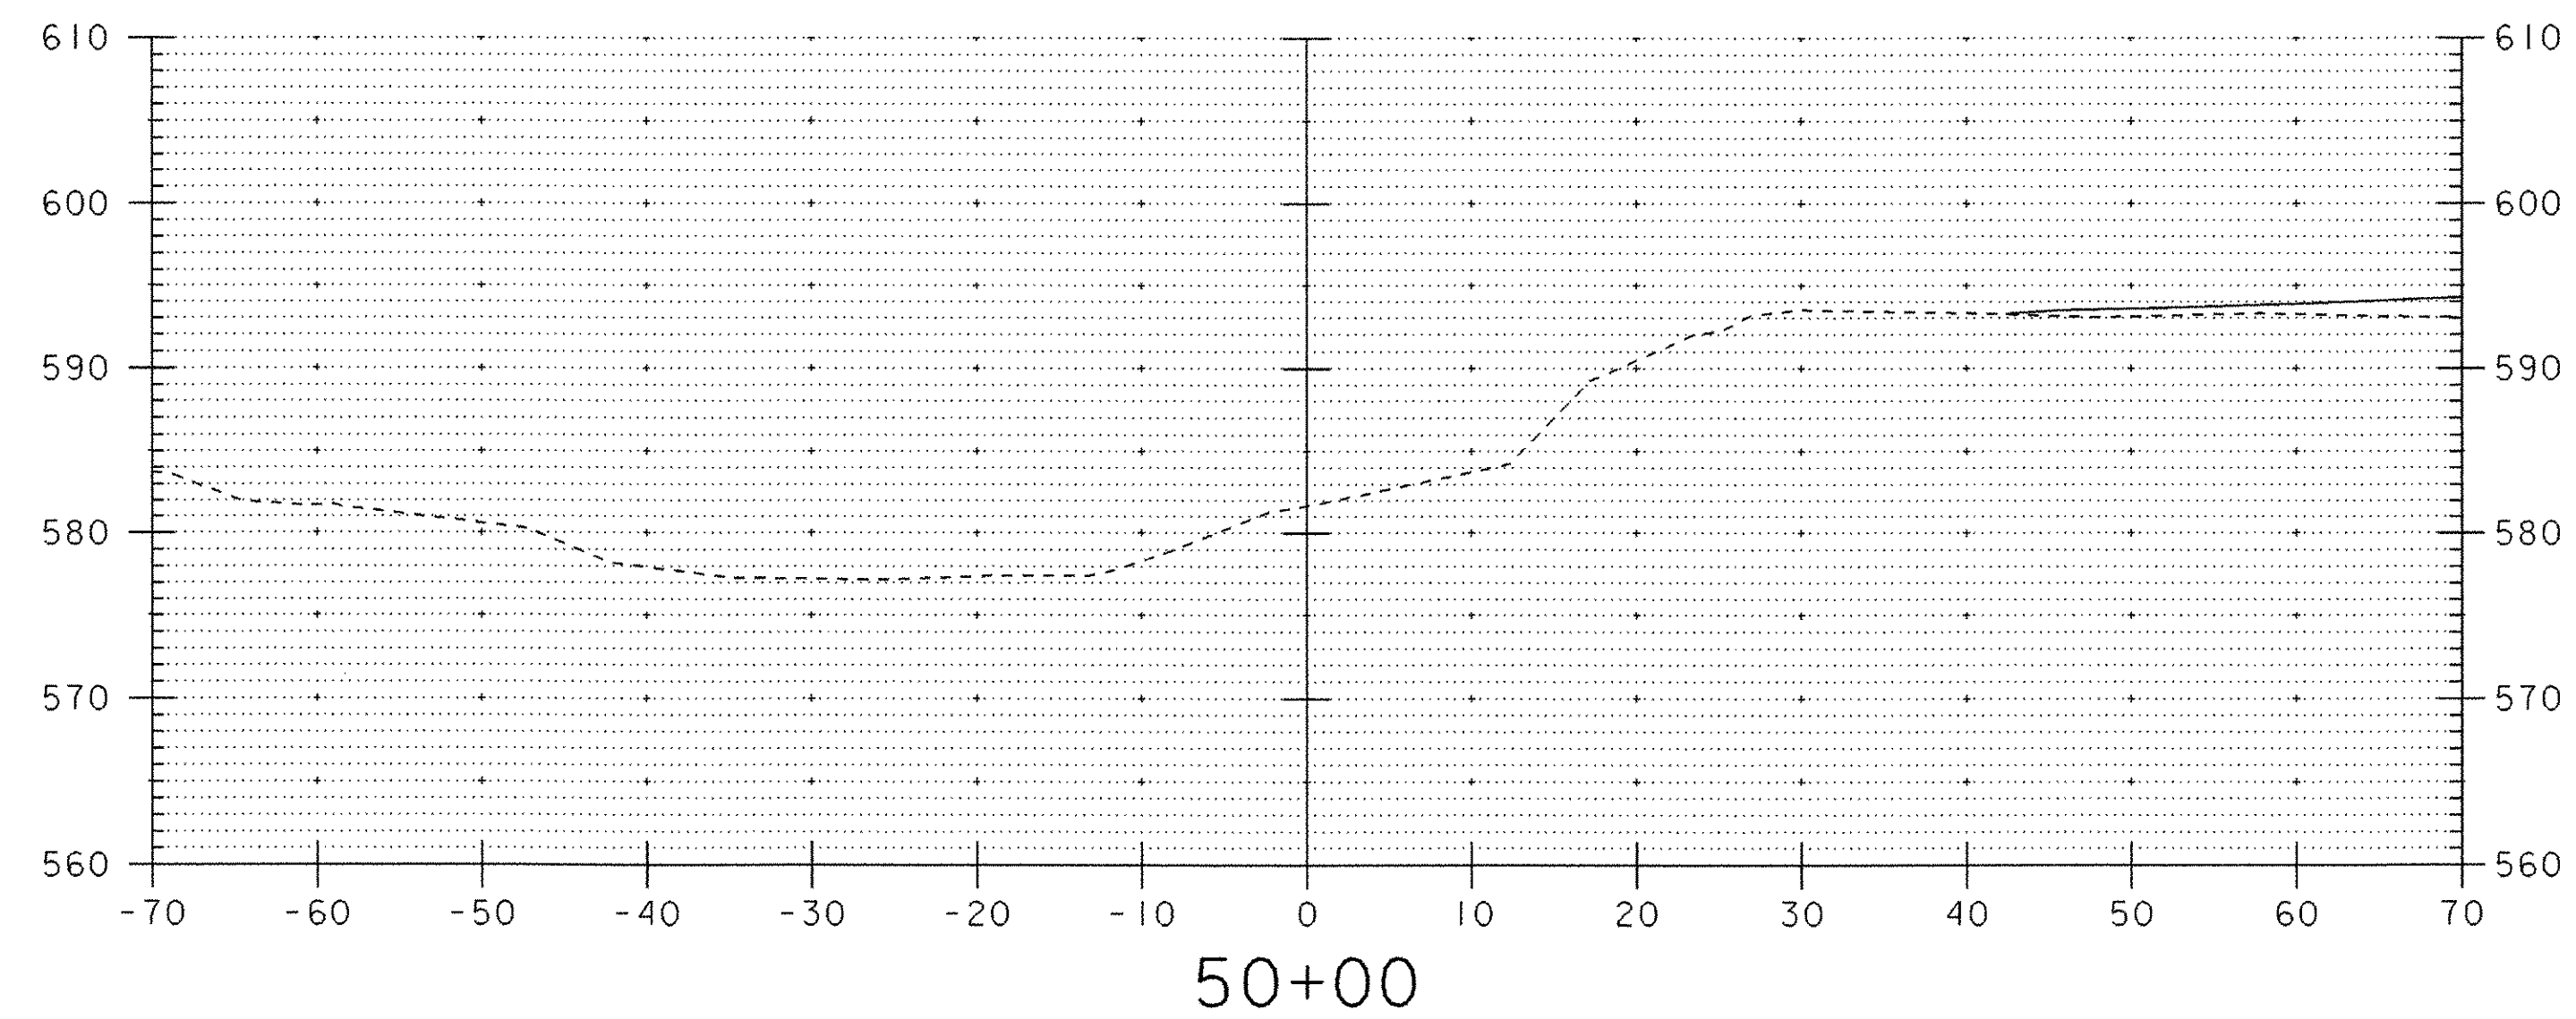


# CHANNEL LINE #1

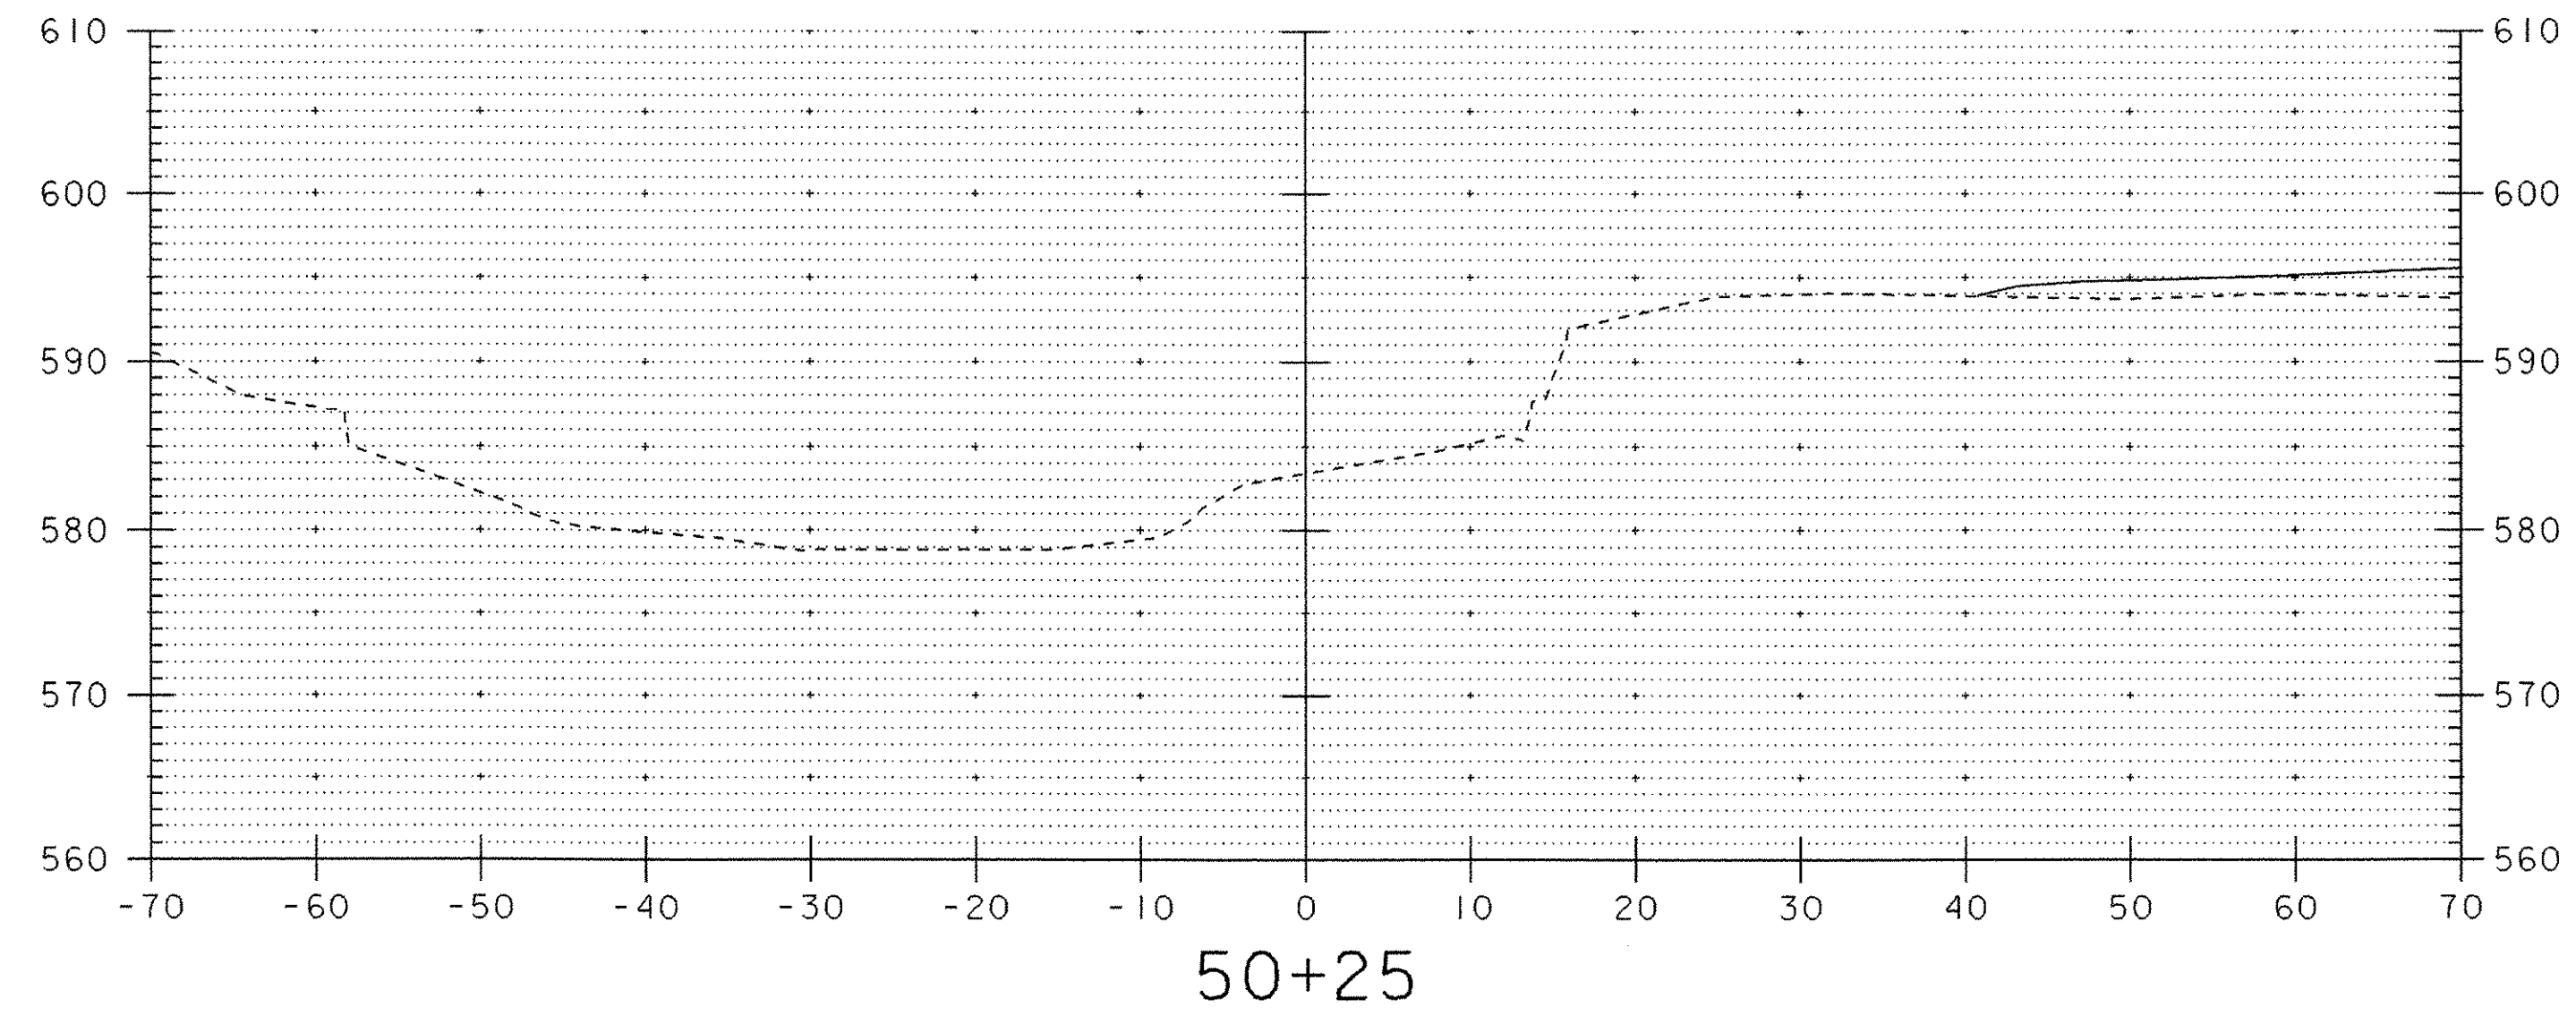

**DATUM**  
 VERTICAL NGVD 1929  
 HORIZONTAL NAD 1927

PROJECT:	CHESTER	PROJECT NO.:	BRF025-1 ( 35)
DESIGN FILE NAME:	M:\1549101\VA0T Chester Curv\HWY\DRAW\z f134xs5.dgn	PLOT DATE:	28-MAY-2003
IPARM FILE NAME:	z f134cla.i	SURVEY DATE:	8/90
SURVEYED BY:	SHERIDAN	DRAWN BY:	LACKEY
SQUAD LEADER:	PORTALUPI	CHANNEL LINE #1 SECTIONS	SHEET: 75 OF 79