

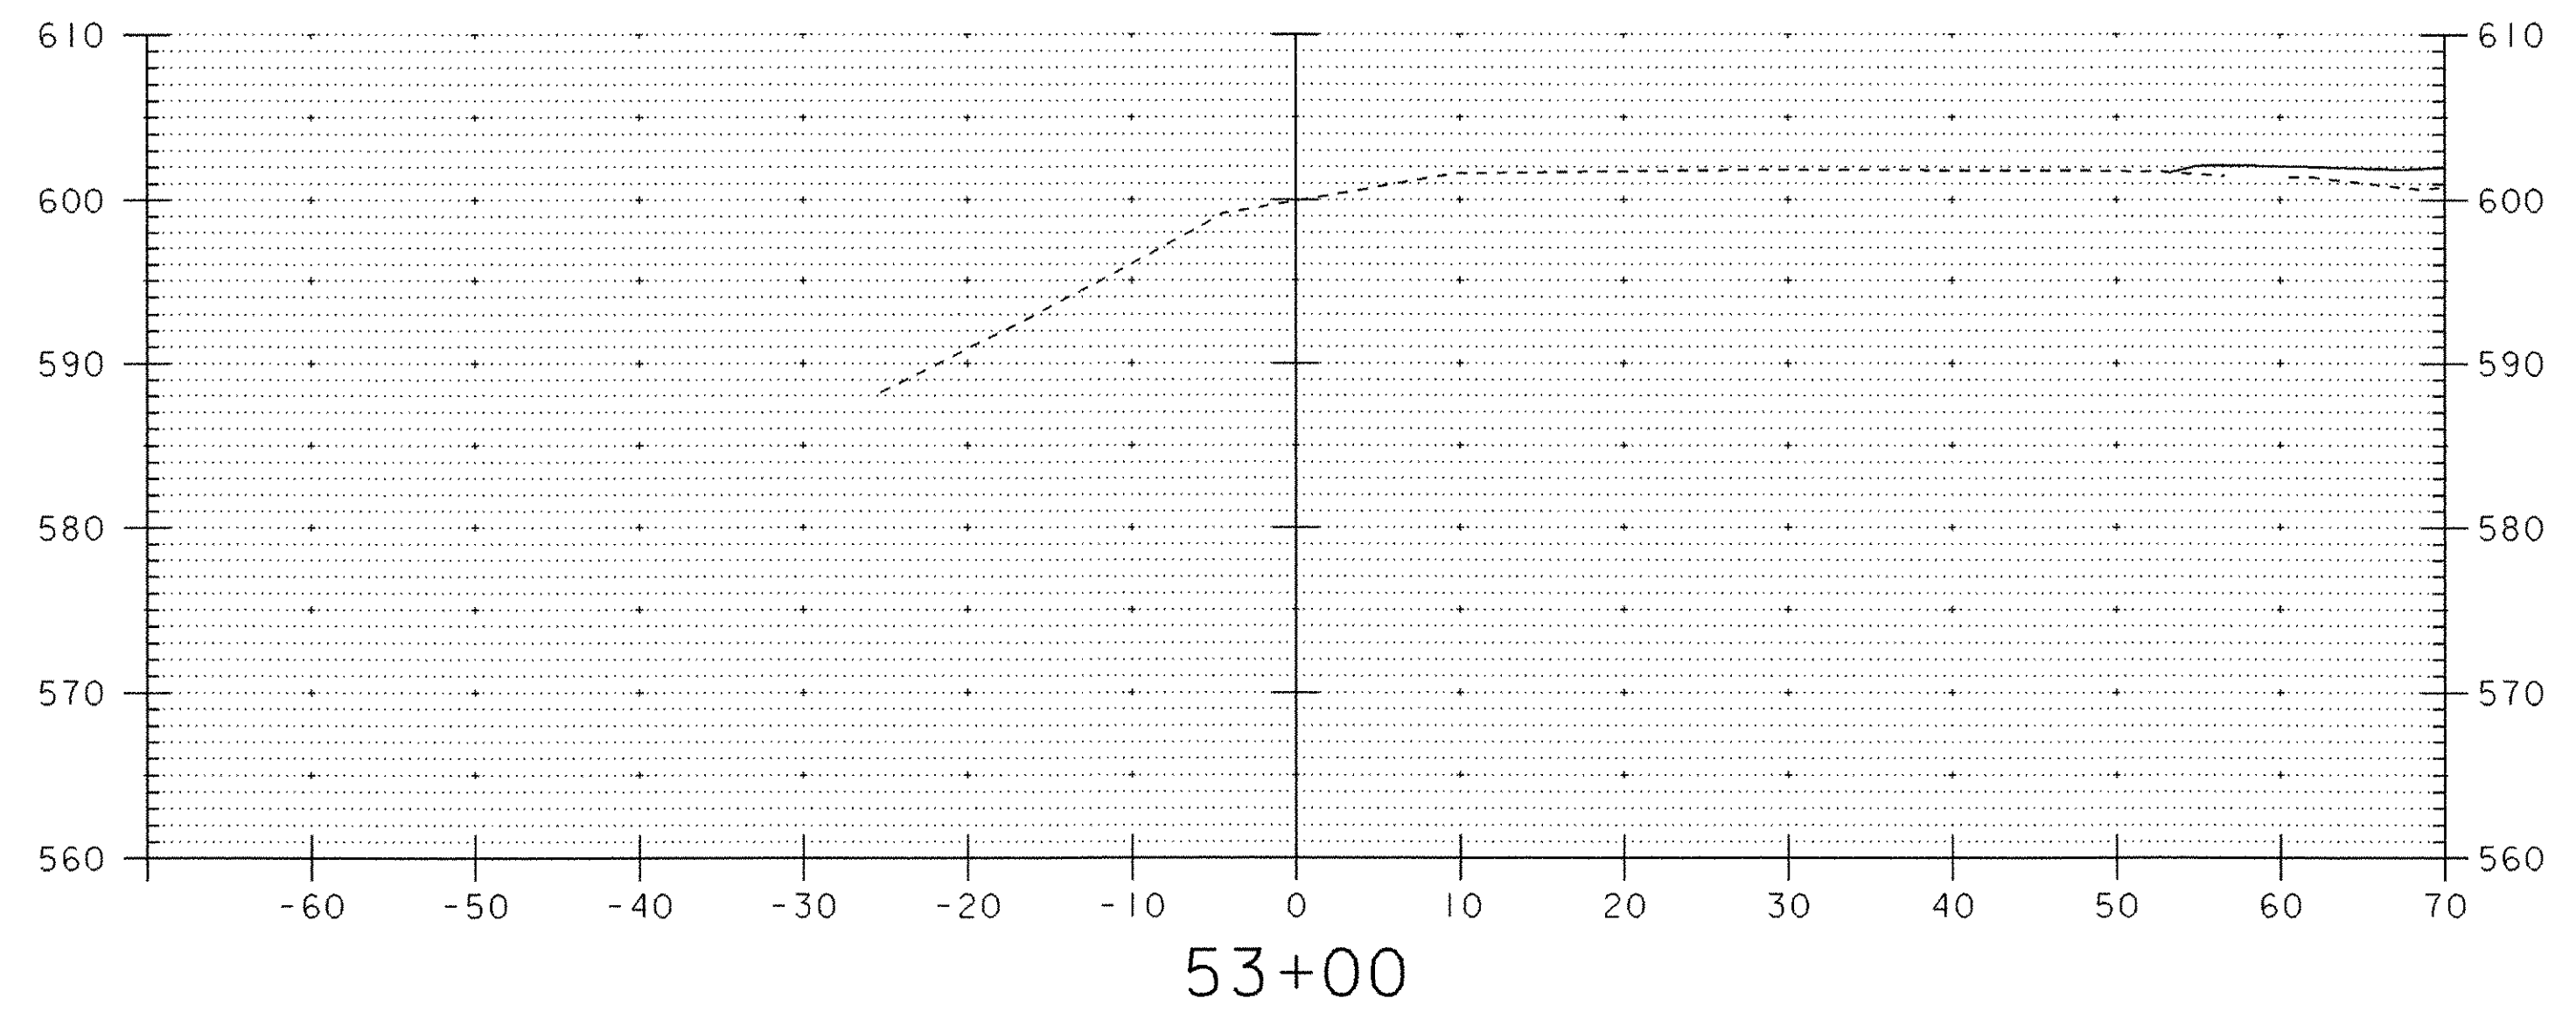
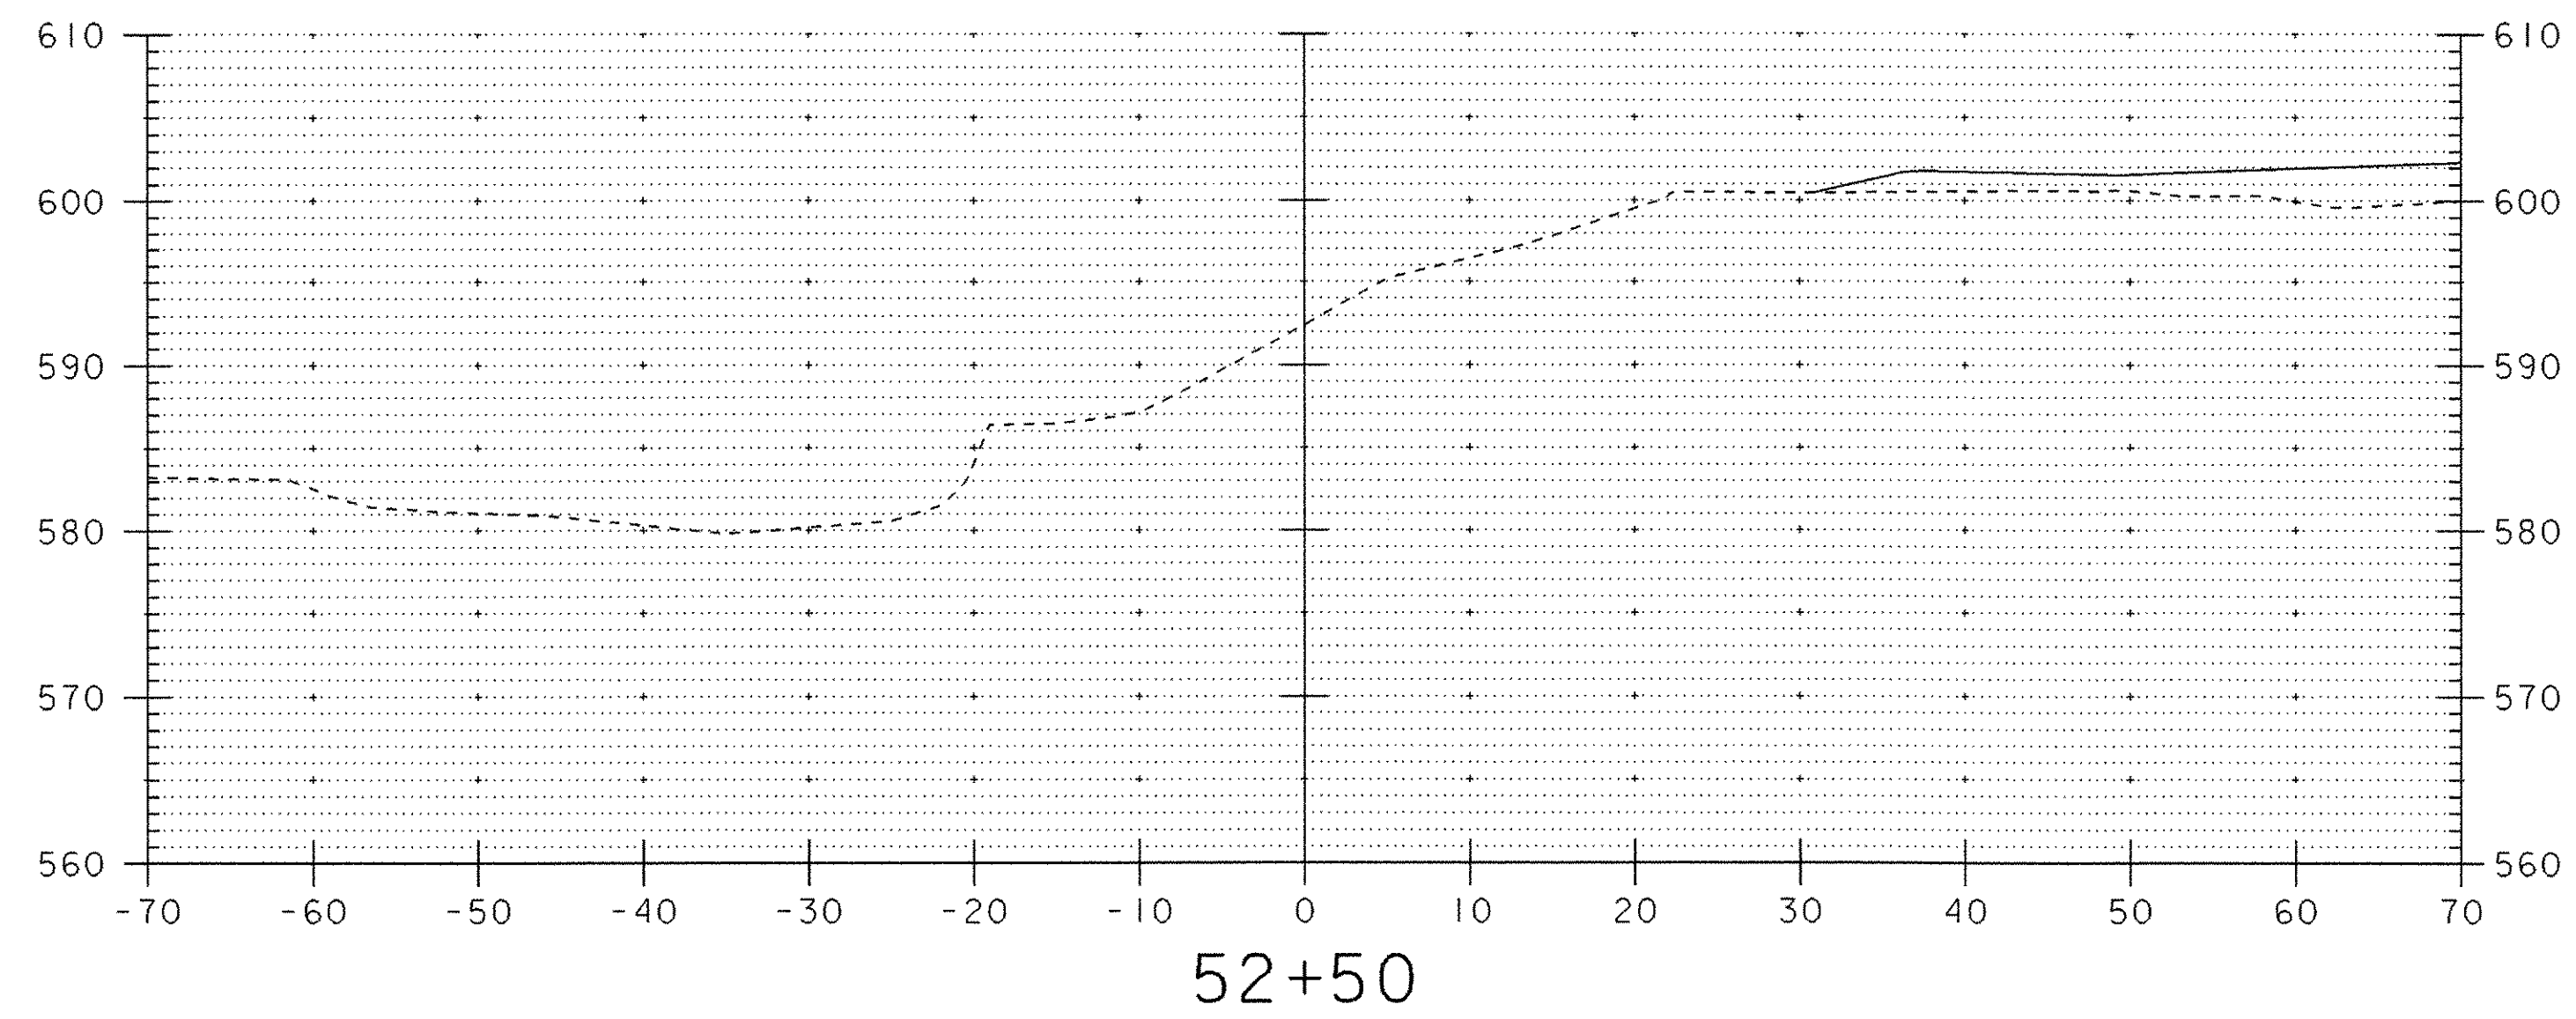


# CHANNEL LINE #1

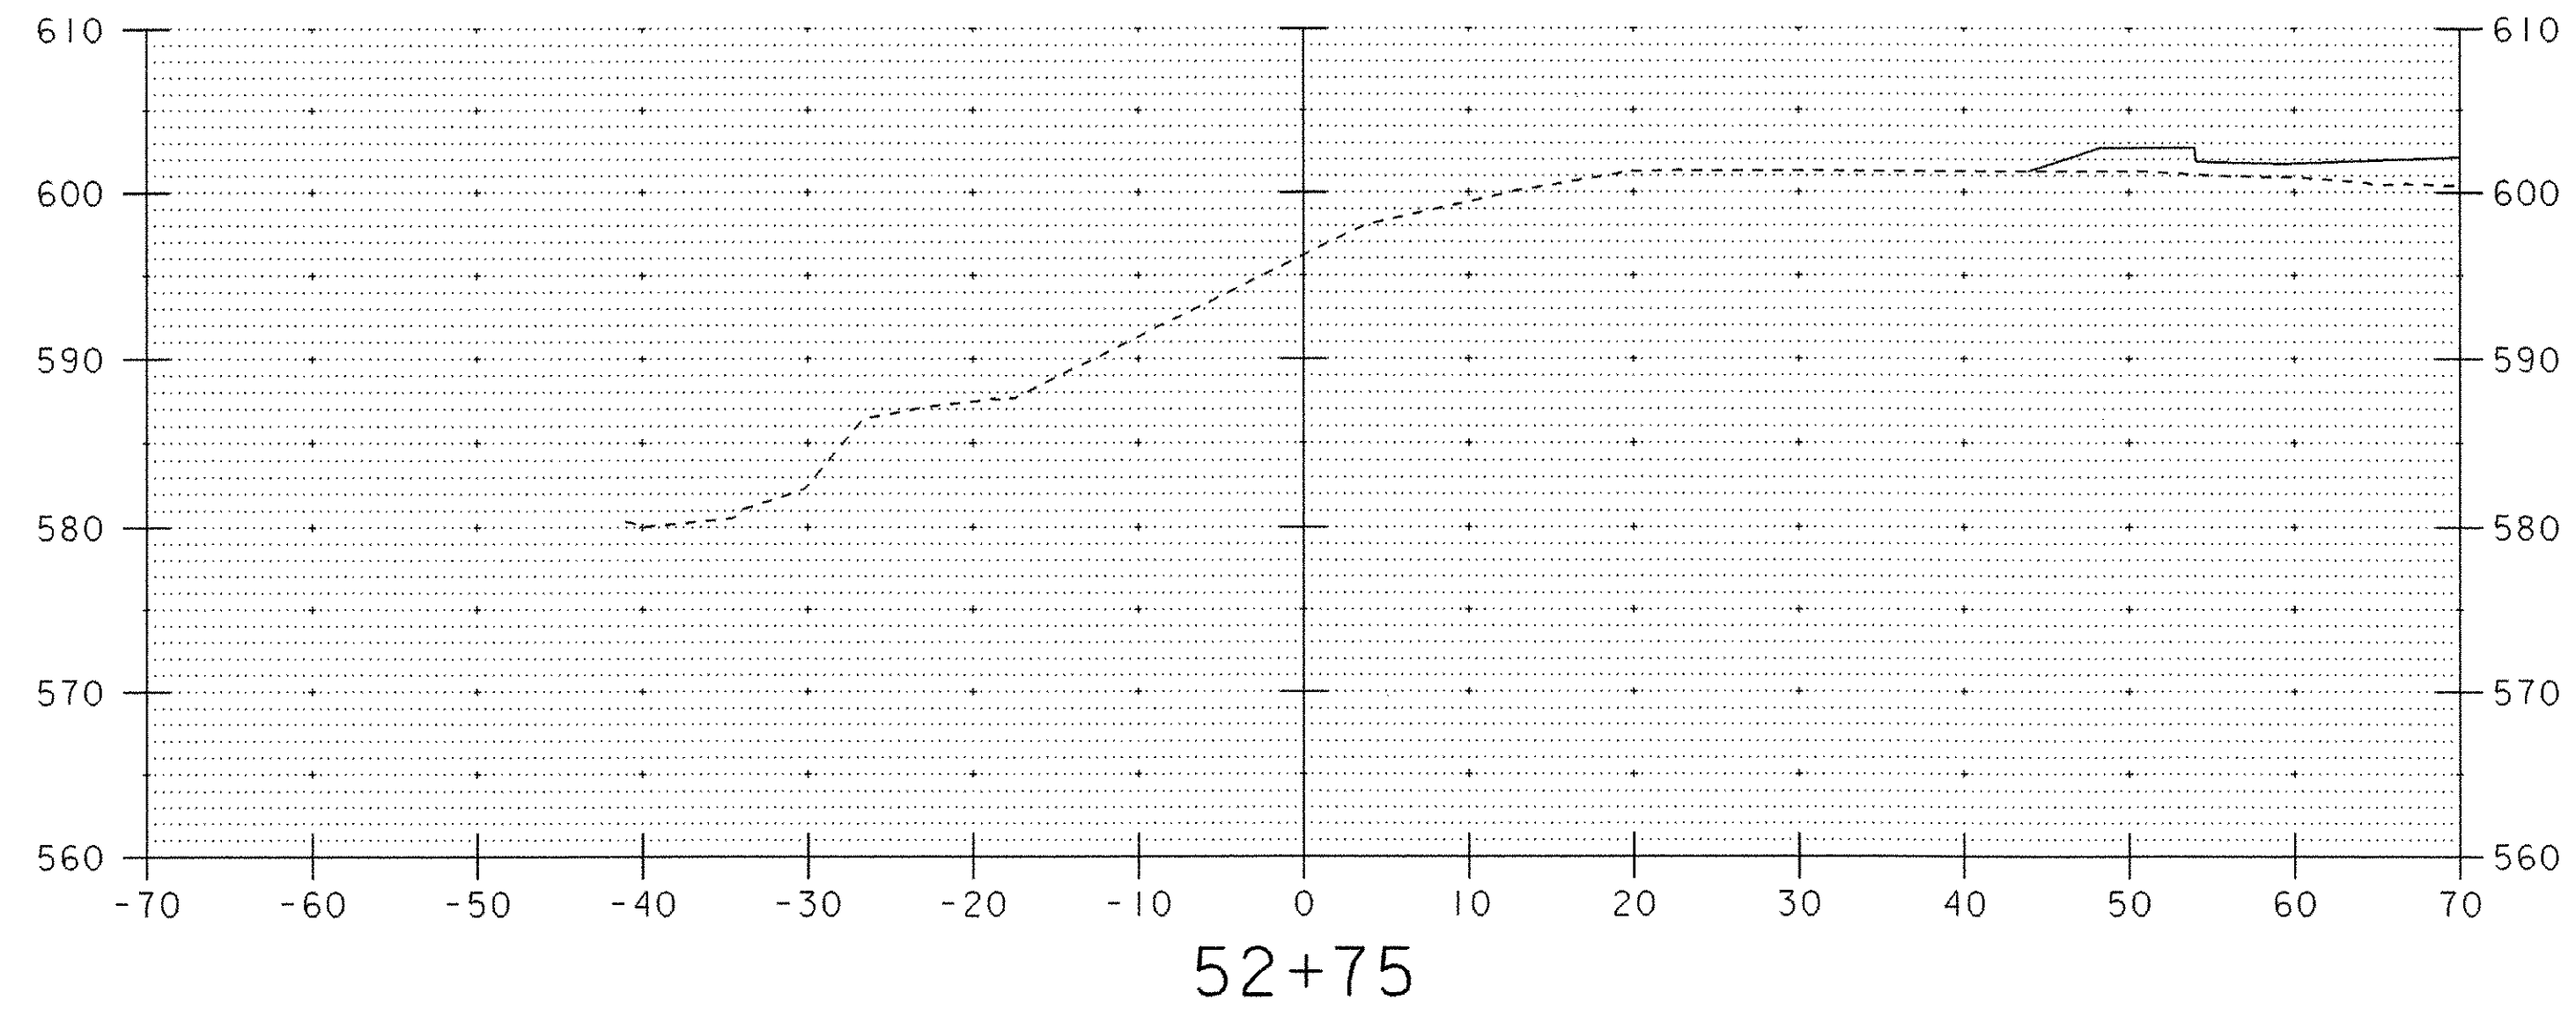

**DATUM**  
 VERTICAL NGVD 1929  
 HORIZONTAL NAD 1927

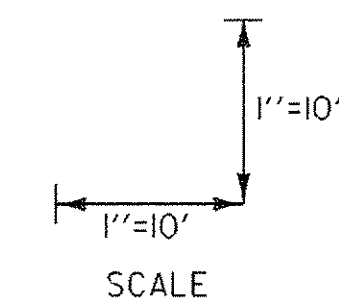

PROJECT:	CHESTER	PROJECT NO.:	BRF025-1 (35)
DESIGN FILE NAME:	M:\1549101\VA01\Chester Curv\HWY\DRAW\zfi34xs5.dgn	PLOT DATE:	28-MAY-2003
IPARM FILE NAME:	zfi34cle.i	SURVEY DATE:	8/90
SURVEYED BY:	SHERIDAN	DRAWN BY:	BULLOCK
SQUAD LEADER:	PORTALUPI	SHEET:	79 OF 79
CHANNEL LINE #1 SECTIONS			