

NOTES:
 1- GENERAL NOTES: SEE DRAWING GN1
 2- HOLES : 15/16" (U.N.O.)

Reviewed
 Rejected
 Furnish as Corrected
 Revise and Resubmit
 Submit Specification Item


The review is only for general conformance with the design criteria and the information given in the Construction Documents. Conditions or errors not shown on the shop drawings, during the review do not relieve the contractor of his responsibility with the manufacturer of the plate and specifications. Review is a service and shall not include detection of an assembly of which the fabricator is responsible. The Contractor is responsible for dimensions to be confirmed and accurate fit the particular information that pertains to the fabrication process or to the material, structural, substructure, equipment, and procedures of construction, coordination of the work with that of all other trades and maintaining all work in a safe and satisfactory manner.

McFarland-Johnson, Inc.
 Date: 12-17-03
 By: RSW

RESERVED FOR STAMPS

DRAWINGS PREPARED BY:
 AMEC E&C SERVICES LTD, 4765 1ST AVENUE, SUITE 120, CHARLESBOURG (QUEBEC), CANADA G1H 2T3 #030731-EAS

REV	DATE	DESCRIPTION	QTY	DATE	ISSUED TO	APPROVAL	FOR
				11/17/03	FRANK W. WHITCOMB CONSTRUCTION CO.		

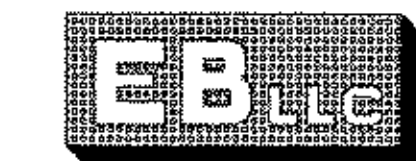

PROJECT: BRIDGE #12 VT 103-TH OVER WILLIAMS RIVER
 LOCATION: CHESTER, VERMONT
 ENGINEER: MCFARLAND-JOHNSON, INC.
 CUSTOMER: EASTERN BRIDGE LLC
 DRAWING TITLE: GIRDER 1G1A
 DRAWN BY: D.B. 10/22/03
 CHECKED BY: L.D. 11/14/03
 JOB NUMBER: 4065
 SHEET NUMBER: 1.2

NOTICE
 This drawing shall not be used or reproduced in any manner, nor shall any similar drawings or structures be made therefrom, nor shall the information thereon be used for any purpose other than that for which it is released without the written consent of an officer of EASTERN BRIDGE, LLC.

WORK WITH DRAWING 1.1