

NOTES:
 1- GENERAL NOTES: SEE DRAWING GN1
 2- HOLES : 15/16" (U.N.D.)

Reviewed
 Rejected
 Furnish as Corrected
 Revise and Resubmit
 Submit Specified Item


This review is only for general conformance with the design concept and the information shown on the Construction Documents. Contractor is advised that upon the shop drawings during site review do not release the contractor from responsibility with the requirements of the plans and specifications. Review of a shop drawing shall not be construed as an approval of the item or a warranty. The contractor is responsible for dimensions to be confirmed and verified at the project site. Information that pertains solely to the fabricator process or to the material used for construction, assembly and procedures of construction, coordination of the work shall be of all other trades and performing all work in a safe and satisfactory manner.

McFarland-Johnson, Inc.

Date: 12-17-03

By: RSW

RESERVED FOR STAMPS

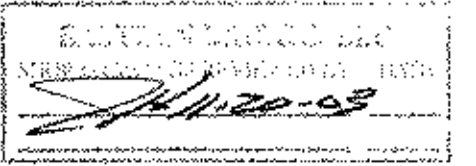

DRAWINGS PREPARED BY:
 AMEC E&C SERVICES LTD, 4765 1ST AVENUE, SUITE 120, CHARLESBOURG (QUEBEC), CANADA G1H 2T3 #030731-EAS

| REV | DATE | DESCRIPTION | QTY | DATE | ISSUED TO | FOR |
|-----|----------|------------------------------------|-----|------|-----------|----------|
| 8 | 11/17/03 | FRANK W. WHITCOMB CONSTRUCTION CO. | | | | APPROVAL |

NOTICE
 This drawing shall not be used or reproduced in any manner, nor shall any similar drawings or structures be made therefrom, nor shall the information thereon be used for any purpose other than that for which it is released without the written consent of an officer of EASTERN BRIDGE LLC.

WORK WITH DRAWING 6.1

EASTERN BRIDGE LLC
 RURAL RTE 2, BOX 302
 CLAREMONT, NH 03743
 603-542-5202

PROJECT: BRIDGE #12 VT 103-TH OVER WILLIAMS RIVER
 LOCATION: CHESTER, VERMONT
 ENGINEER: MCFARLAND-JOHNSON, INC.
 CUSTOMER: EASTERN BRIDGE LLC
 DRAWING TITLE: GIRDER 606A
 DRAWN BY: D.B. 10/29/03
 CHECKED BY: L.D. 11/14/03
 JOB NUMBER: 4065
 SHEET NUMBER: 6.2