


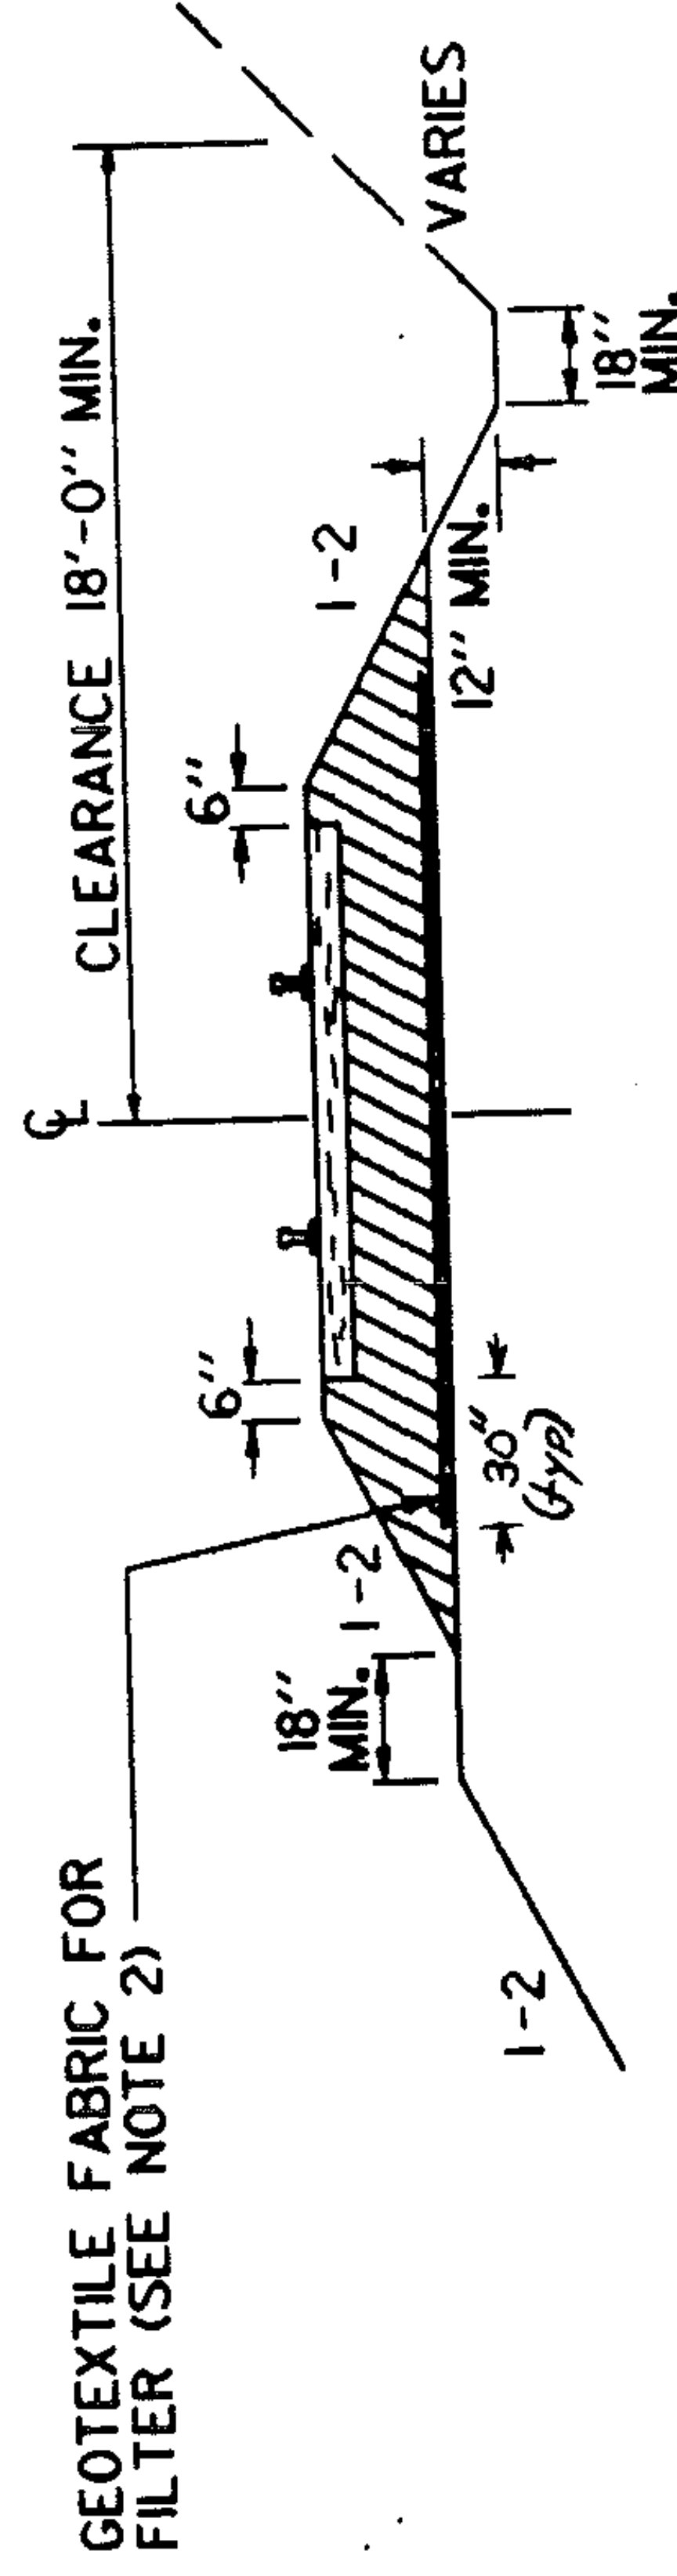

TYPICAL FOR RAILROAD APPROACH AREA CROSS SECTION OF RAILROAD CROSSING ALONG TRACKS