


*NOTES ARE FOUND ON PLAN SHEET 7E.

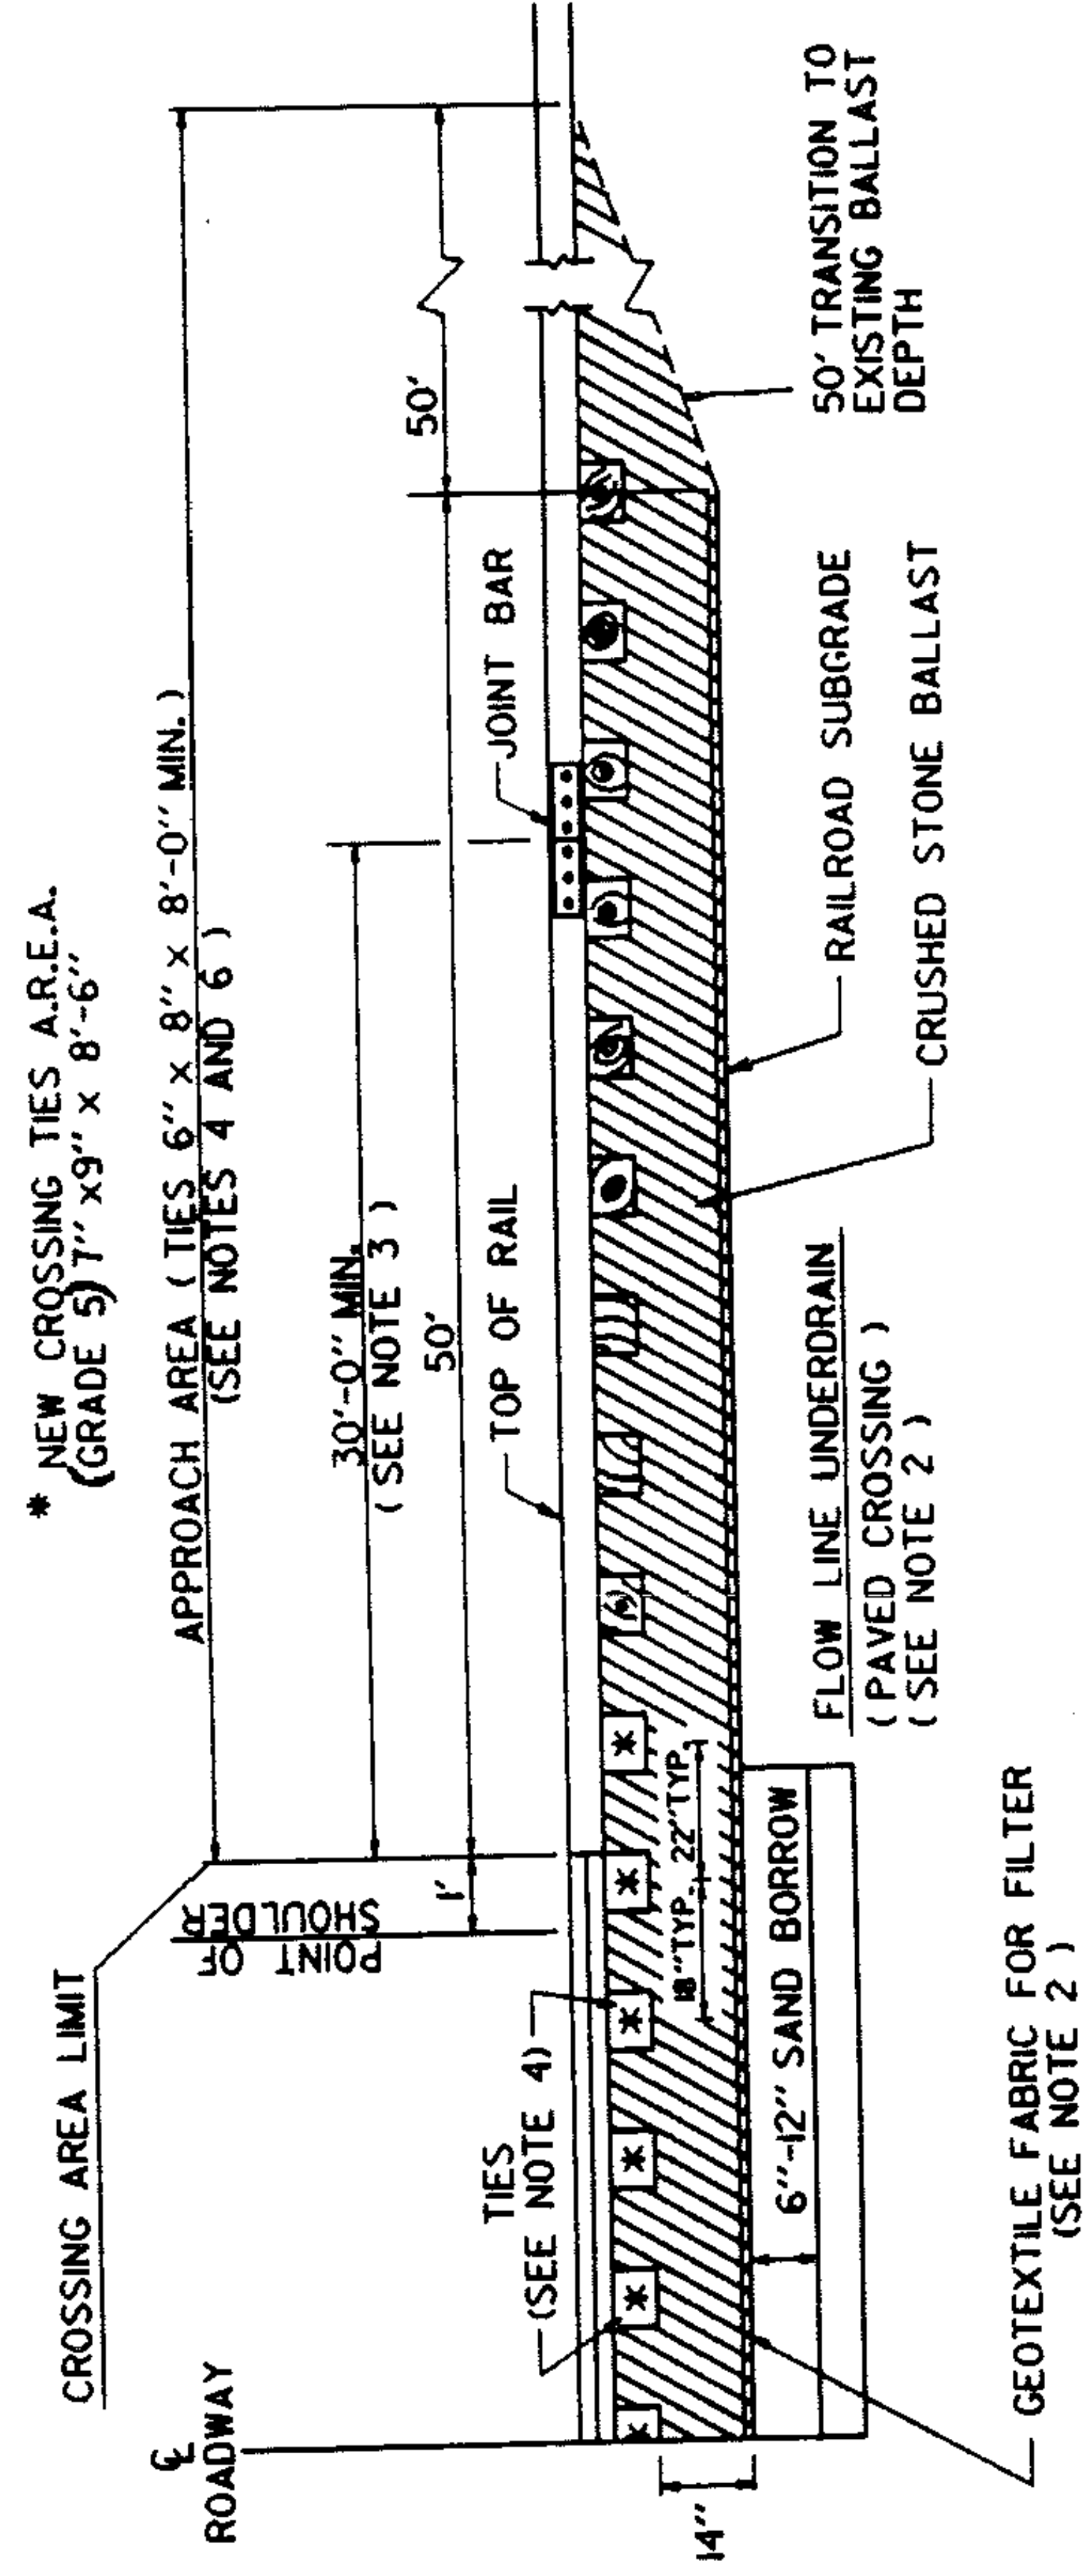

PROFILE OF RAILROAD CROSSING ALONG TRACKS

CAVENDISH

F 025-1 (32) S

SHEET 78 OF 33 SHEETS