



PAVING LIMITS FOR TOWN ROADS & DRIVES

PAVING LIMITS FOR TOWN ROADS

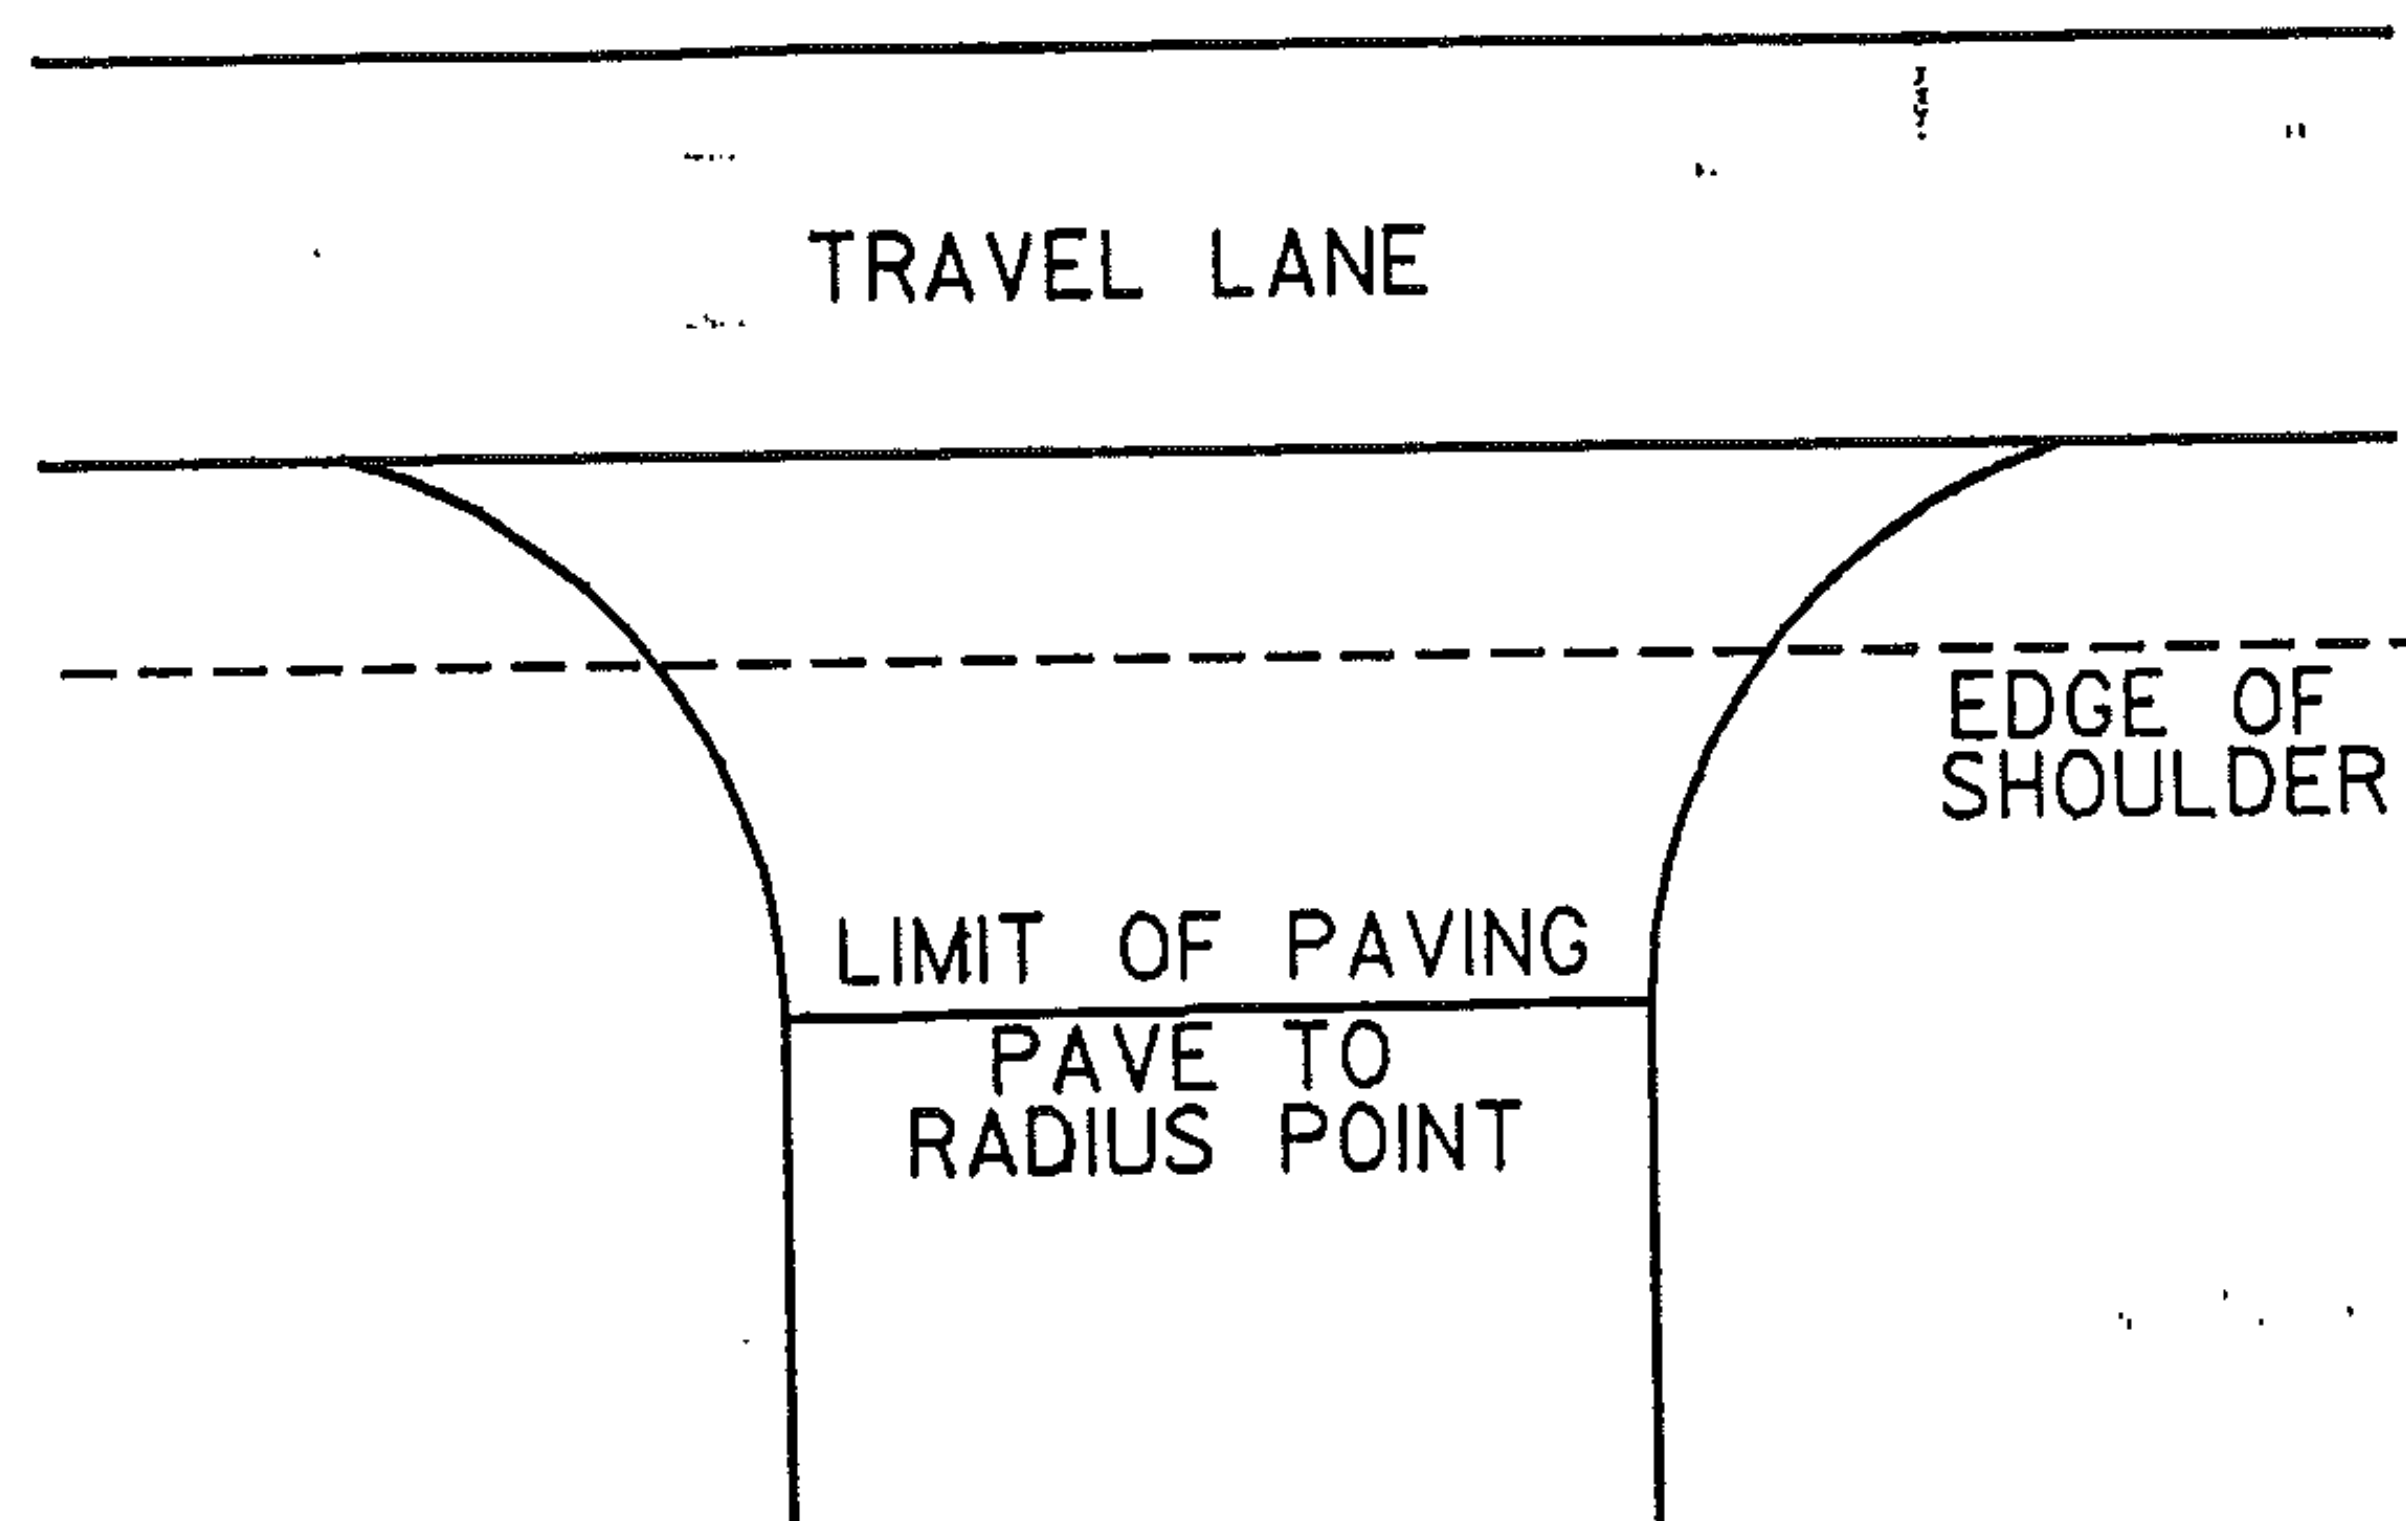

PAVING LIMITS FOR DRIVES

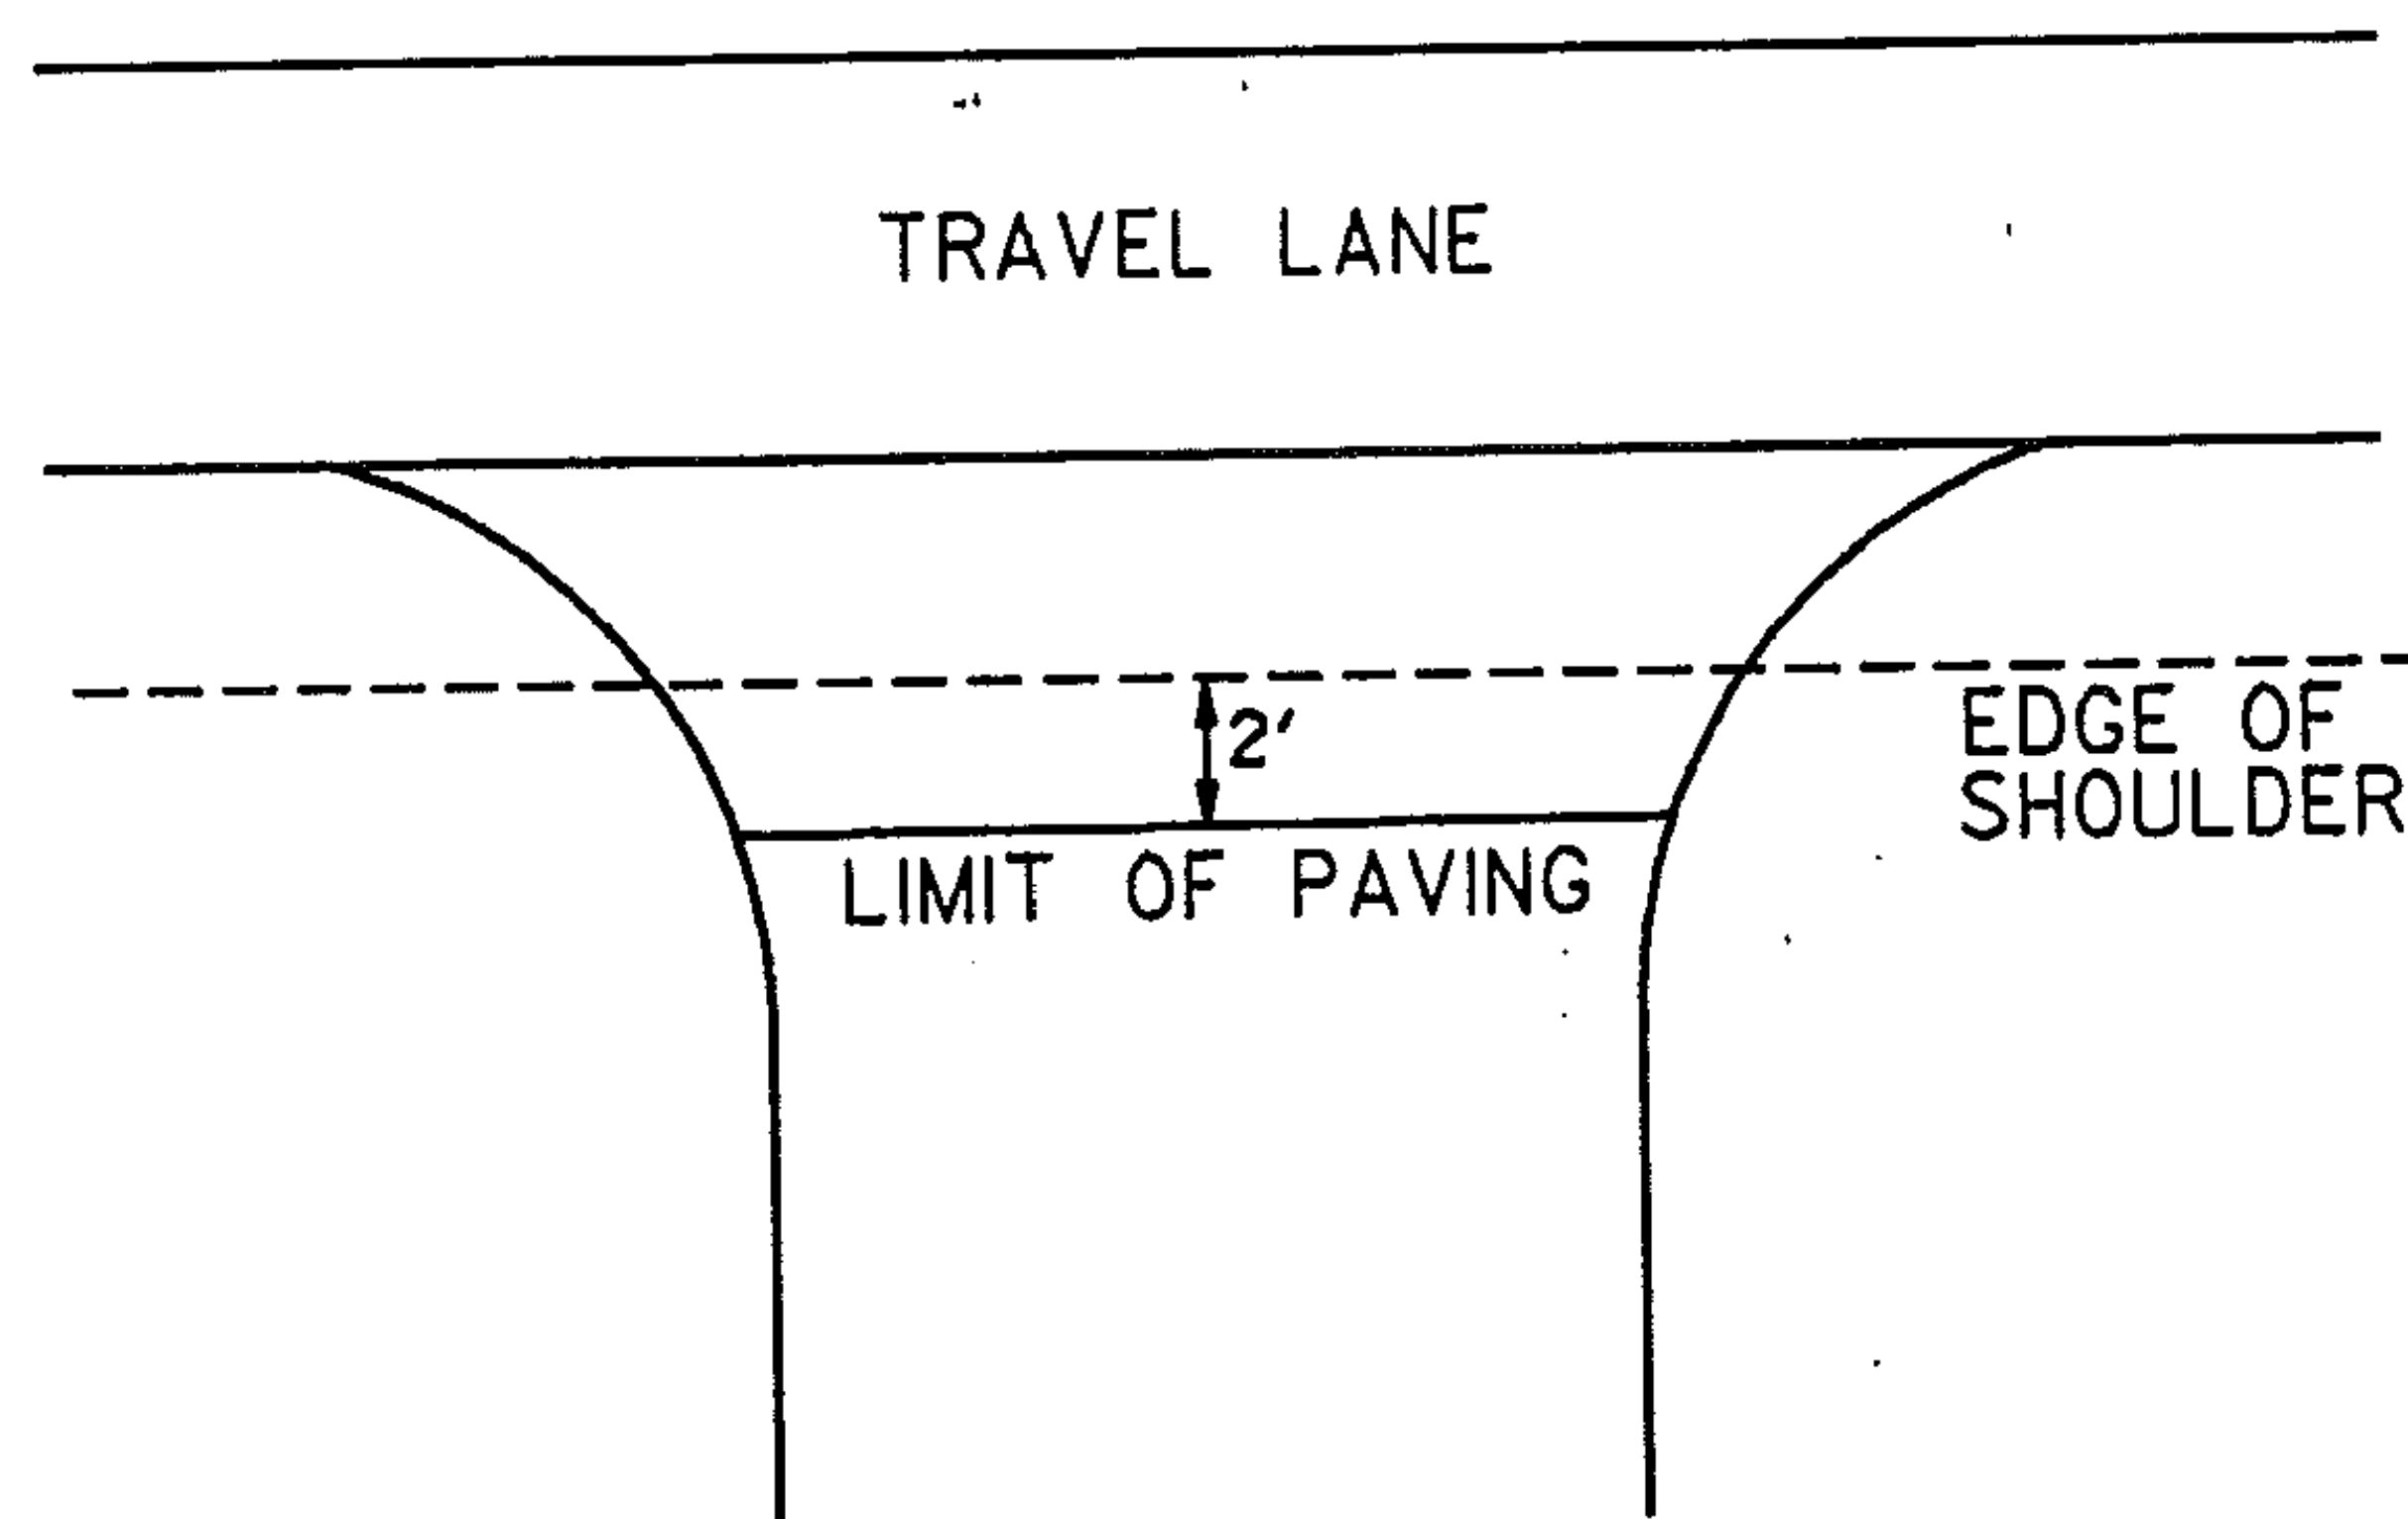

PROJECT CAVENDISH

NO. F025-1(32)S

SHEET 8 OF 33 SHEETS