


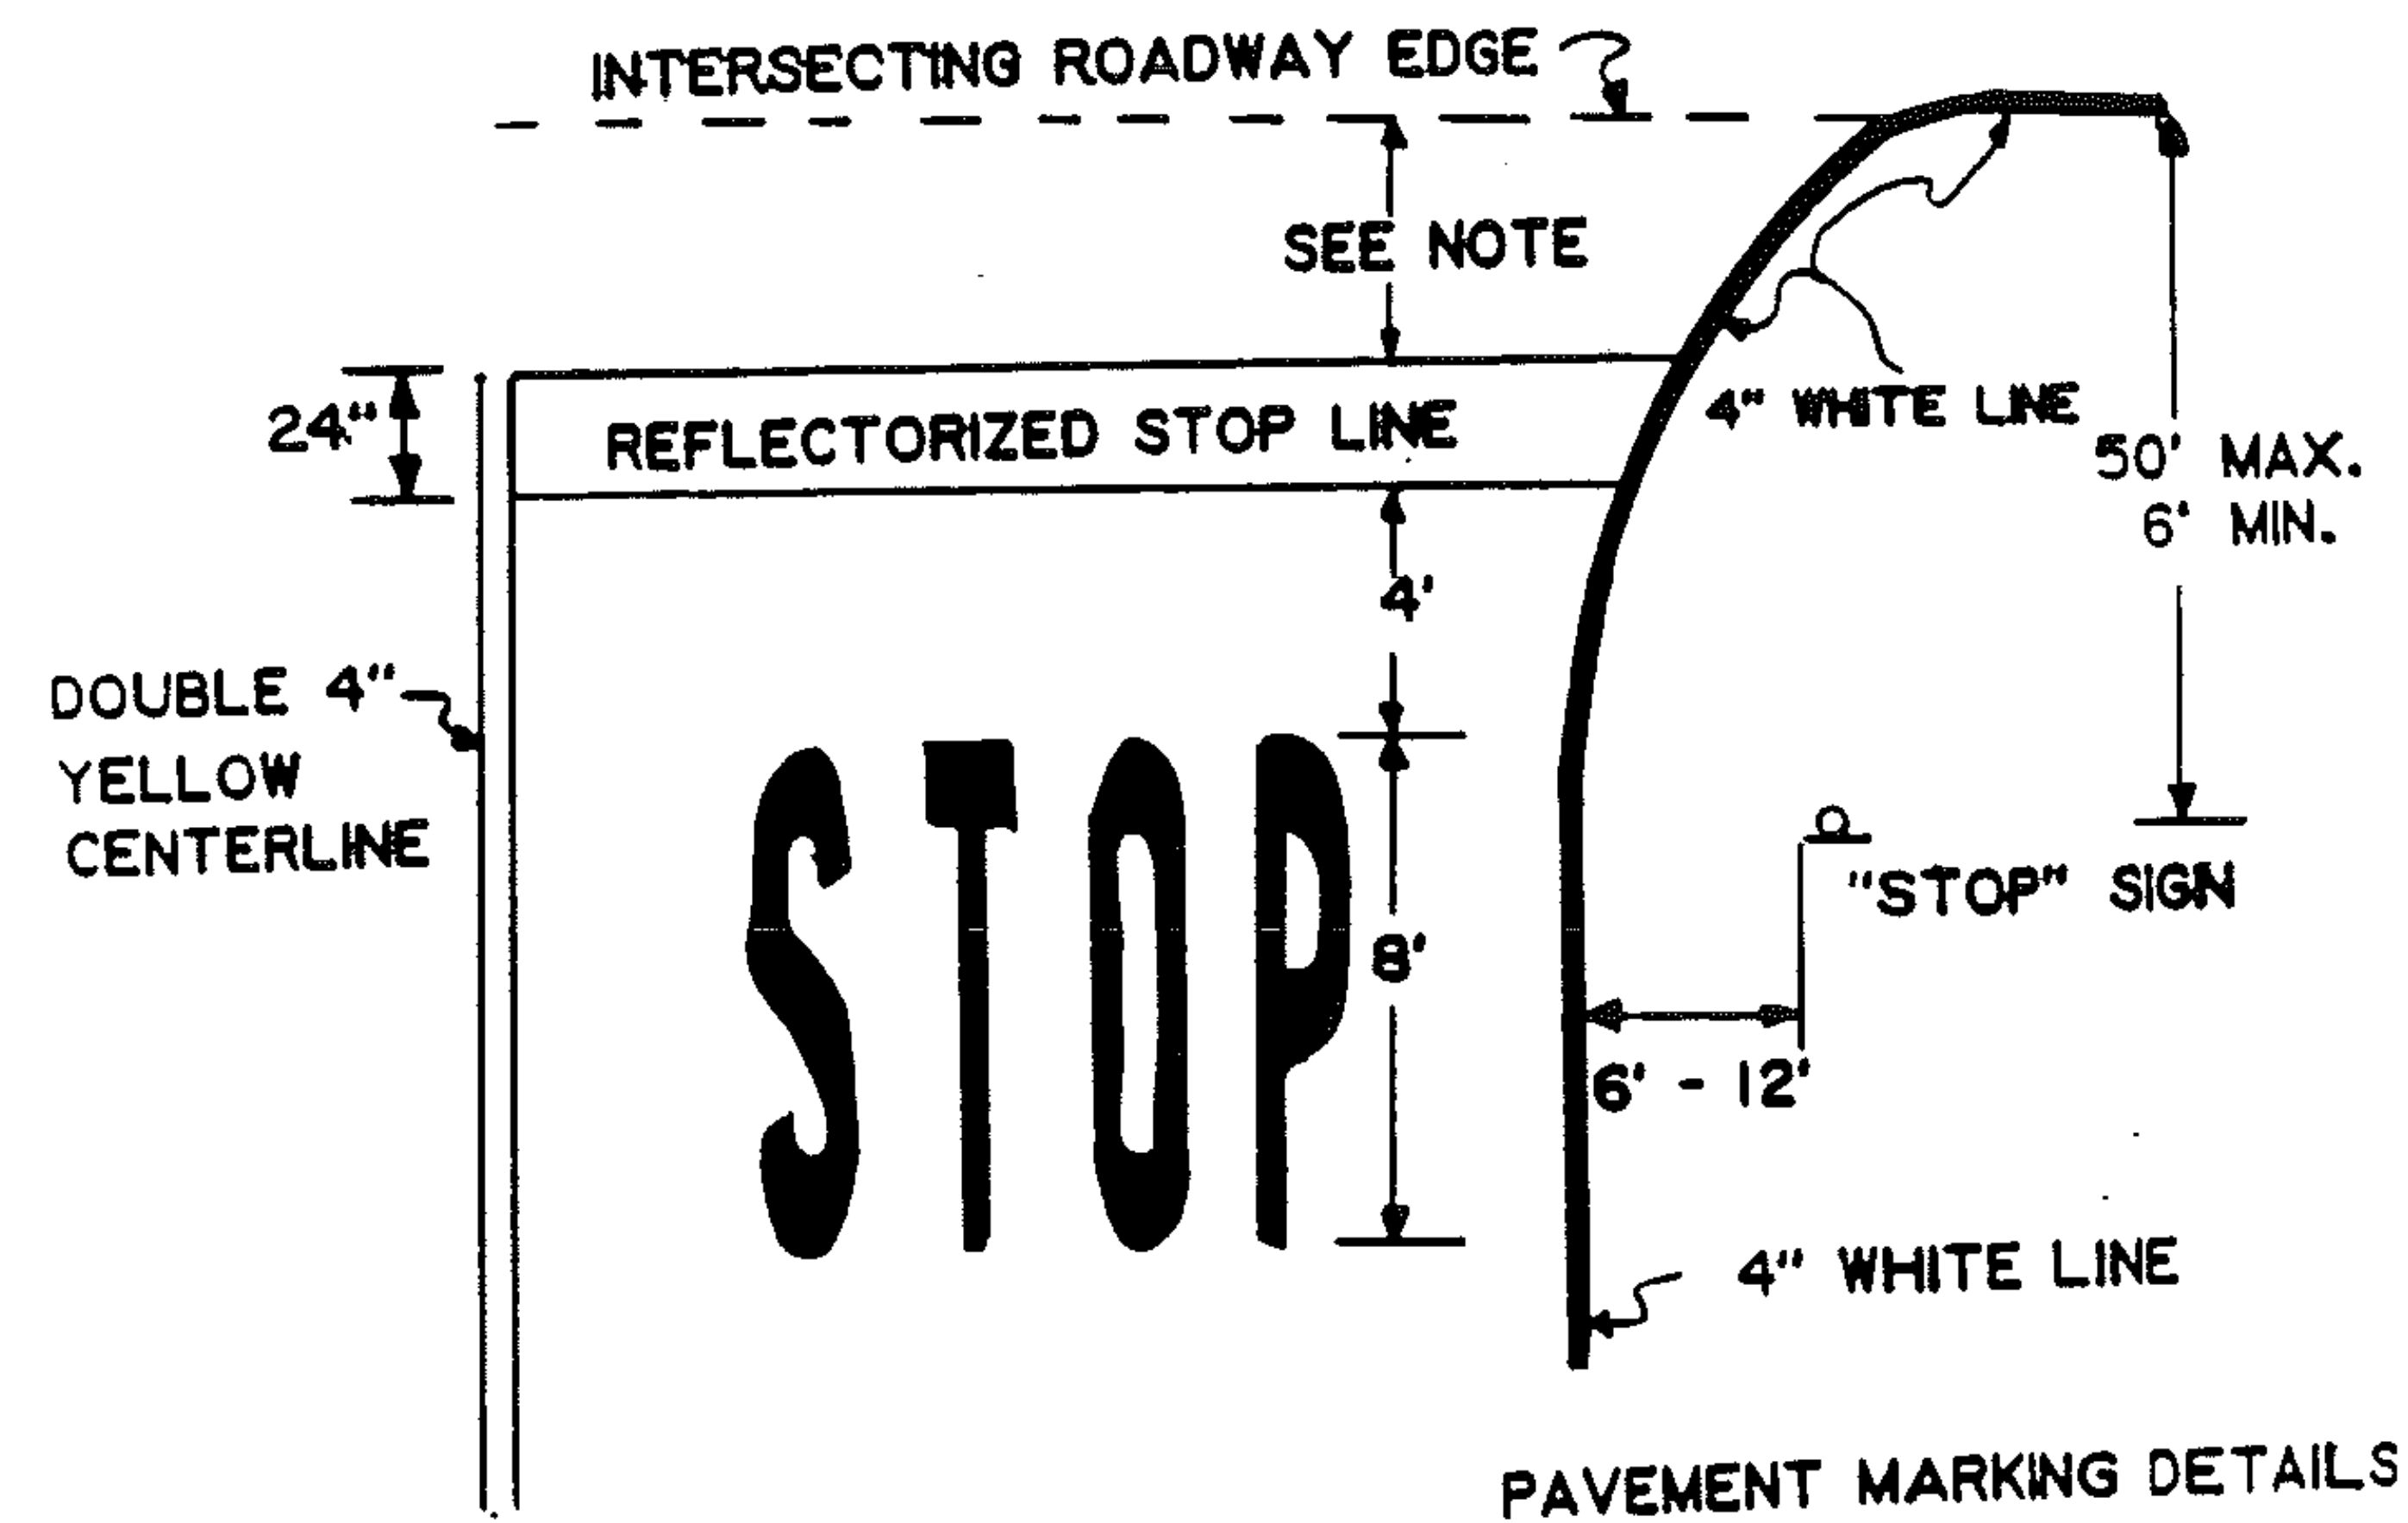

NOTE:

The "desired stopping point" is the location based on site conditions that best allows the stopped vehicle to view the approaching traffic, in no case more than 30 feet or less than 4 feet from the nearest edge of the intersecting roadway.

NOT TO SCALE

STOP BAR APPROACH DETAILS

SHEET 10 OF 33 SHEETS