


GORE MARKING DETAIL
NOT TO SCALE

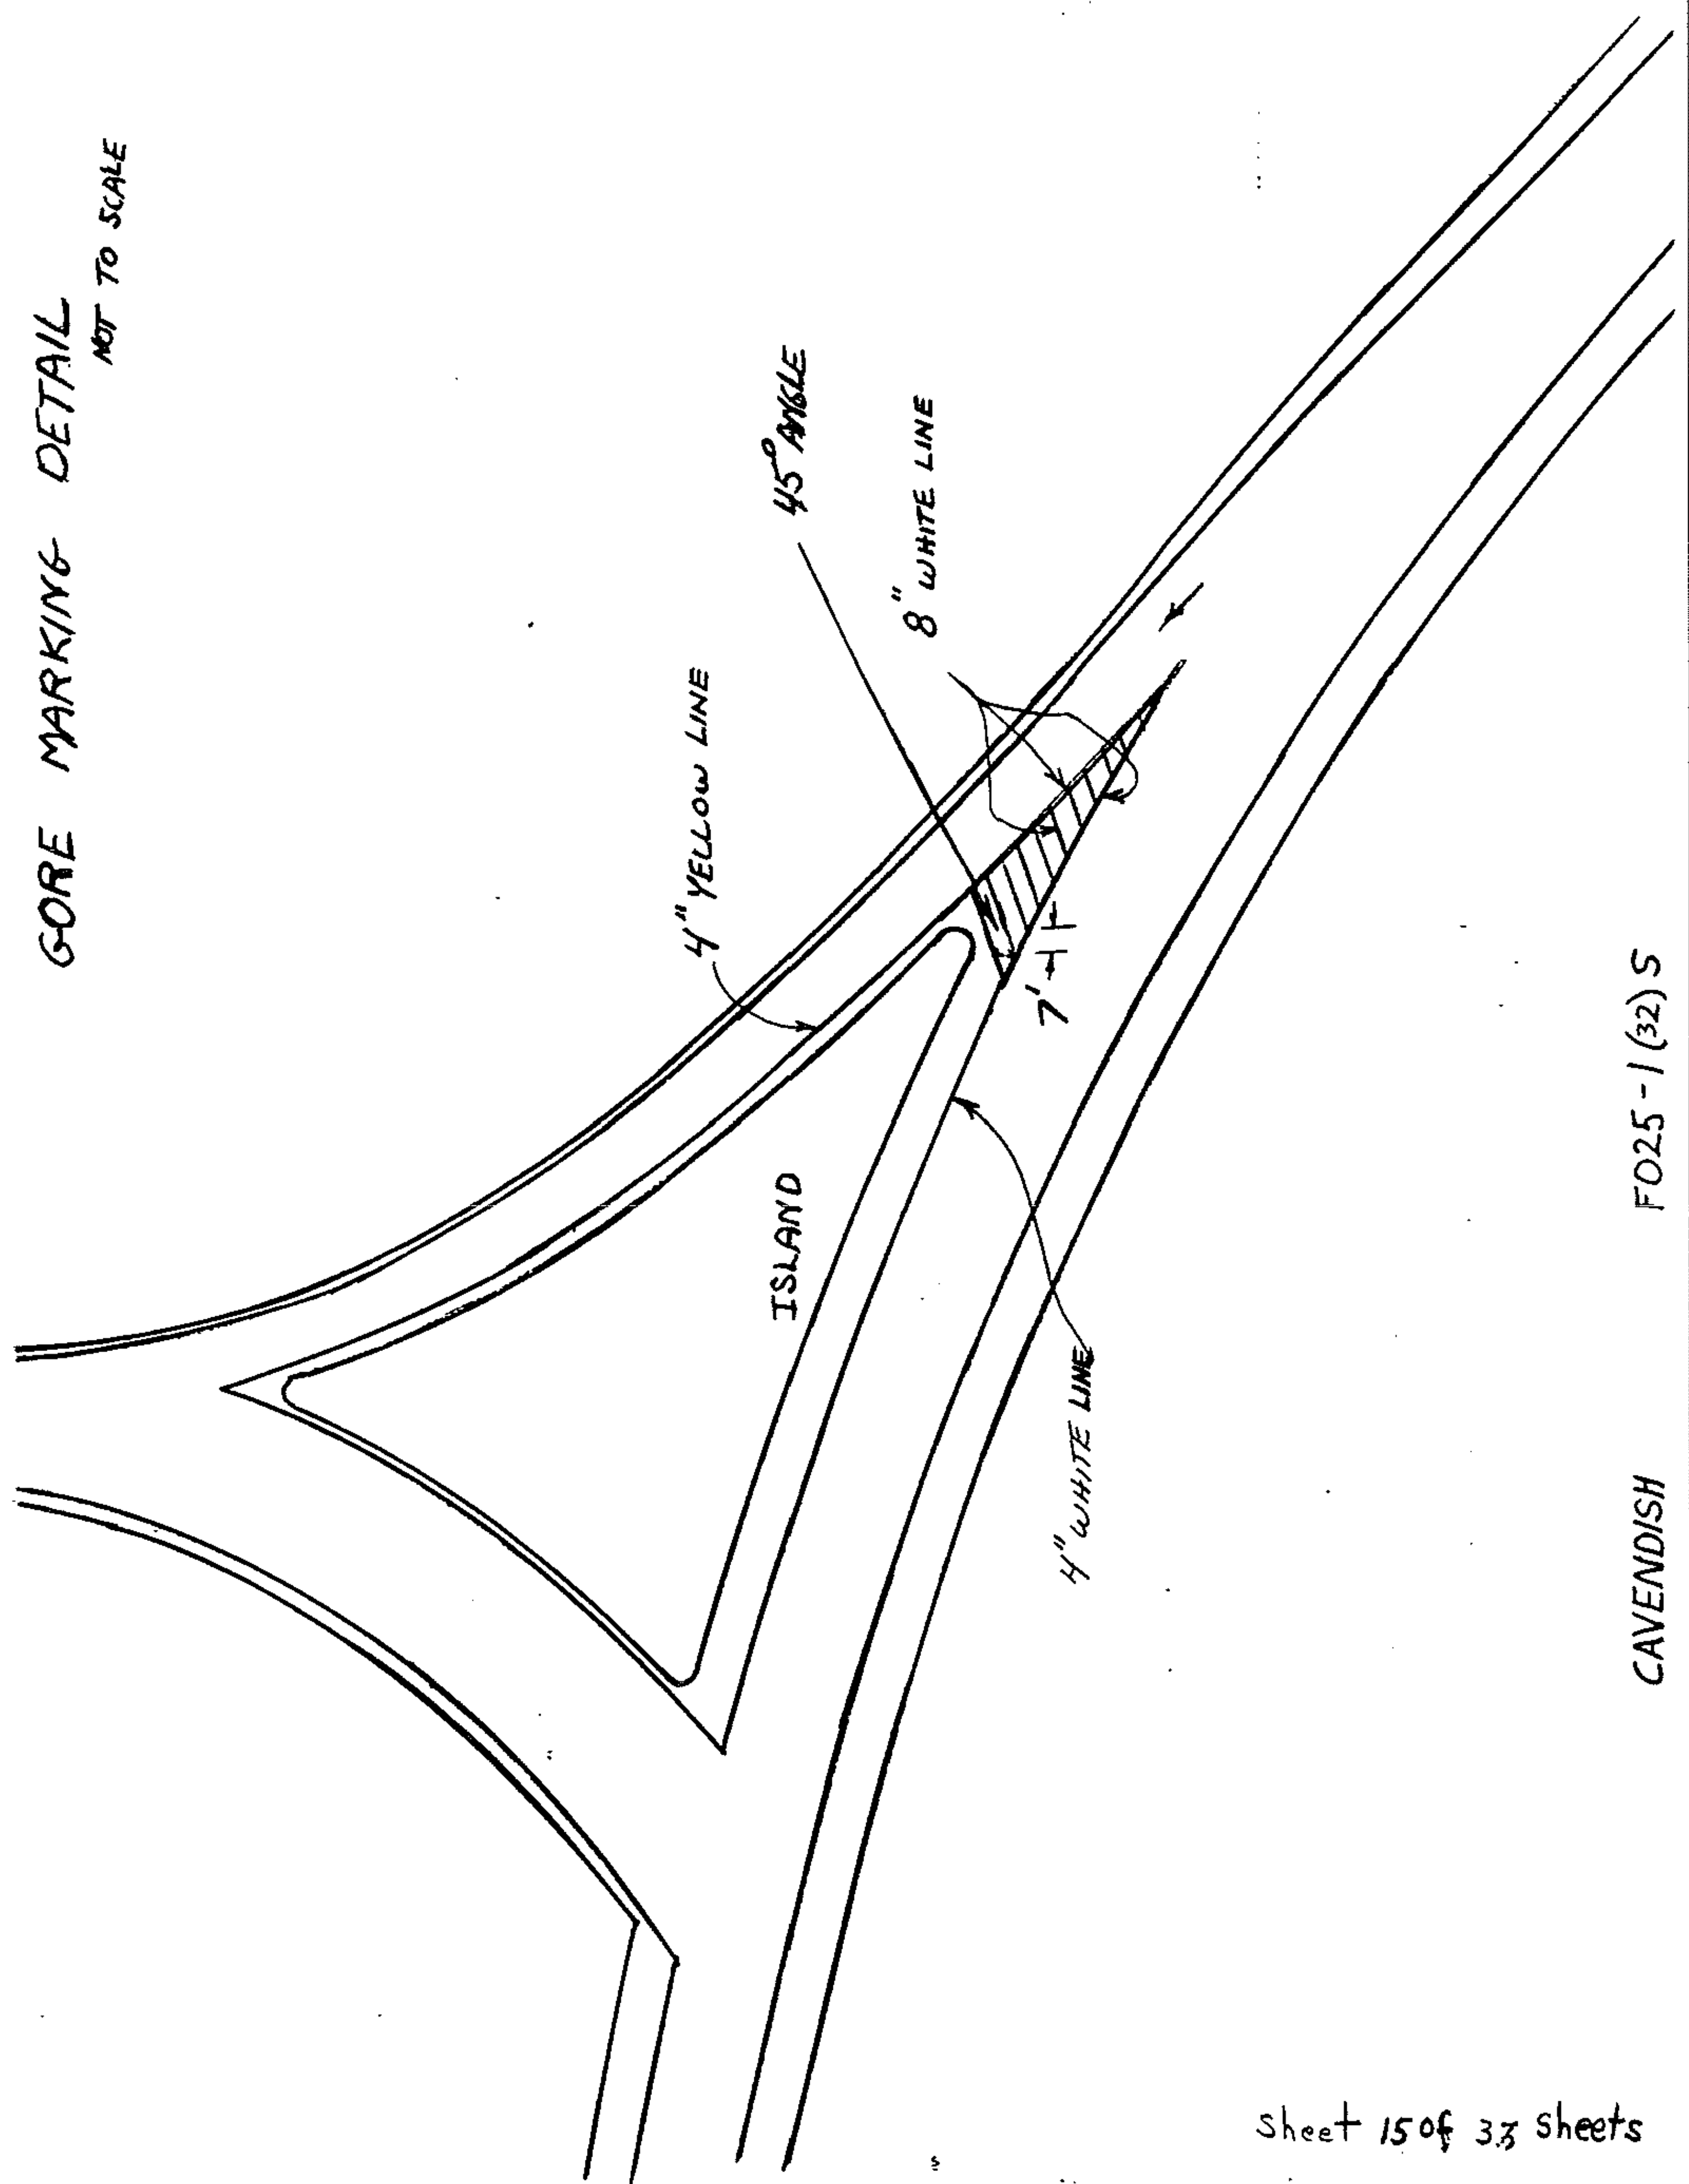

CAVENDISH FO25-1(32)S