
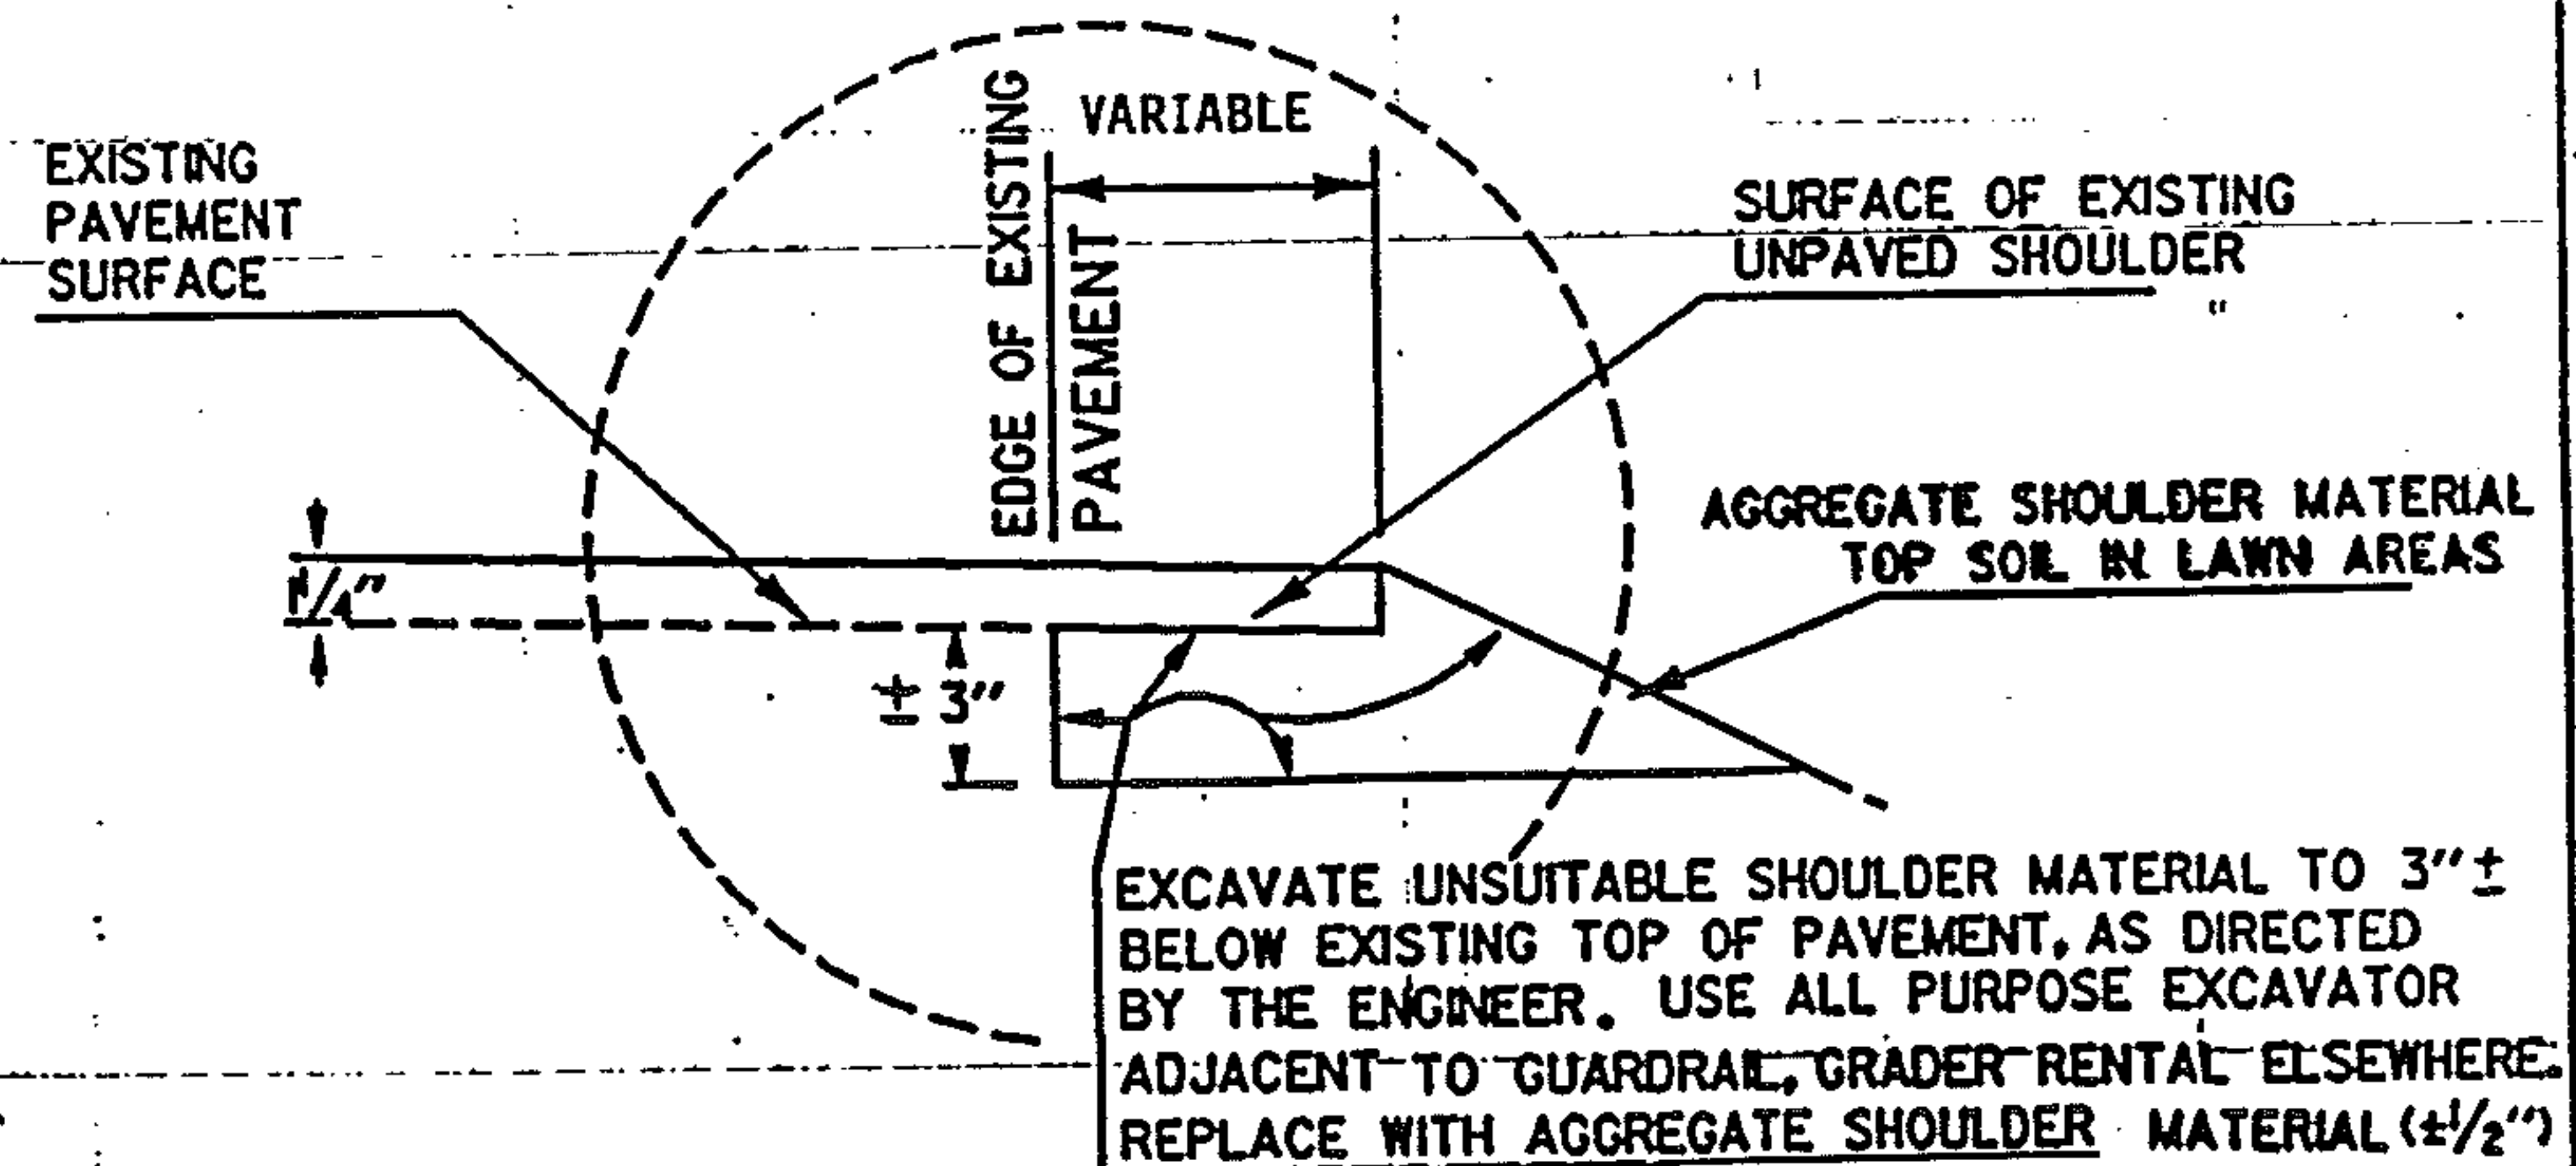


TYPICAL SECTIONS & DESIGN DATA

ITEM 406.25 BITUMINOUS CONCRETE PAVEMENT
 1 1/4" SHOULDERS TYPE III ($\pm 1/4"$)
 LEVELING COURSE TYPE IV (450 TONS/MILE)
 1 1/4" WEARING COURSE TYPE III ($\pm 1/4"$)
 AS DIRECTED BY THE ENGINEER

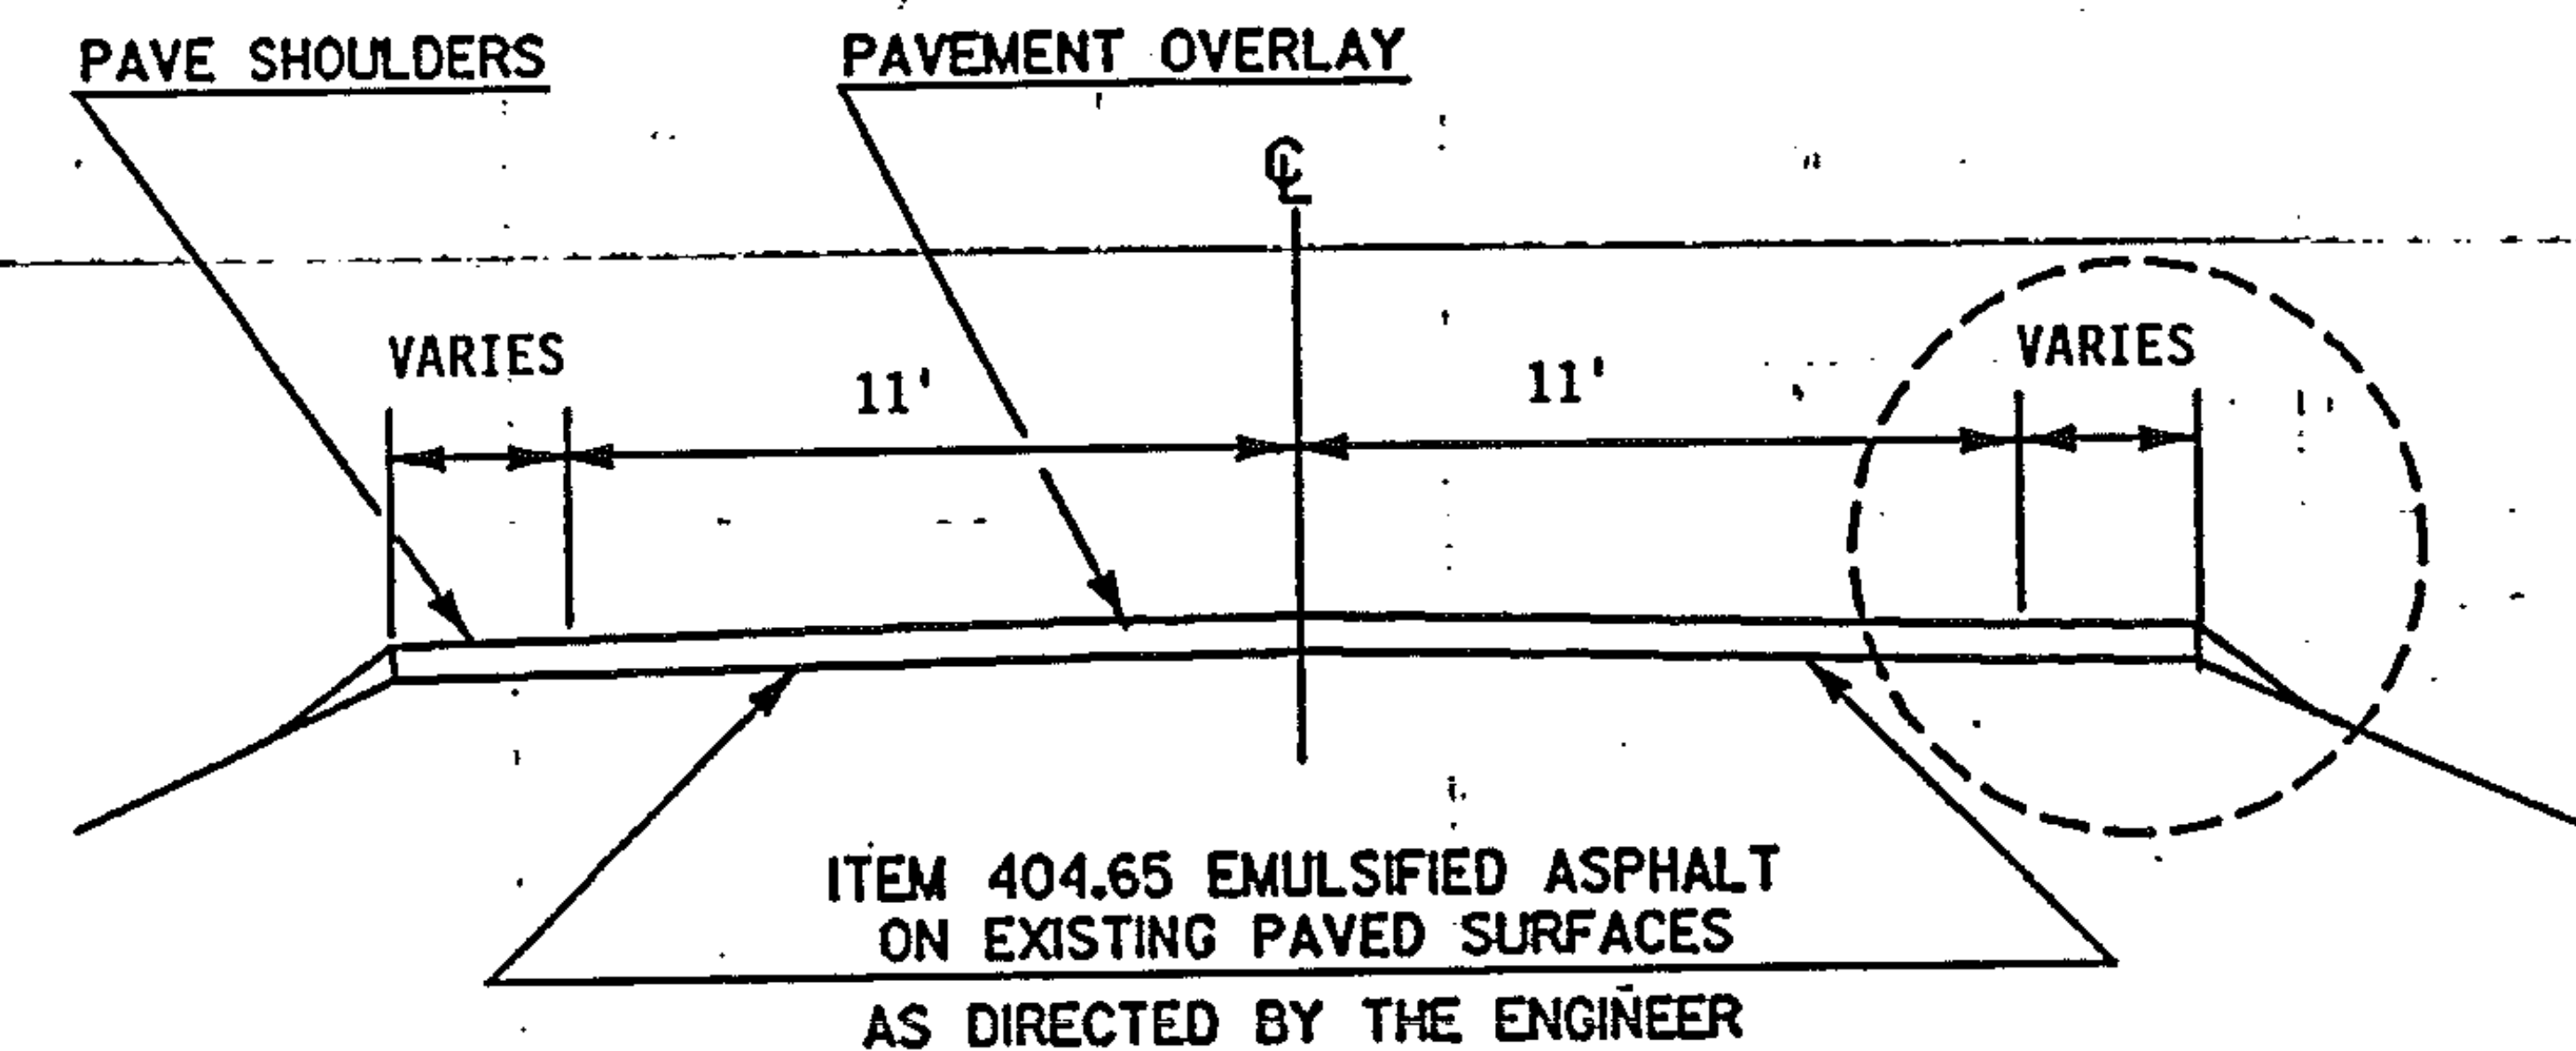

PROJECT WEATHERSFIELD

NO. HMA 2931

SHEET 23 OF 32 SHEETS