



PAVING LIMITS FOR TOWN ROADS & DRIVES

PAVING LIMITS FOR TOWN ROADS

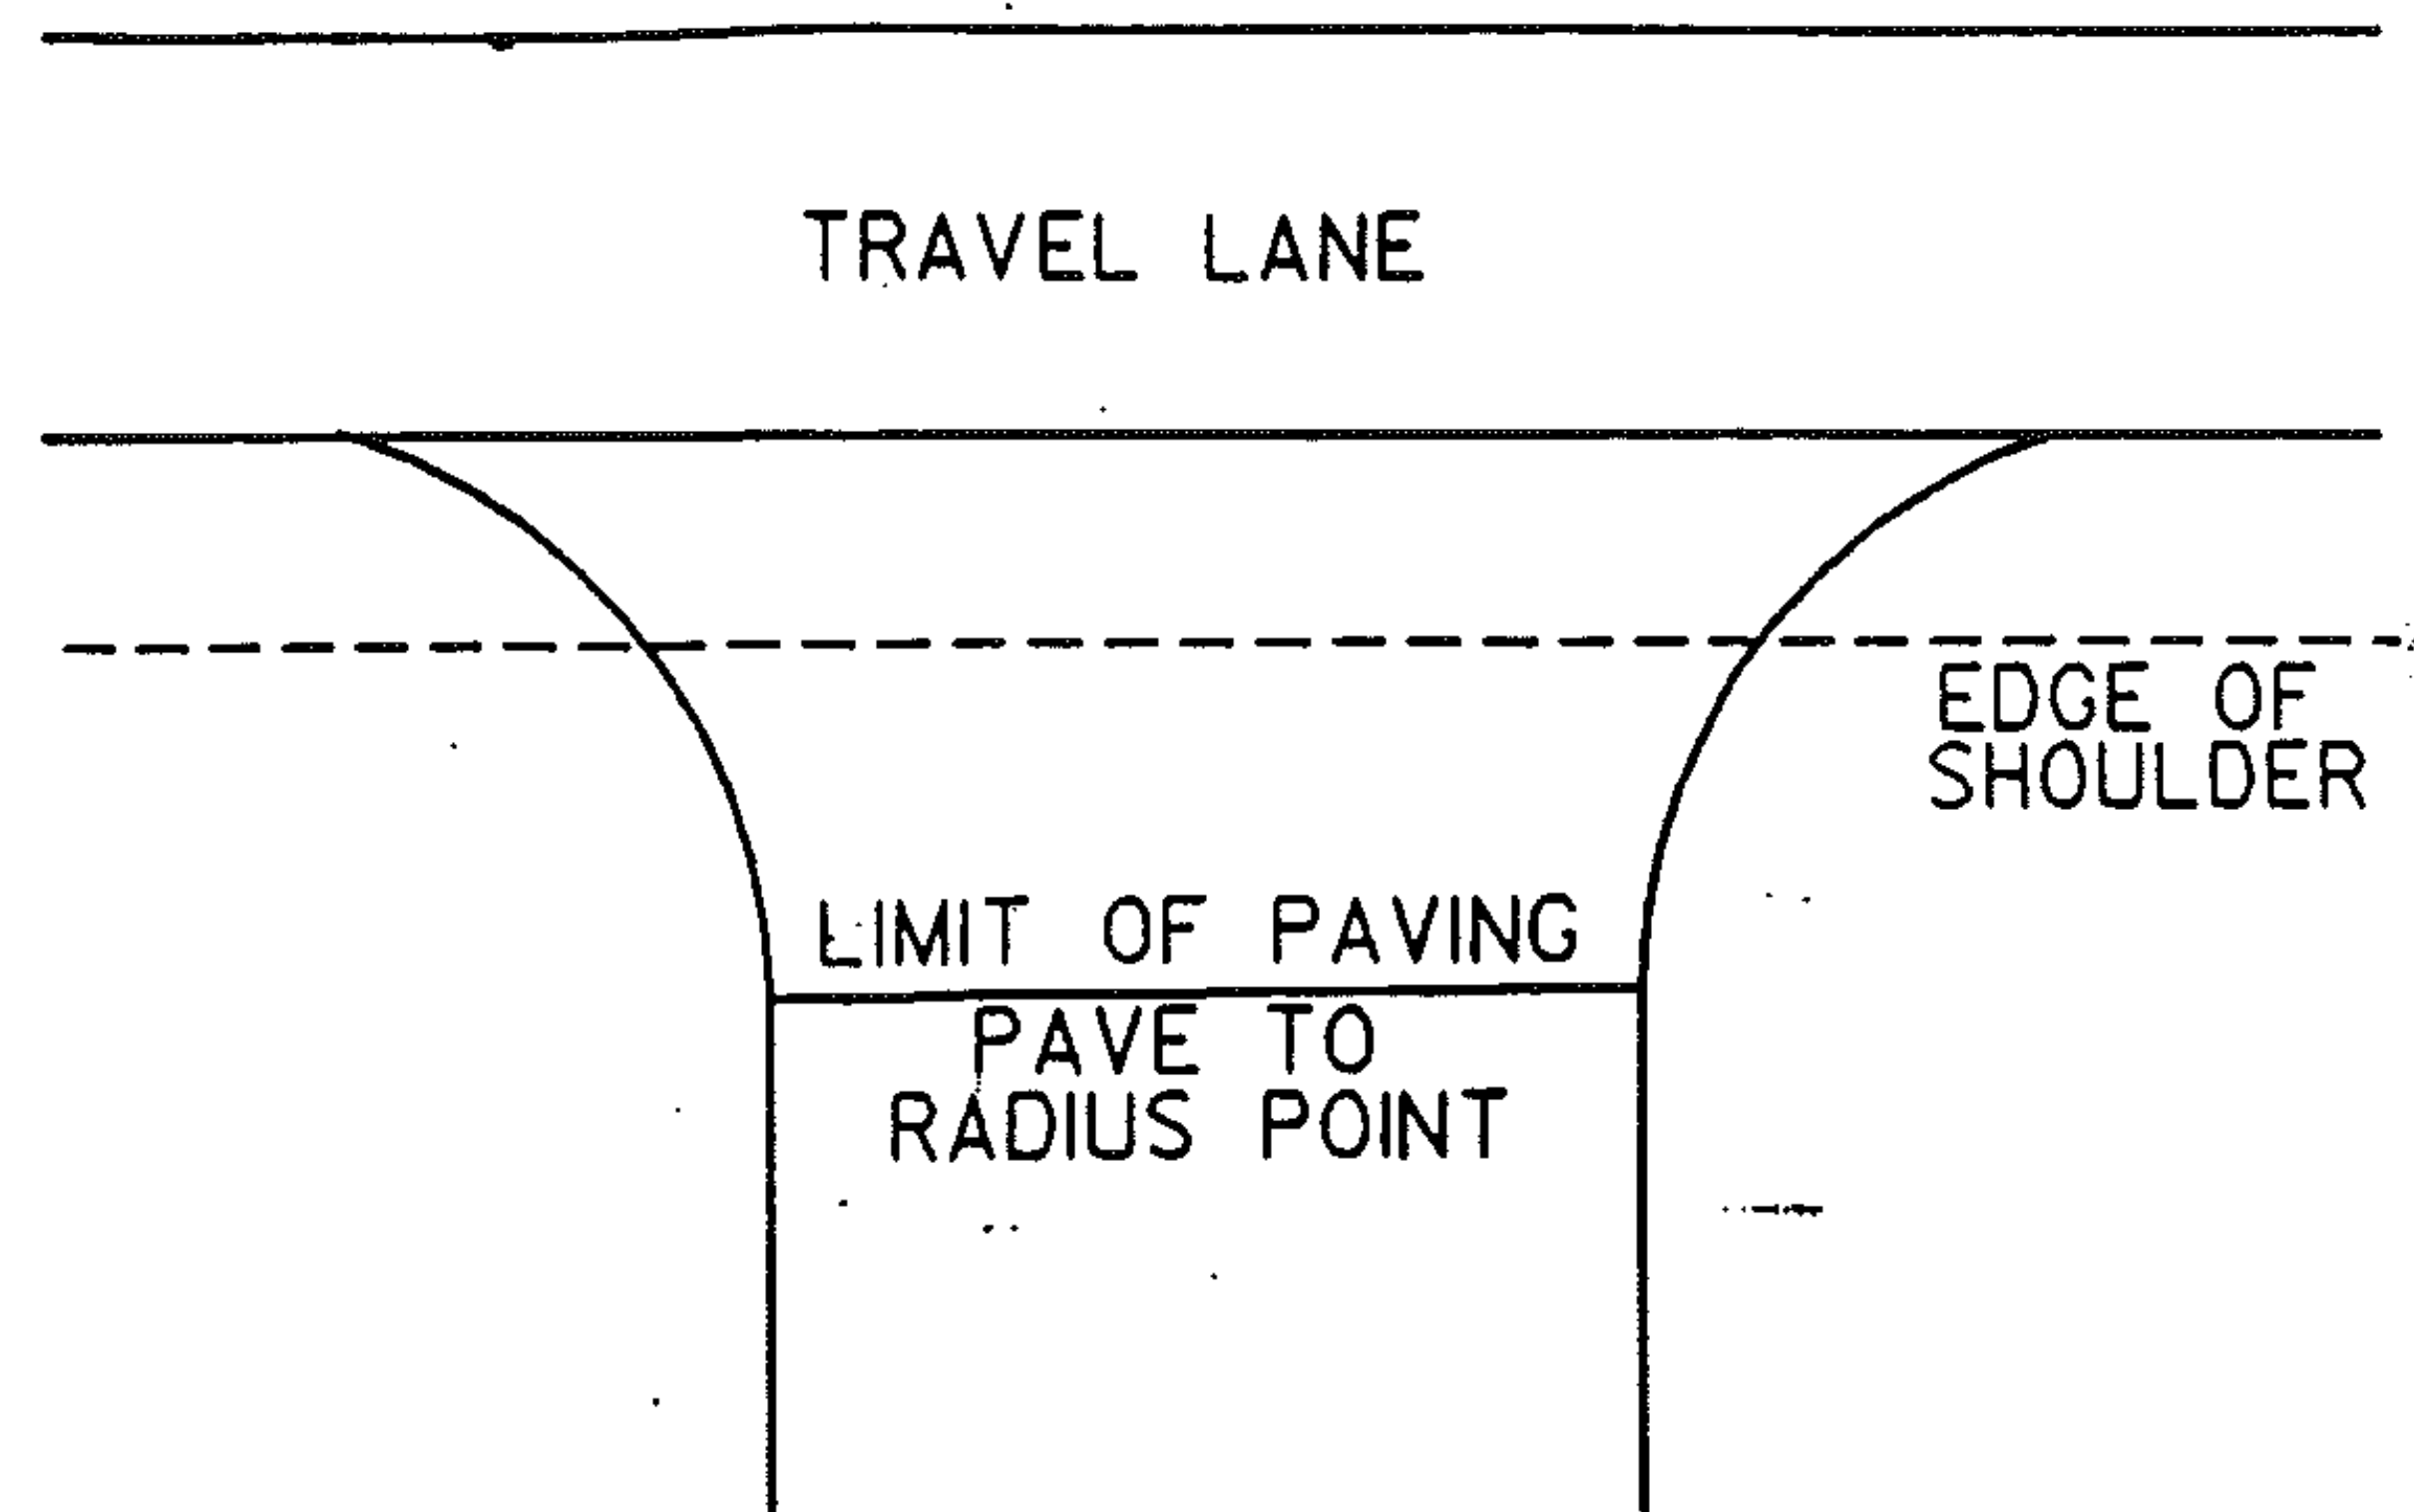

PAVING LIMITS FOR DRIVES

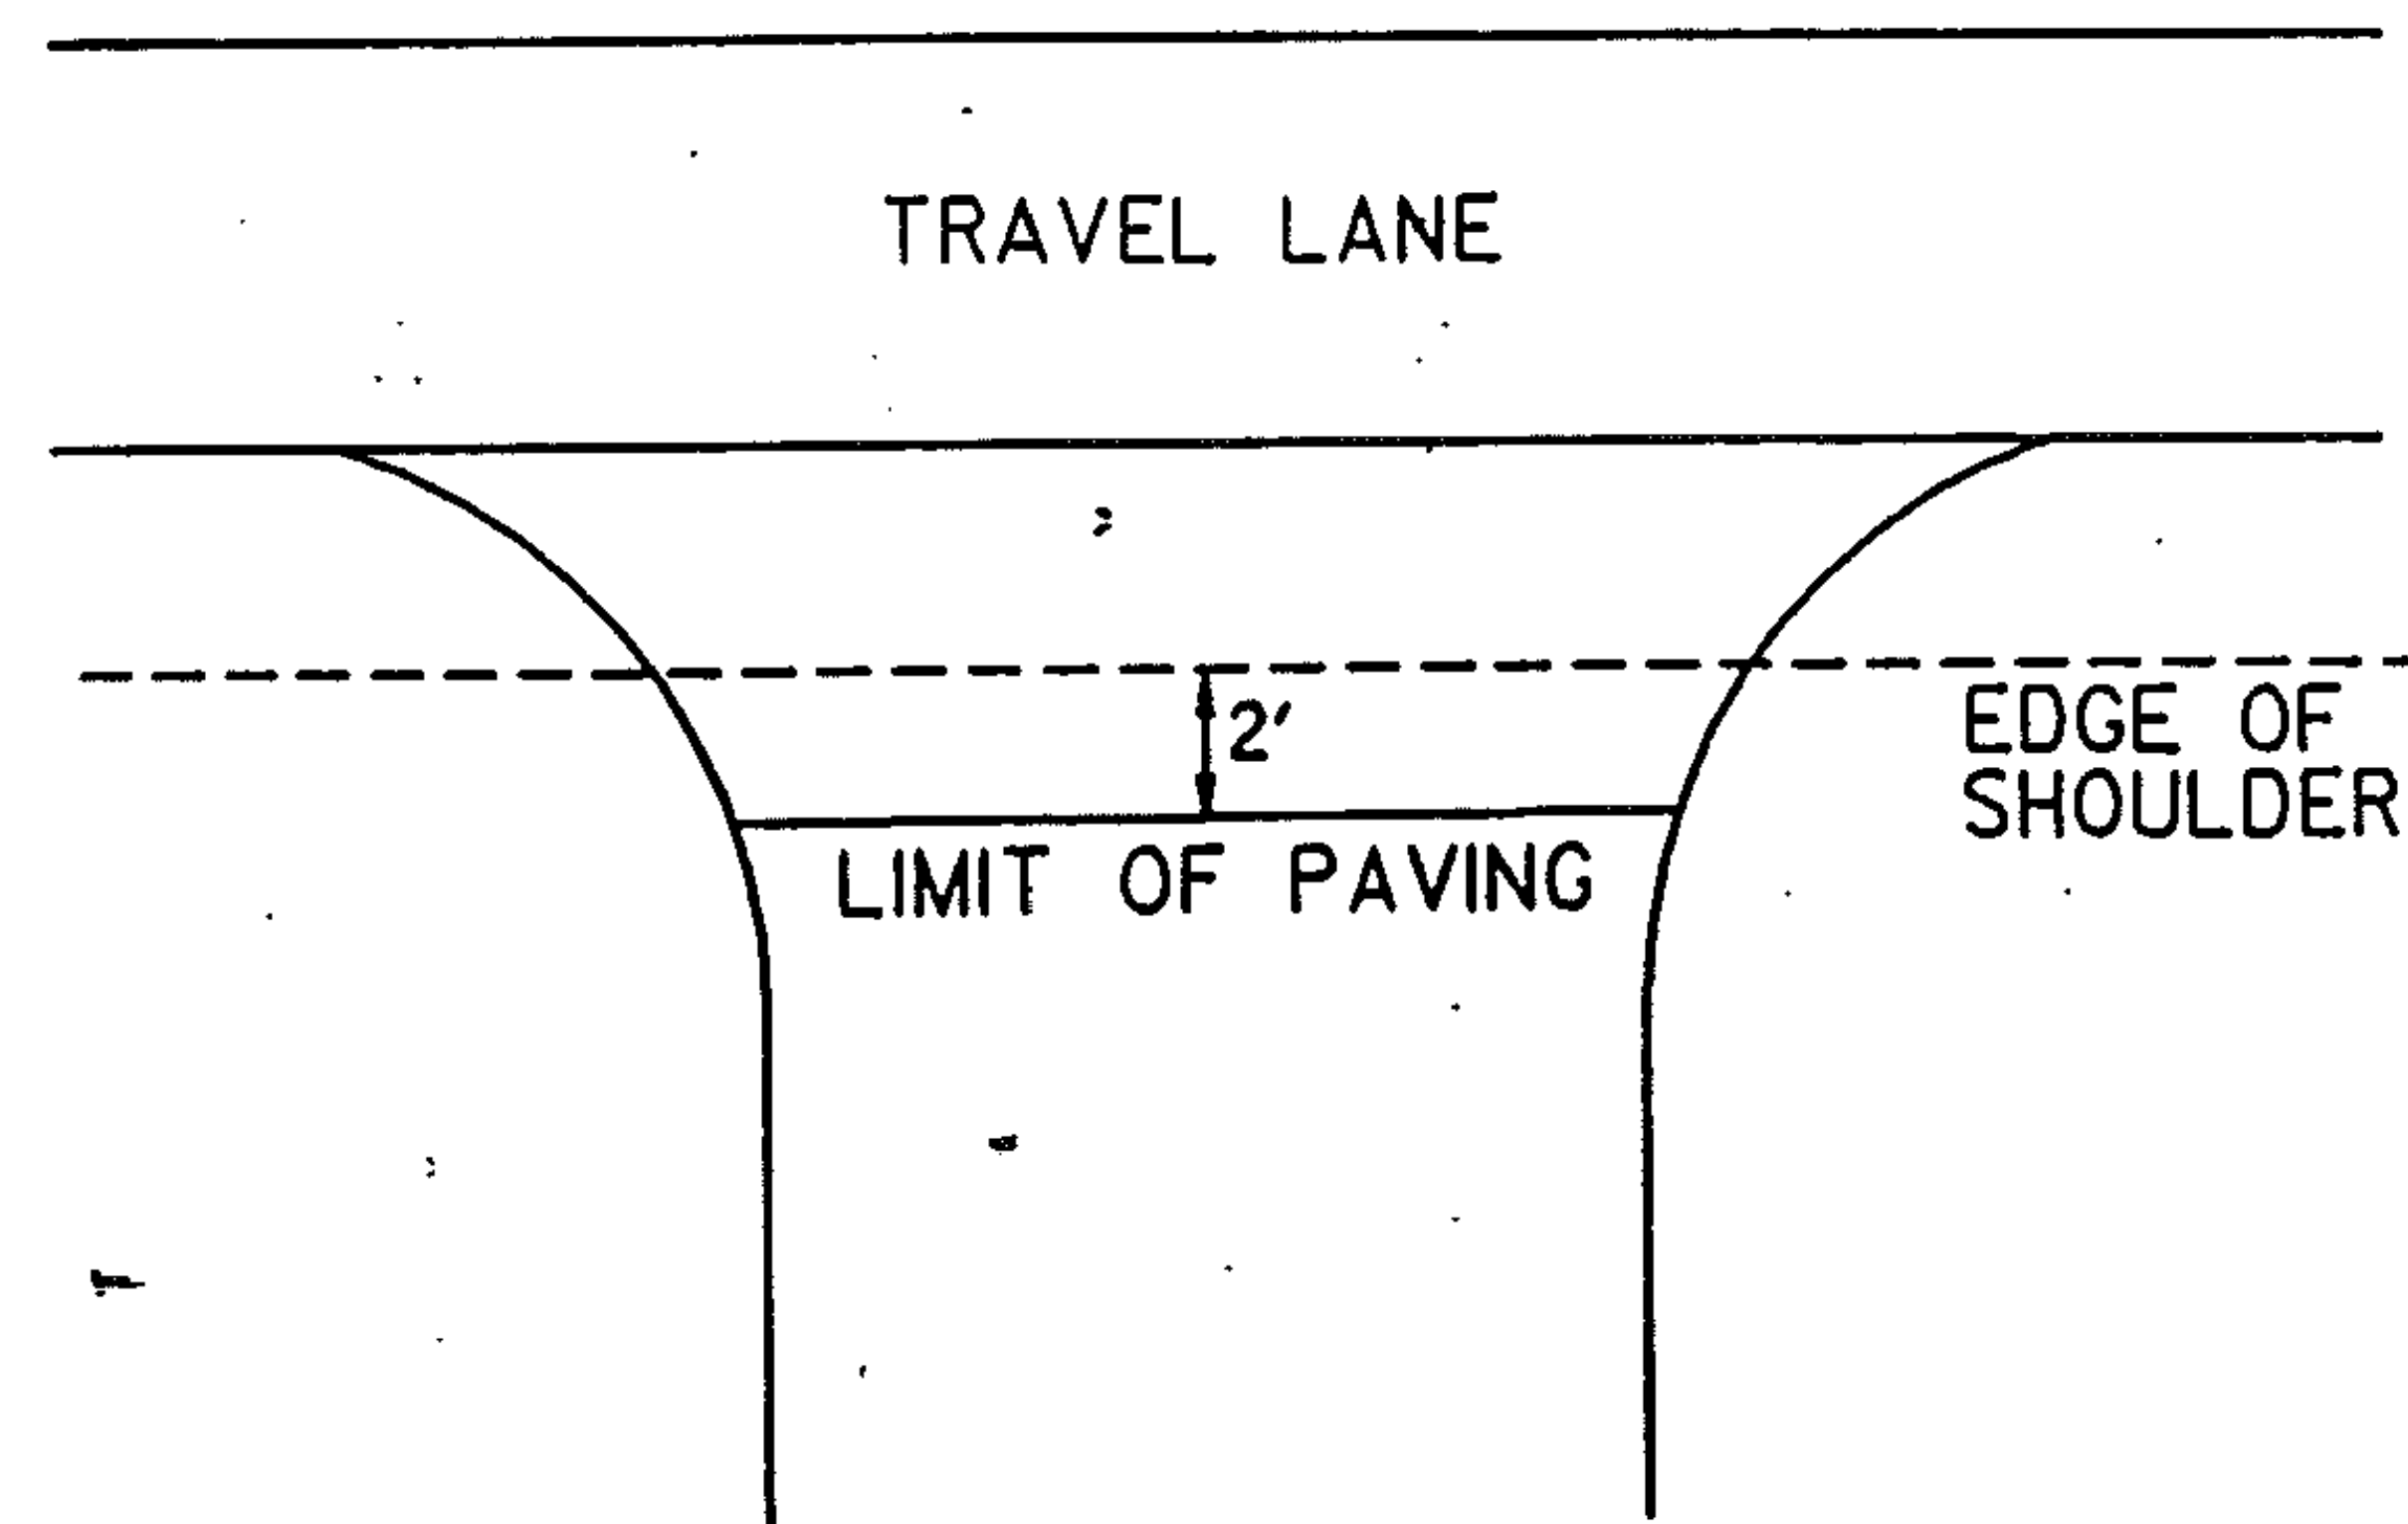

PROJECT WEATHERSFIELD

NO. HMA 2931

SHEET 24 OF 33 SHEETS