


CHKD. BY: _____ DATE: _____ **MARKING AT INTERSECTING** JOB NO. _____
SIDE ROAD

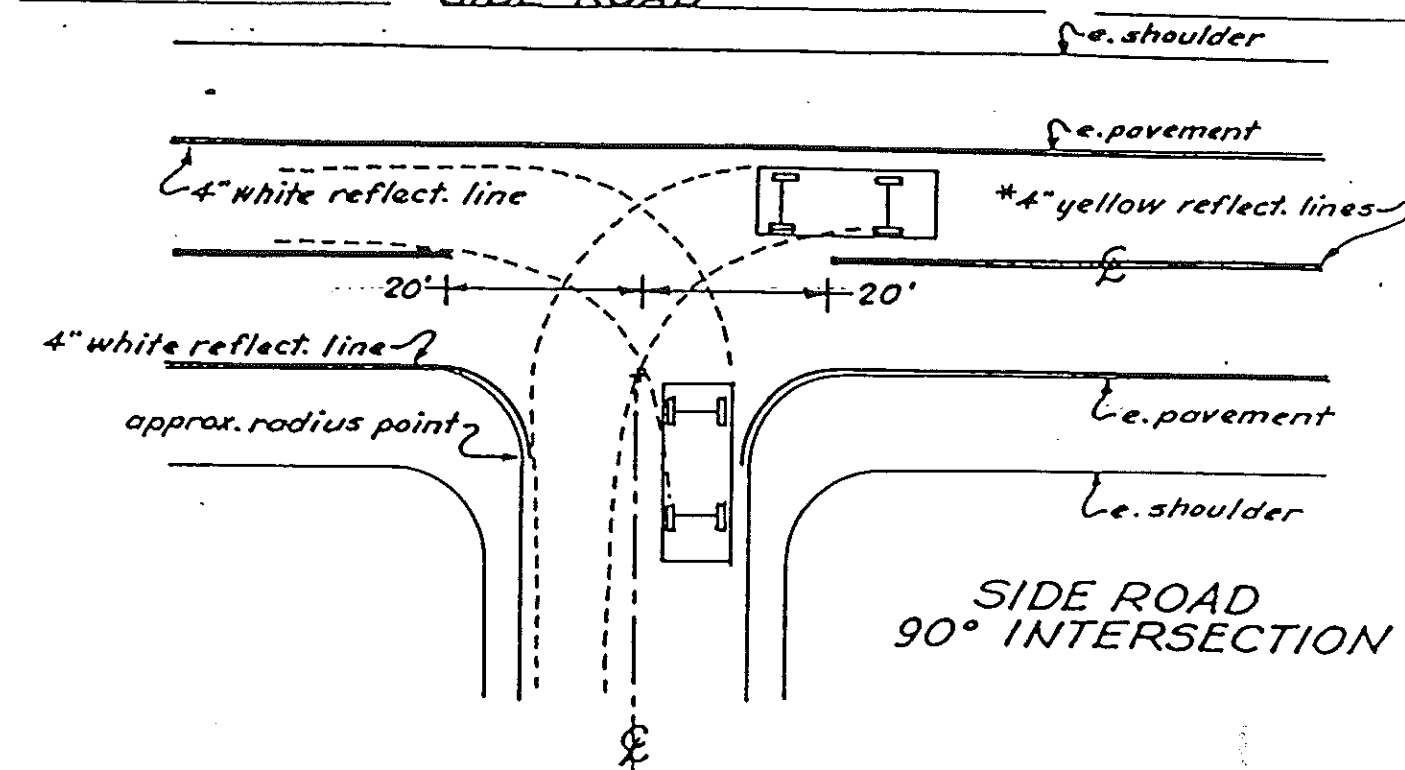

* Centerline treatment shall consist of a minimum of 400 feet of solid line in advance of the intersection and shall be paired with either a solid or dashed line depending on sight distance availability in the opposing lane.

