


PROJECT DESCRIPTION AND LOCATION

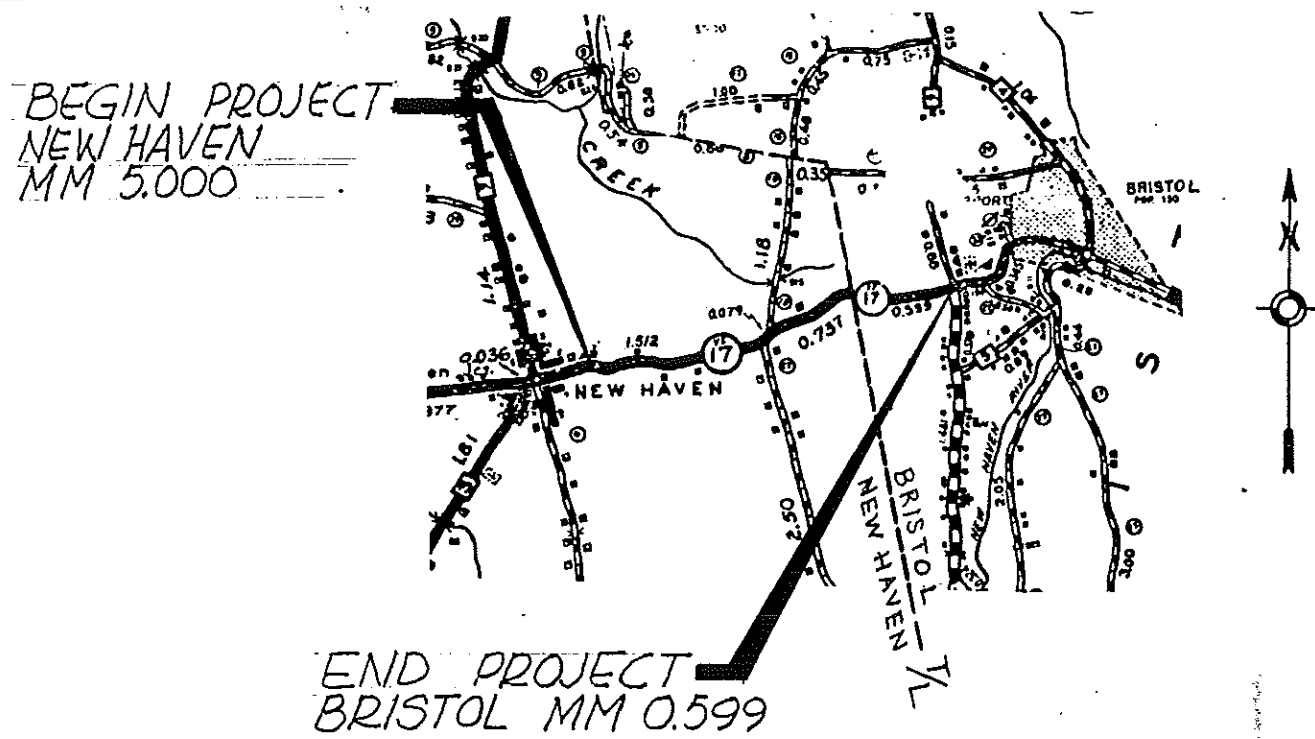

PROJECT LOCATION
BEGINNING IN THE TOWN OF NEW HAVEN AT MM 5.000 AND
EXTENDING EASTERLY ALONG VT. 17 FOR 2.795 MILES TO
MM 0.599 IN THE TOWN OF BRISTOL AT THE JUNCTION
WITH VT. 116.

PROJECT LENGTH
2.795 MILES (14750 FEET)

PROJECT DESCRIPTION
RESURFACE WITH A LEVELING COURSE AND 1 1/4" BITUMINOUS
OVERLAY, PROVIDE PAVED SHOULDERS AND NEW PAVEMENT
MARKINGS AS INDICATED ON THE PLANS OR AS DIRECTED BY
THE ENGINEER.

TRAFFIC DATA
AADT 2040 (1987)
V 35-50 MPH VARIABLE