


NOTE: UNLESS OTHERWISE NOTED ALL MARKINGS SHALL BE 2' FROM CURB
 ALL RADII AROUND CURB SHALL BE DURABLE MARKINGS
 SHADED AREA INDICATES AREA THAT IS NOT TO BE PAVED.


SEE SHEET 504 OF 510 FOR STATION TO STATION LISTING OF CONSTRUCTION ITEMS.

SINCE BRIDGE IS NOT TO BE PAVED, EXISTING PAVEMENT MARKINGS SHALL BE REMOVED PRIOR TO APPLICATION OF NEW MARKINGS.




STATIONING SHOWN FOR REFERENCE ONLY.

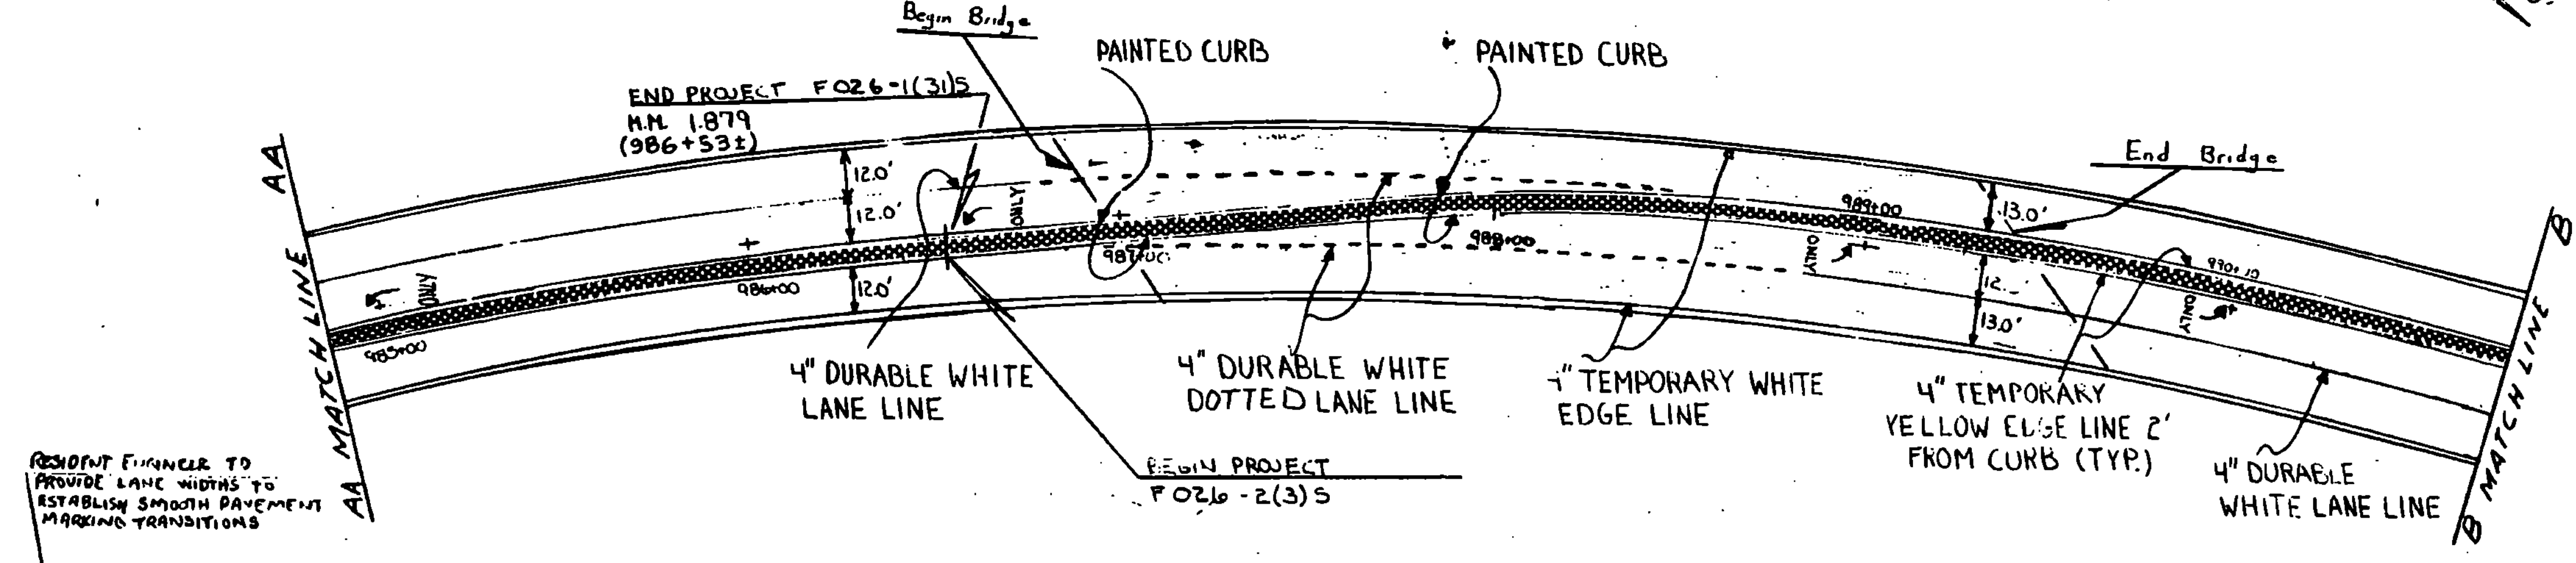

END PROJECT M.M. 2.132
 F 026-2(3)S

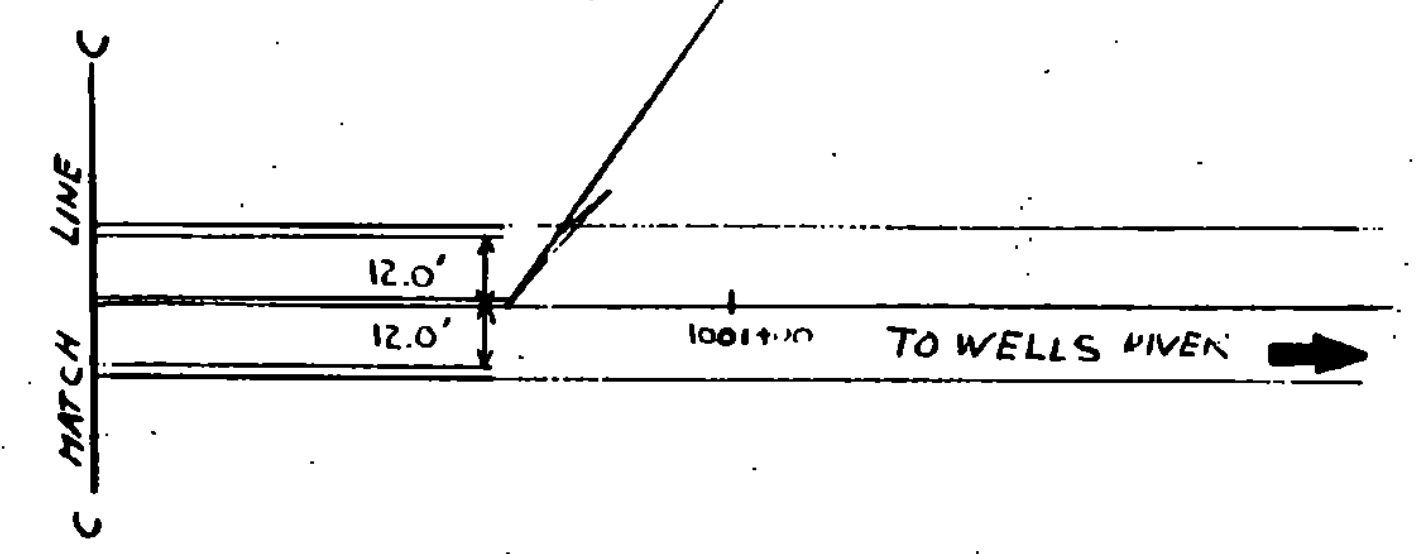

■ = RAISED ISLAND

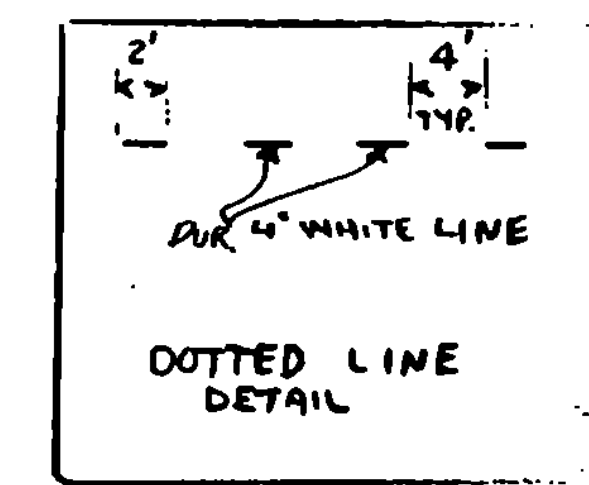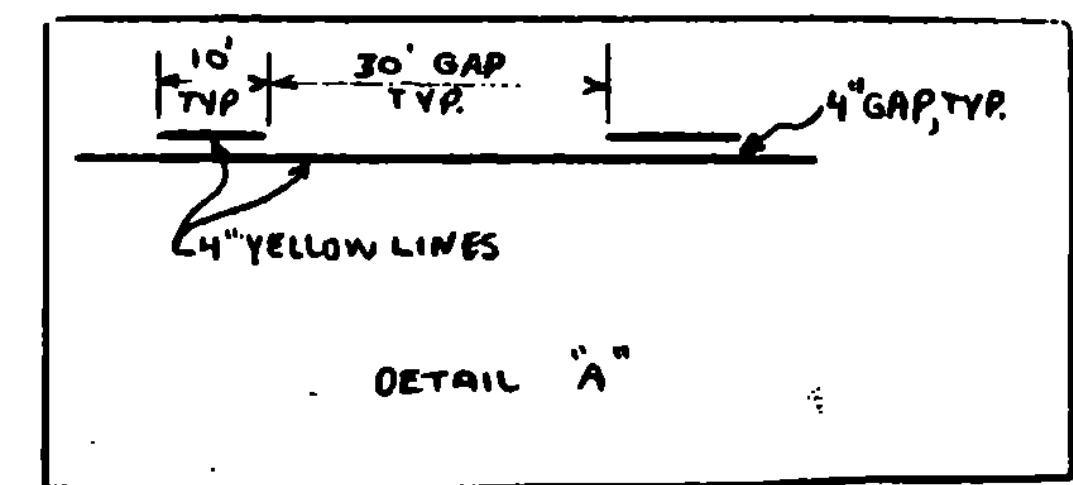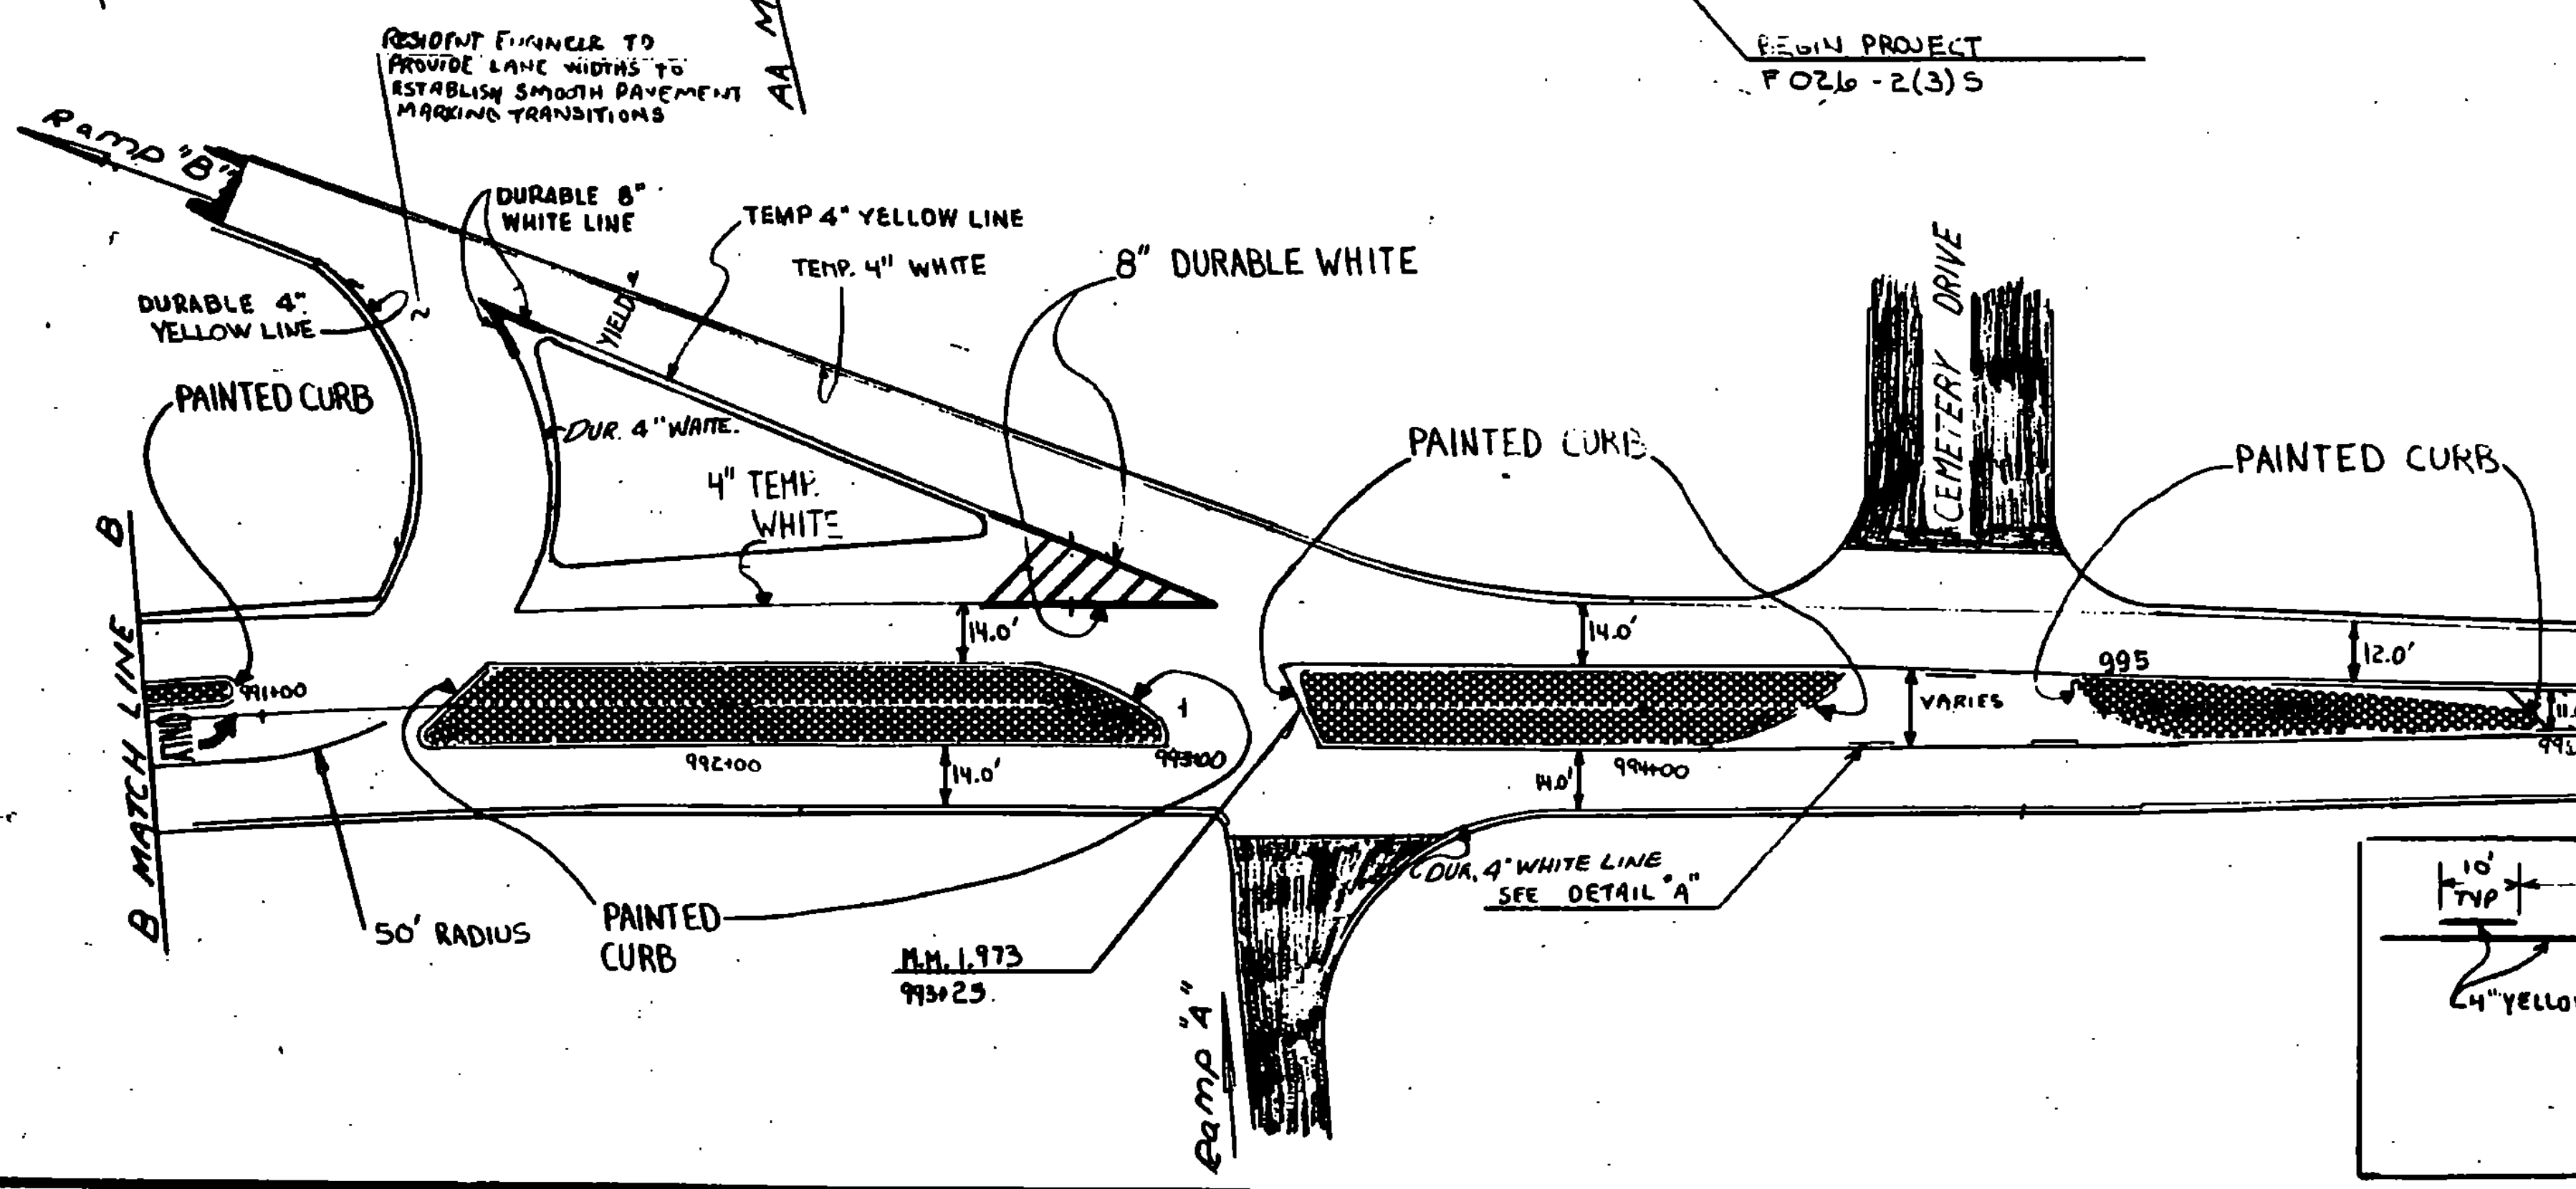

PAVEMENT MARKINGS	PREPARED BY /SW/	DATE 5/87
	CHECKED BY	DATE
	DESIGN SUPERVISOR	DATE
	PROJ. NEWBURY	
	F026-1(3)S, F026-2(3)S	
TRAFFIC SHEET NO. 503	OF 510	
SHEET 8	OF 43	SHEETS

SCALE 1" = 30'