

14
 N.C. HIGHWAY
 (1066-29) S
 TRAFFIC SHEET NO. 502
 SHEET 11 OF 15 SHEETS


SEE TRAFFIC SHEET 502 FOR SIGN LOCATION
 APPROX STA. 991+17.81
 SEE STD. E-161

SCALE 1" = 2'

2-24" FOOTINGS

2 WXL18 POSTS (WOOD)

SEE SIGN DETAIL ON
 TRAFFIC SHEET 510

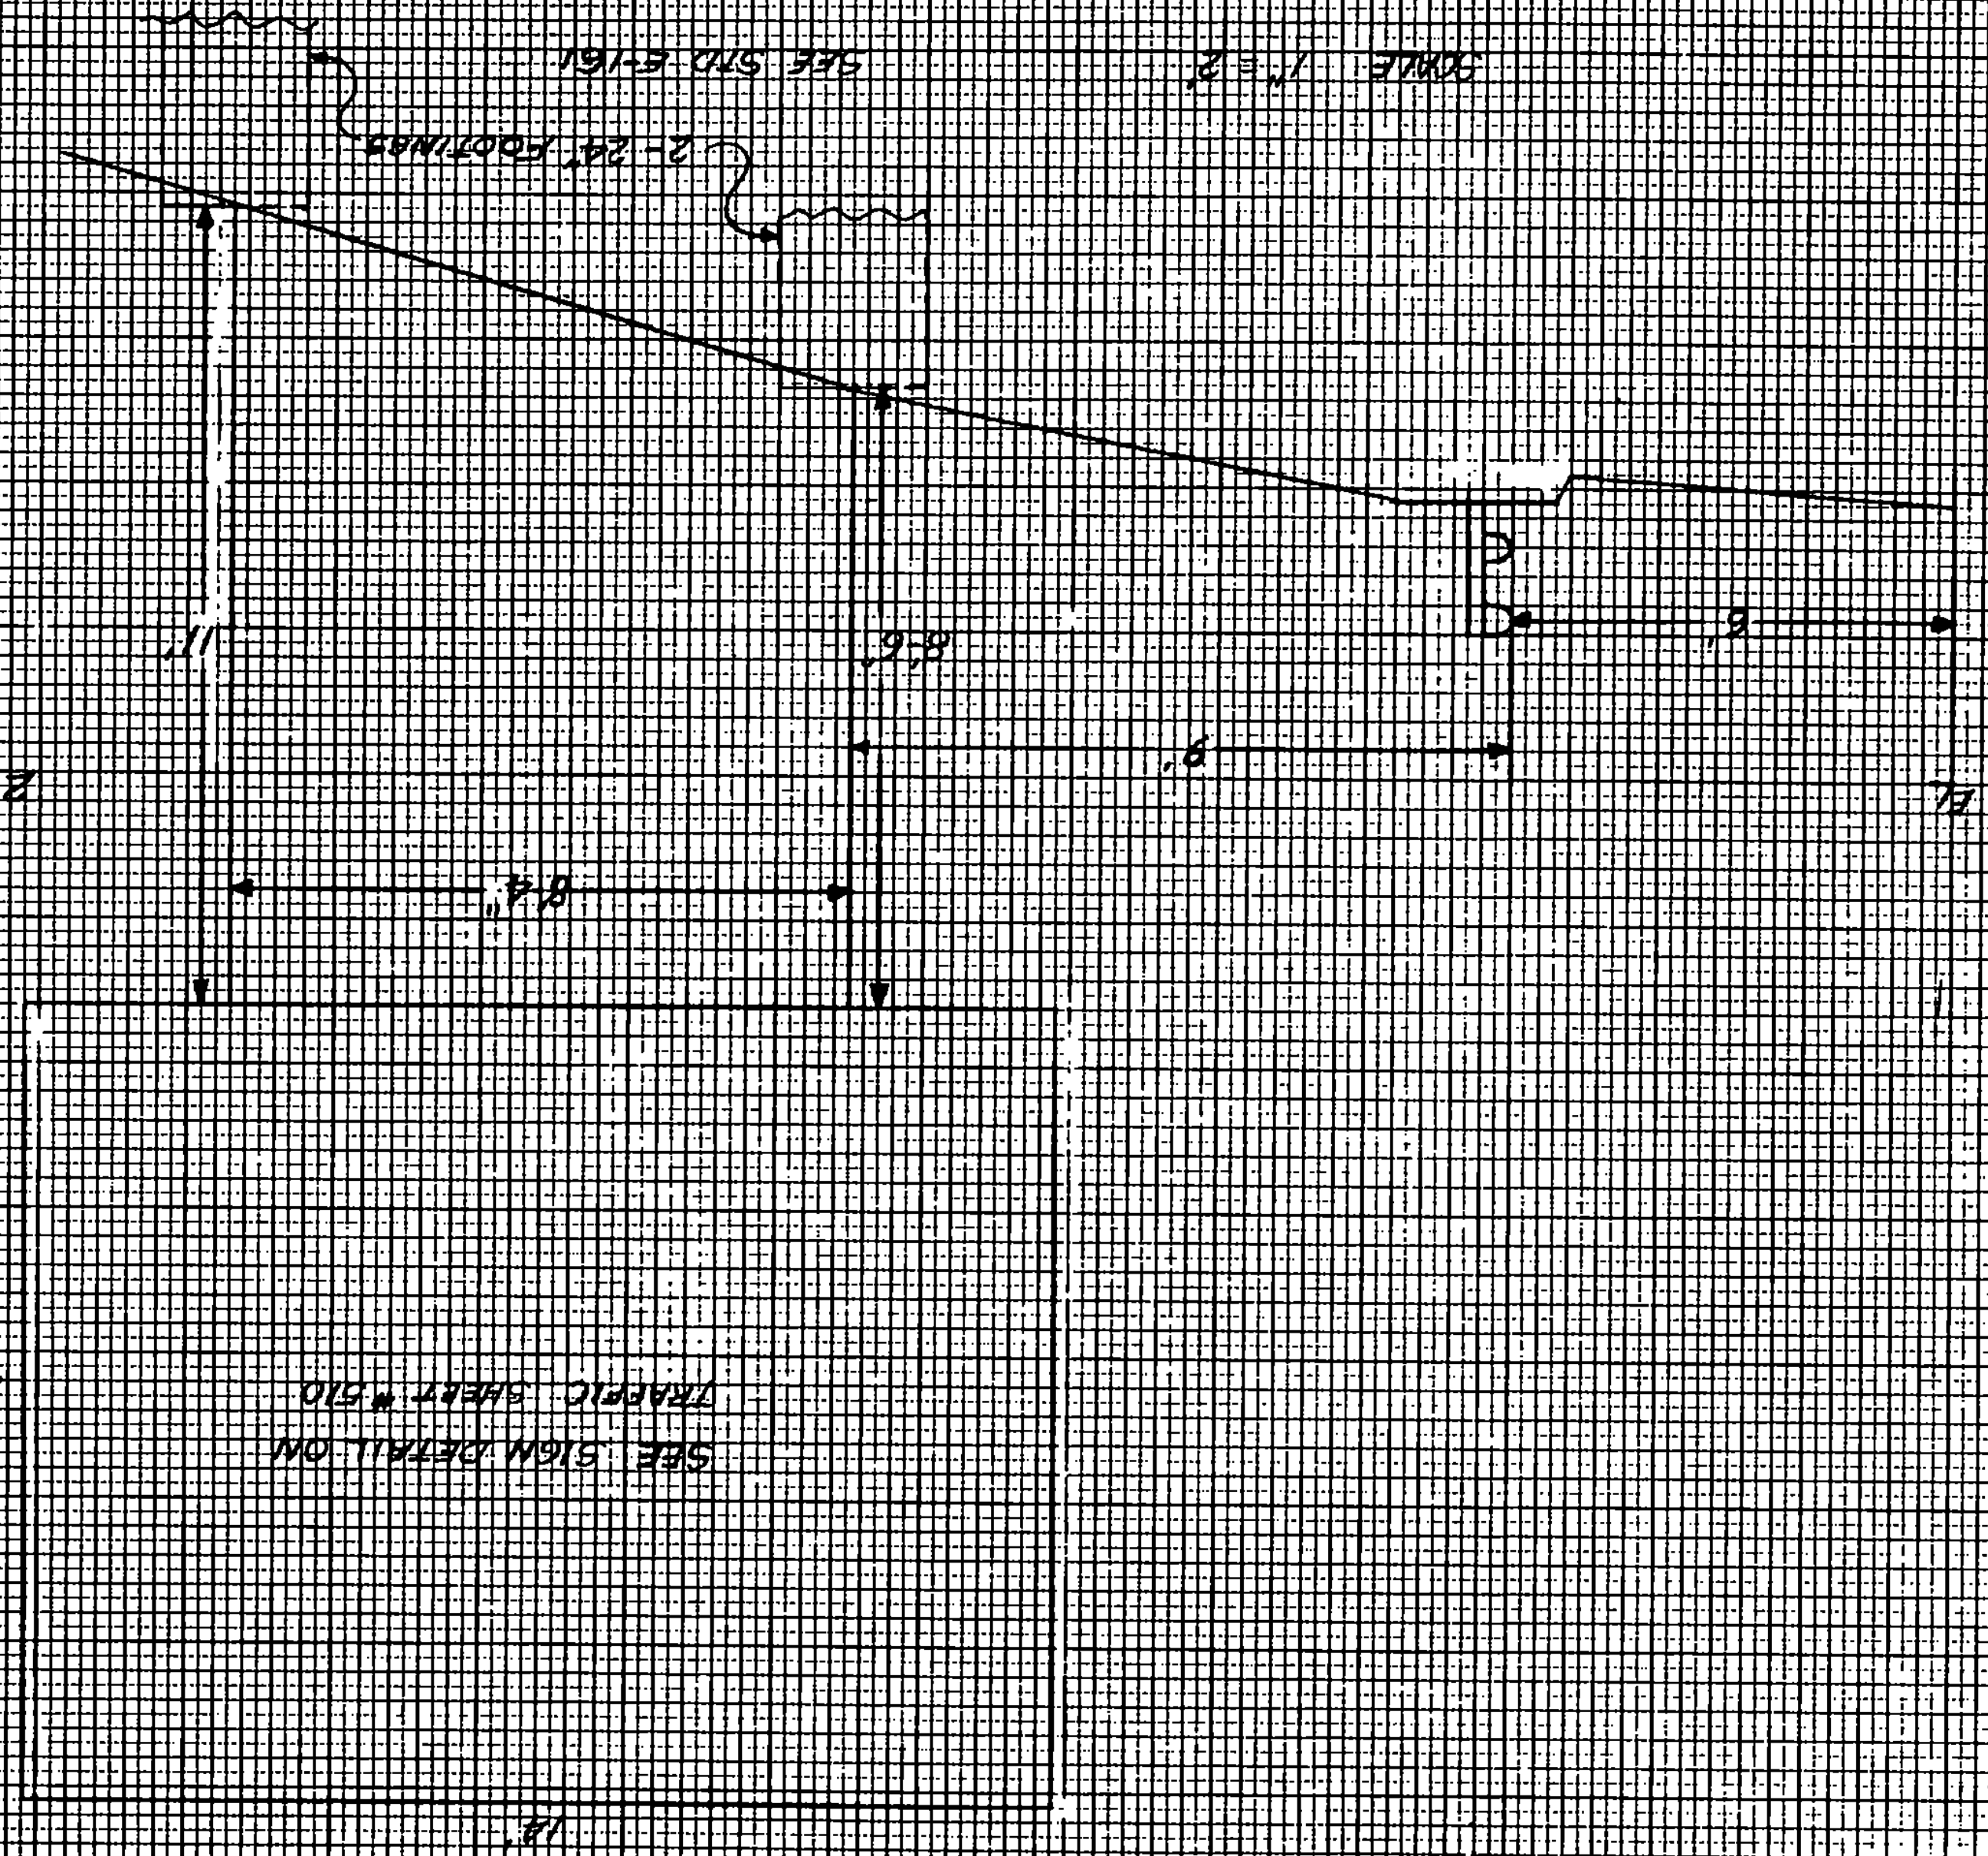

NO.	DATE	BY	REVISION

NO.	DATE	BY	REVISION