

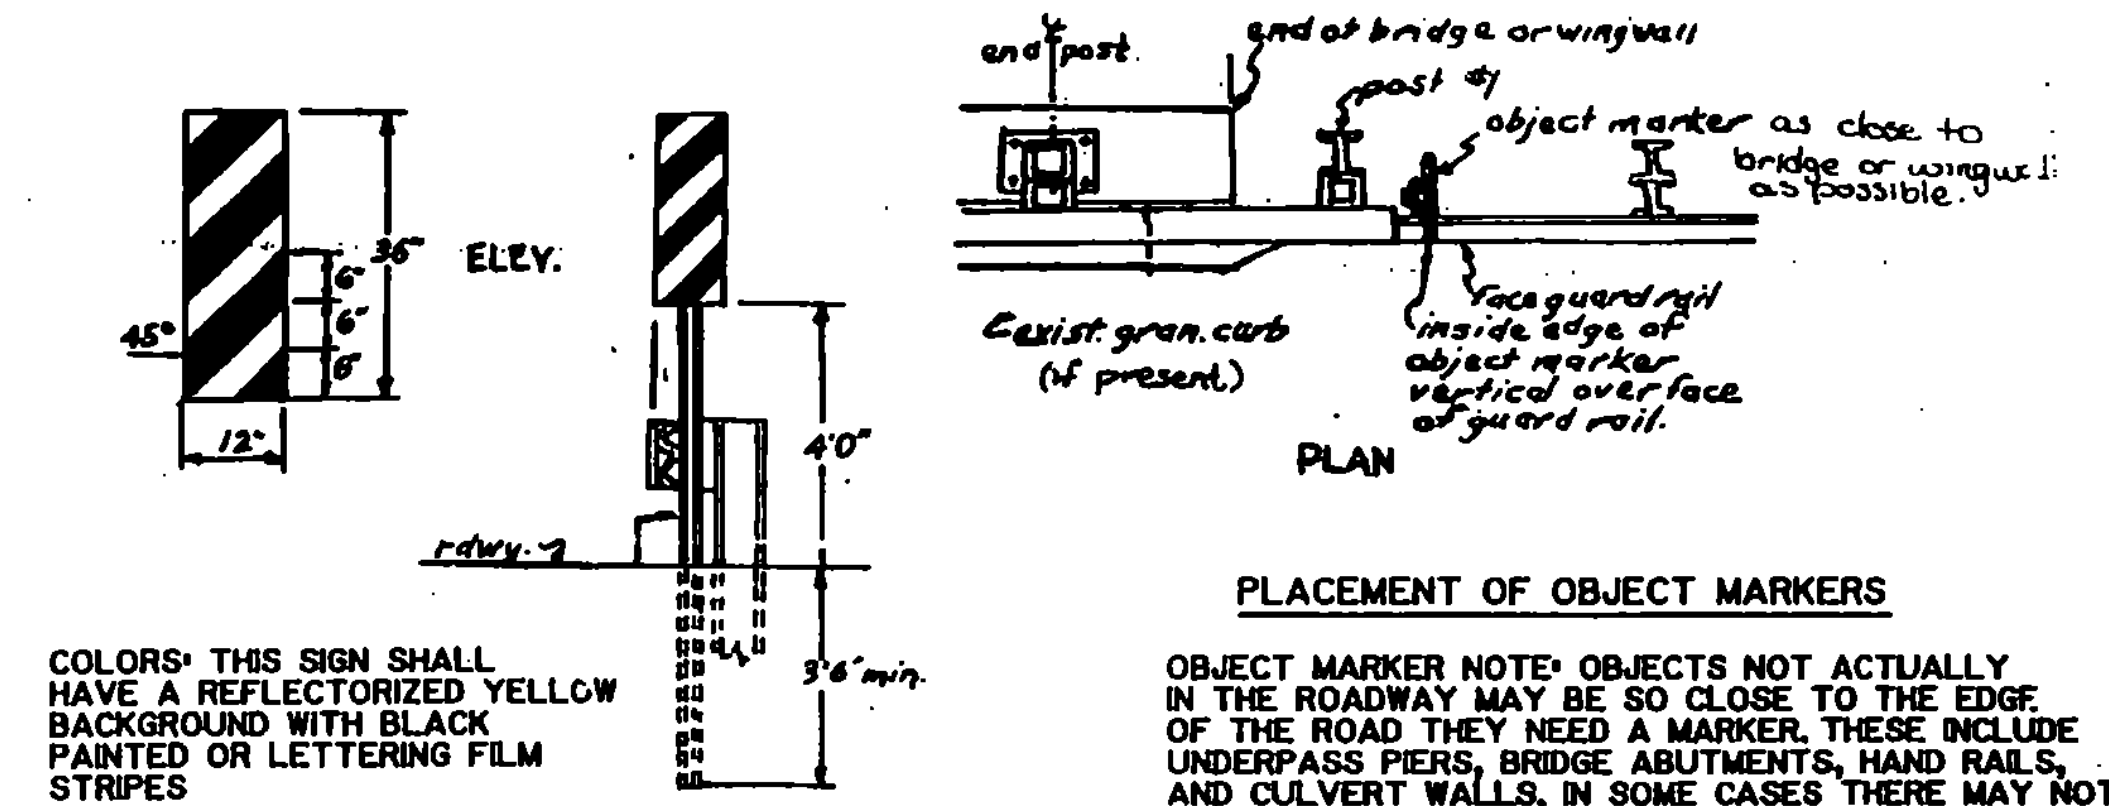
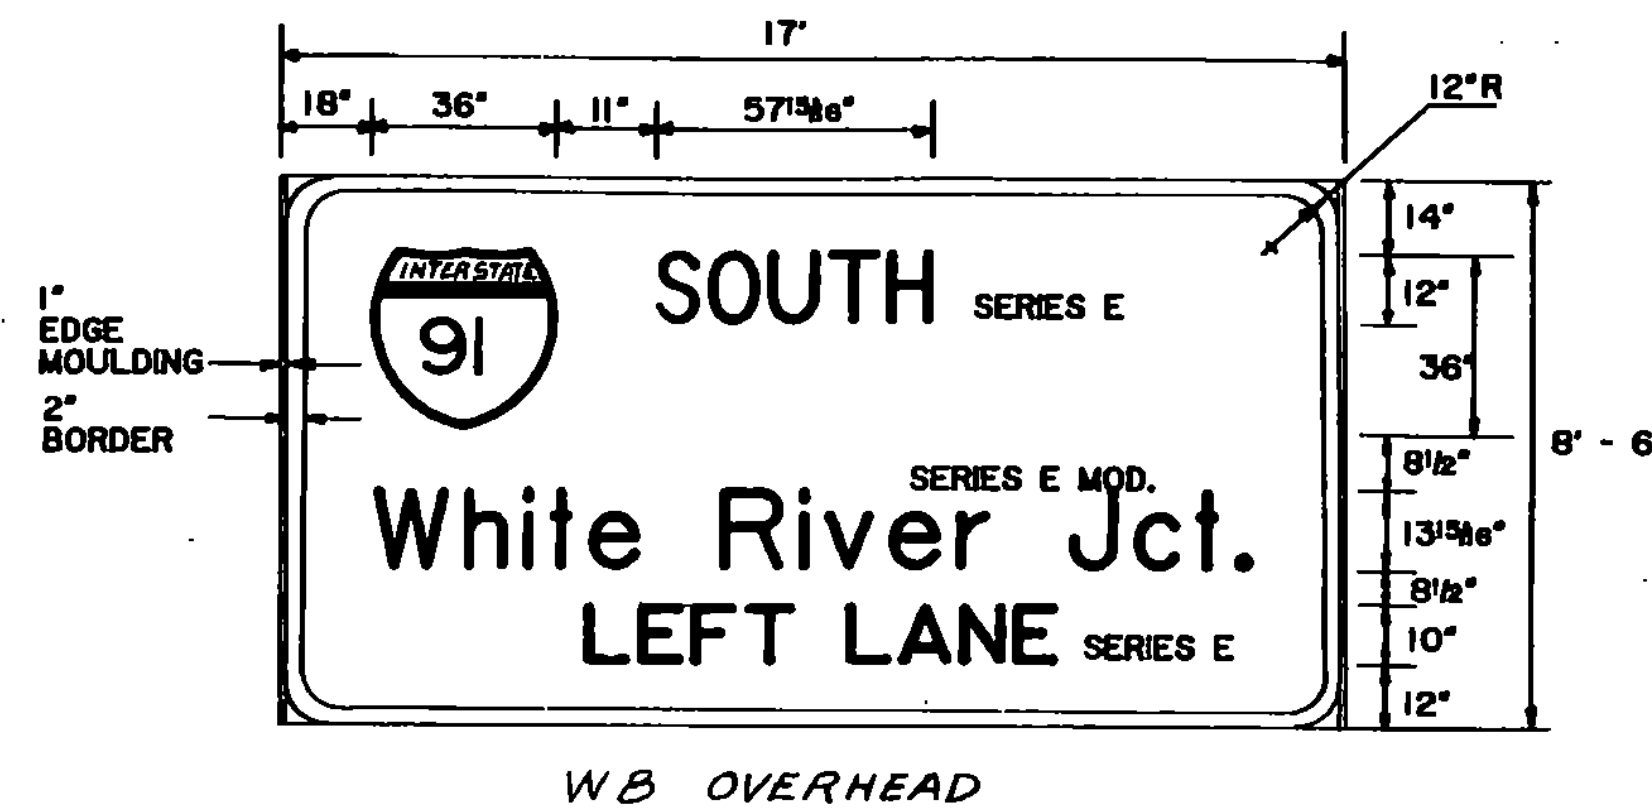
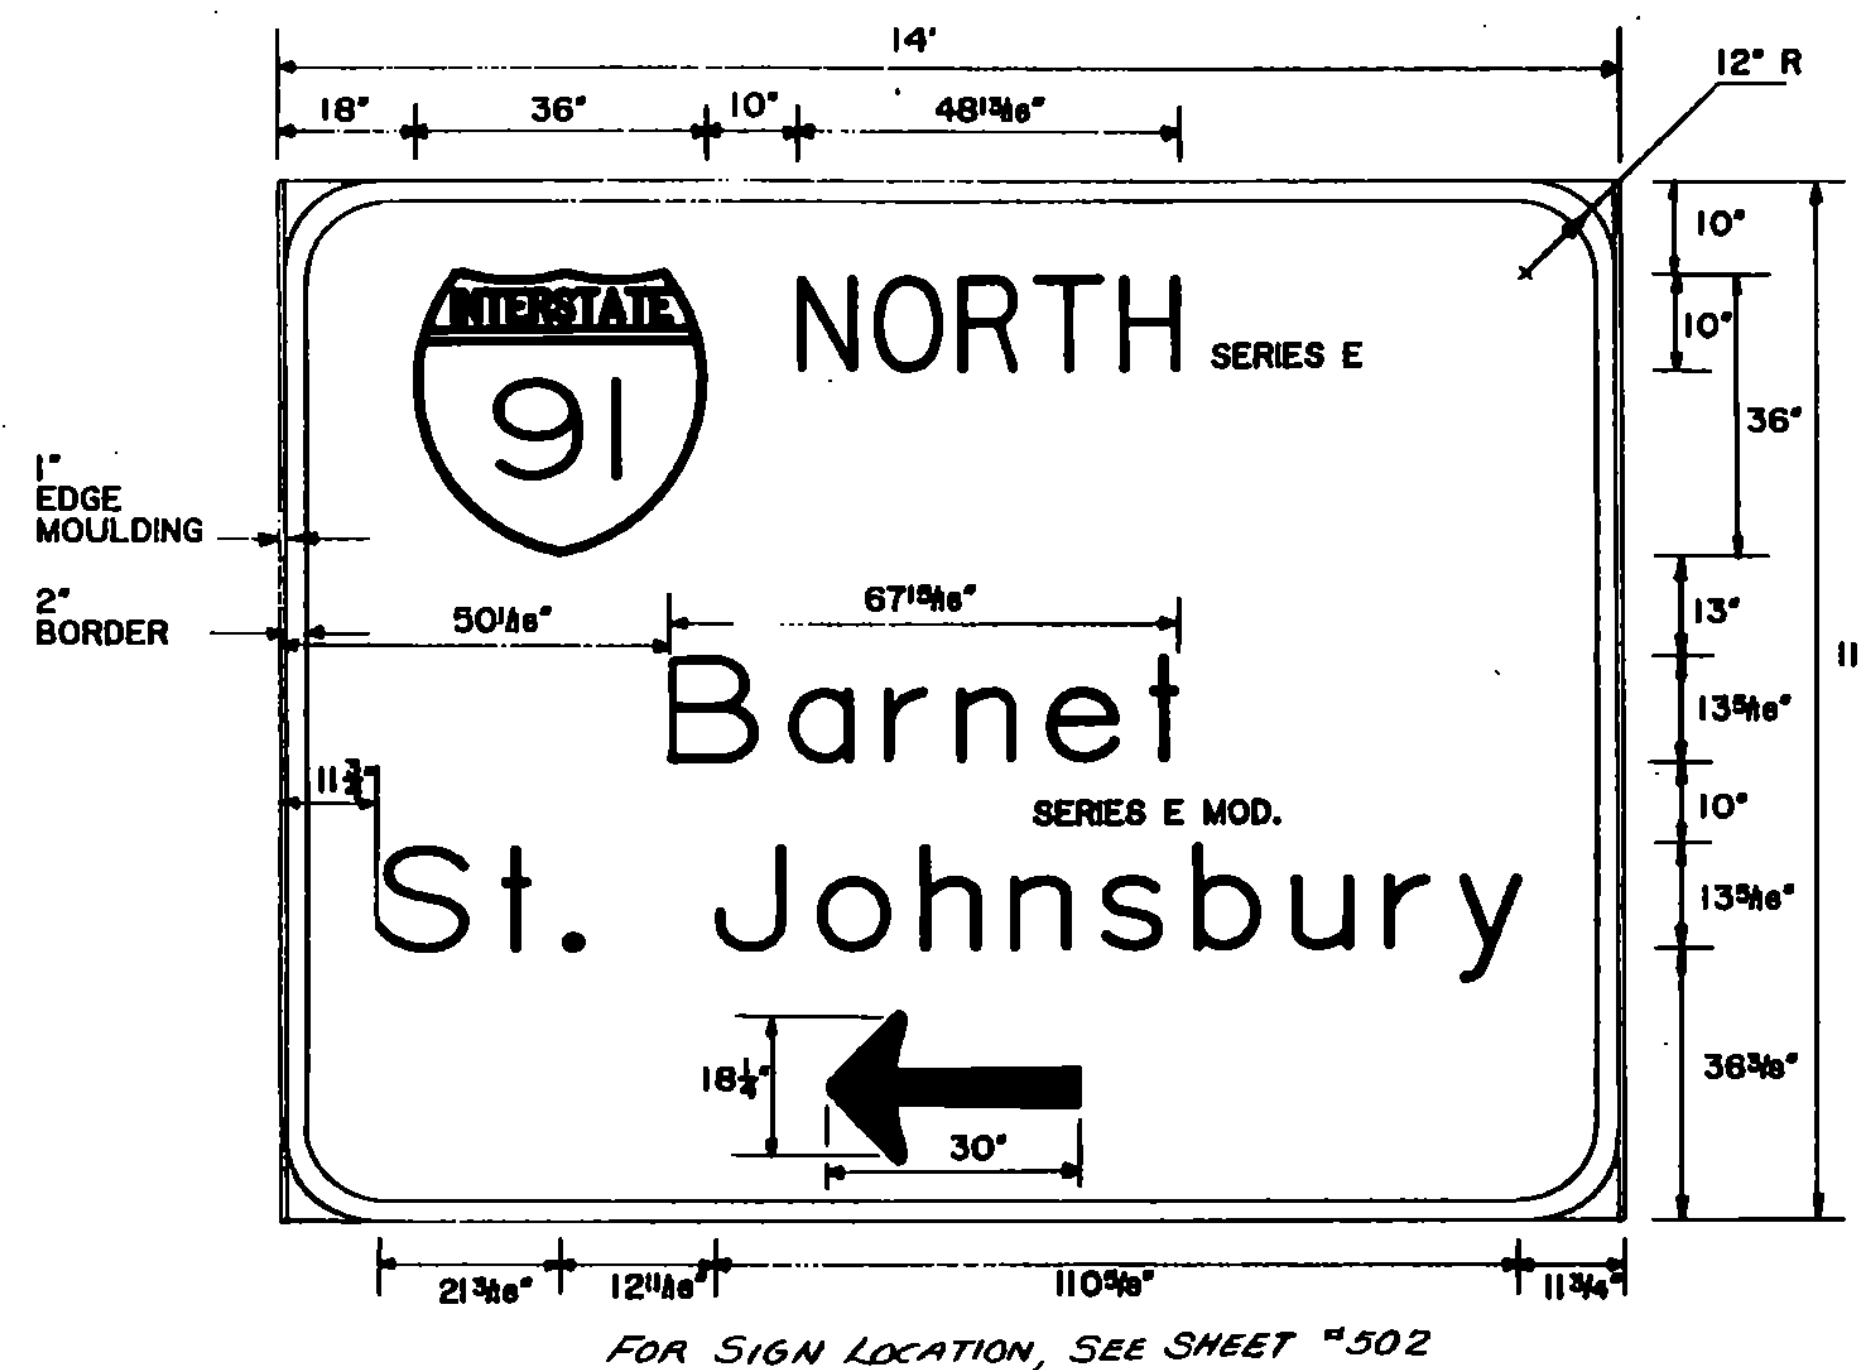
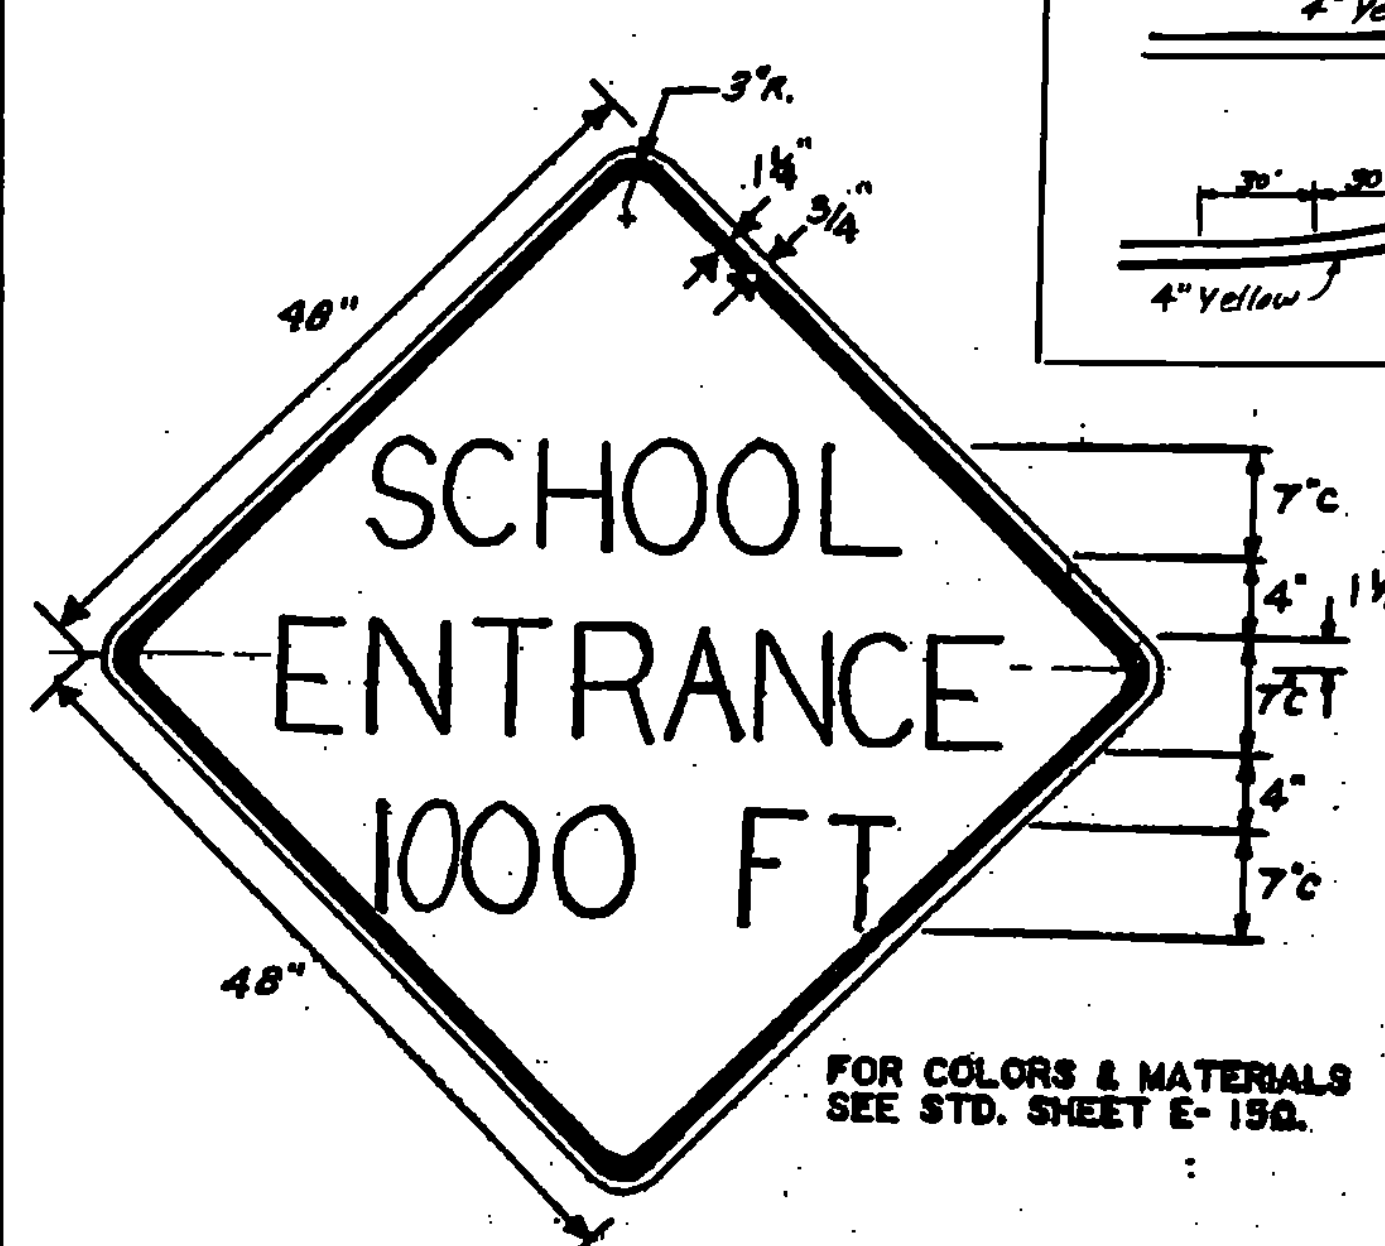
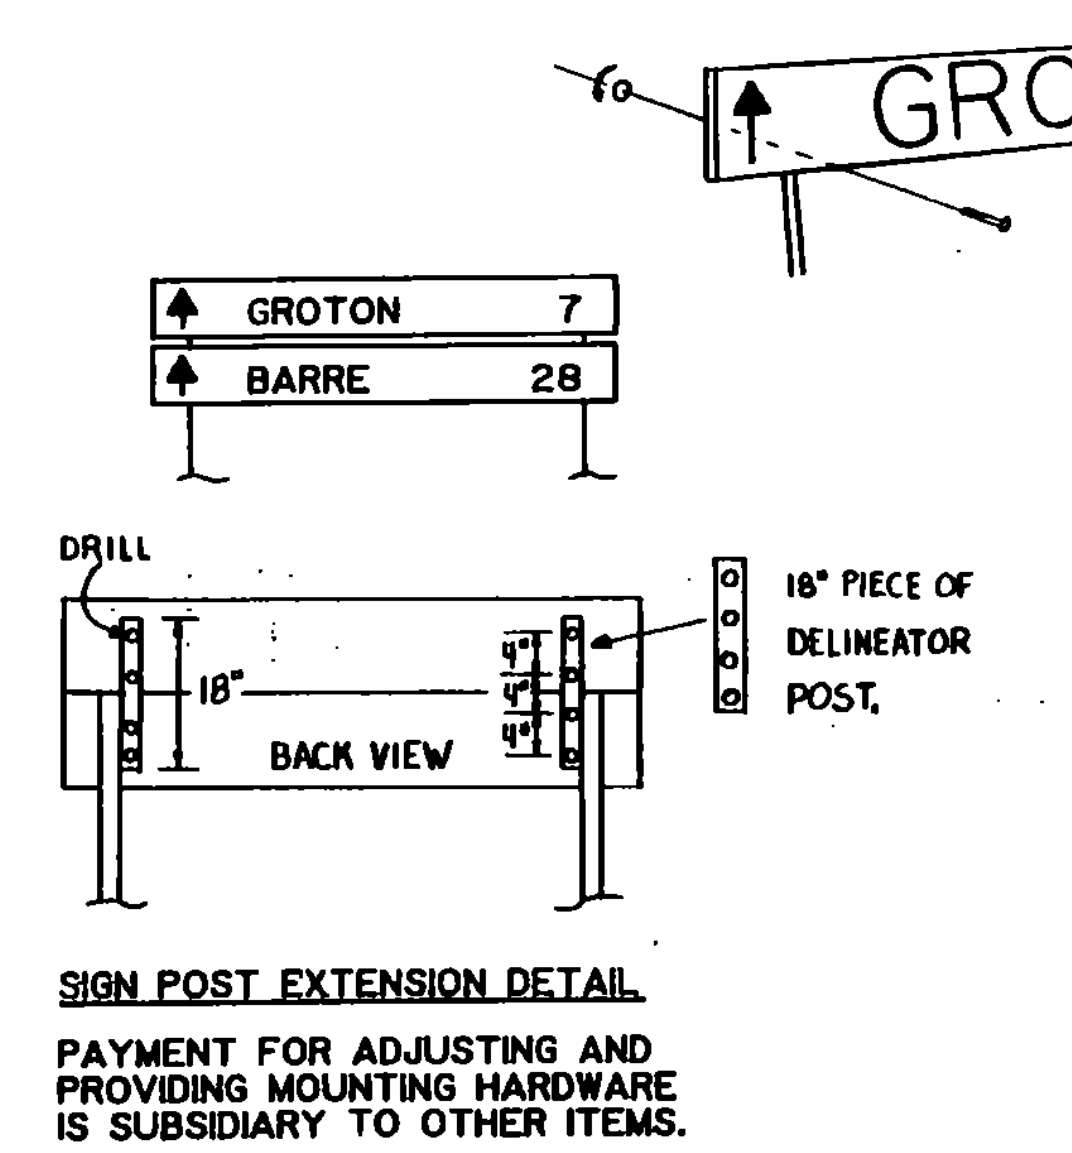
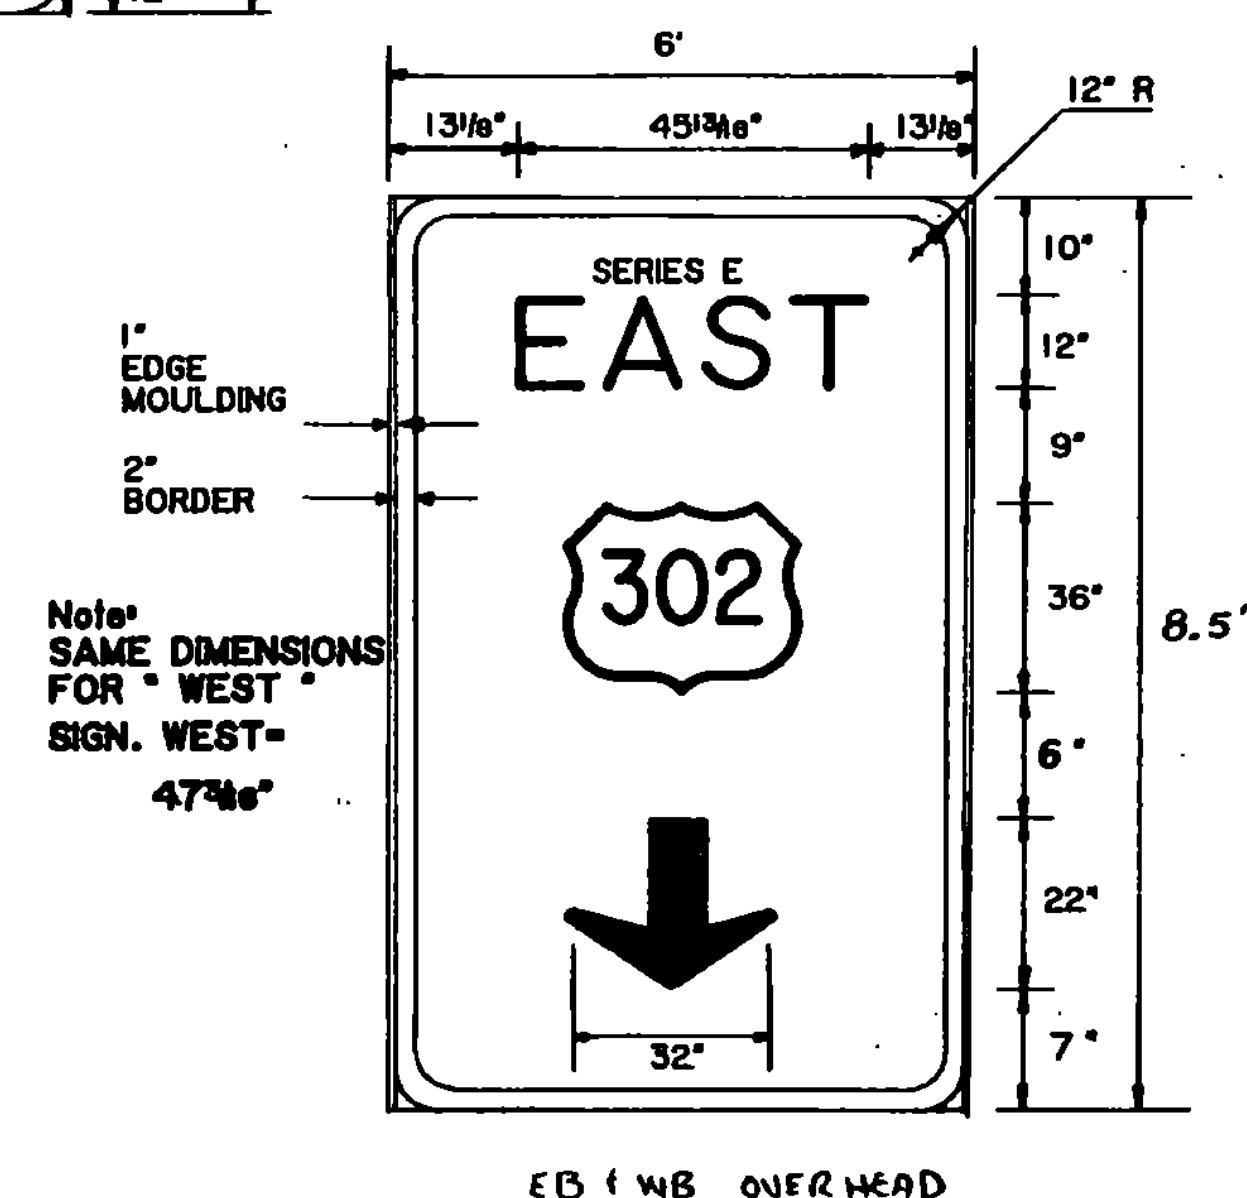
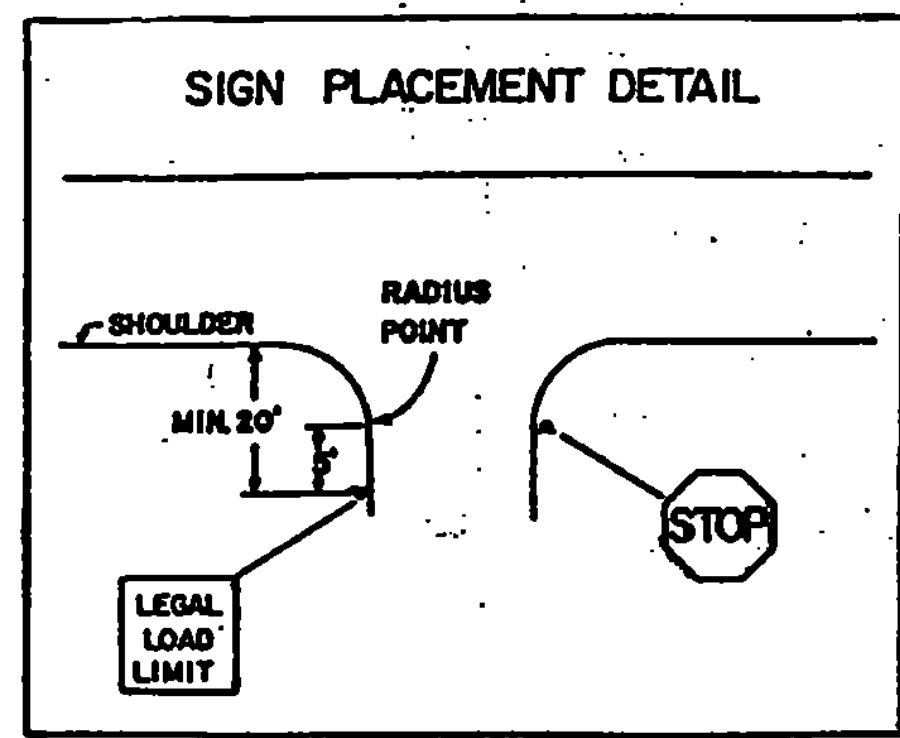


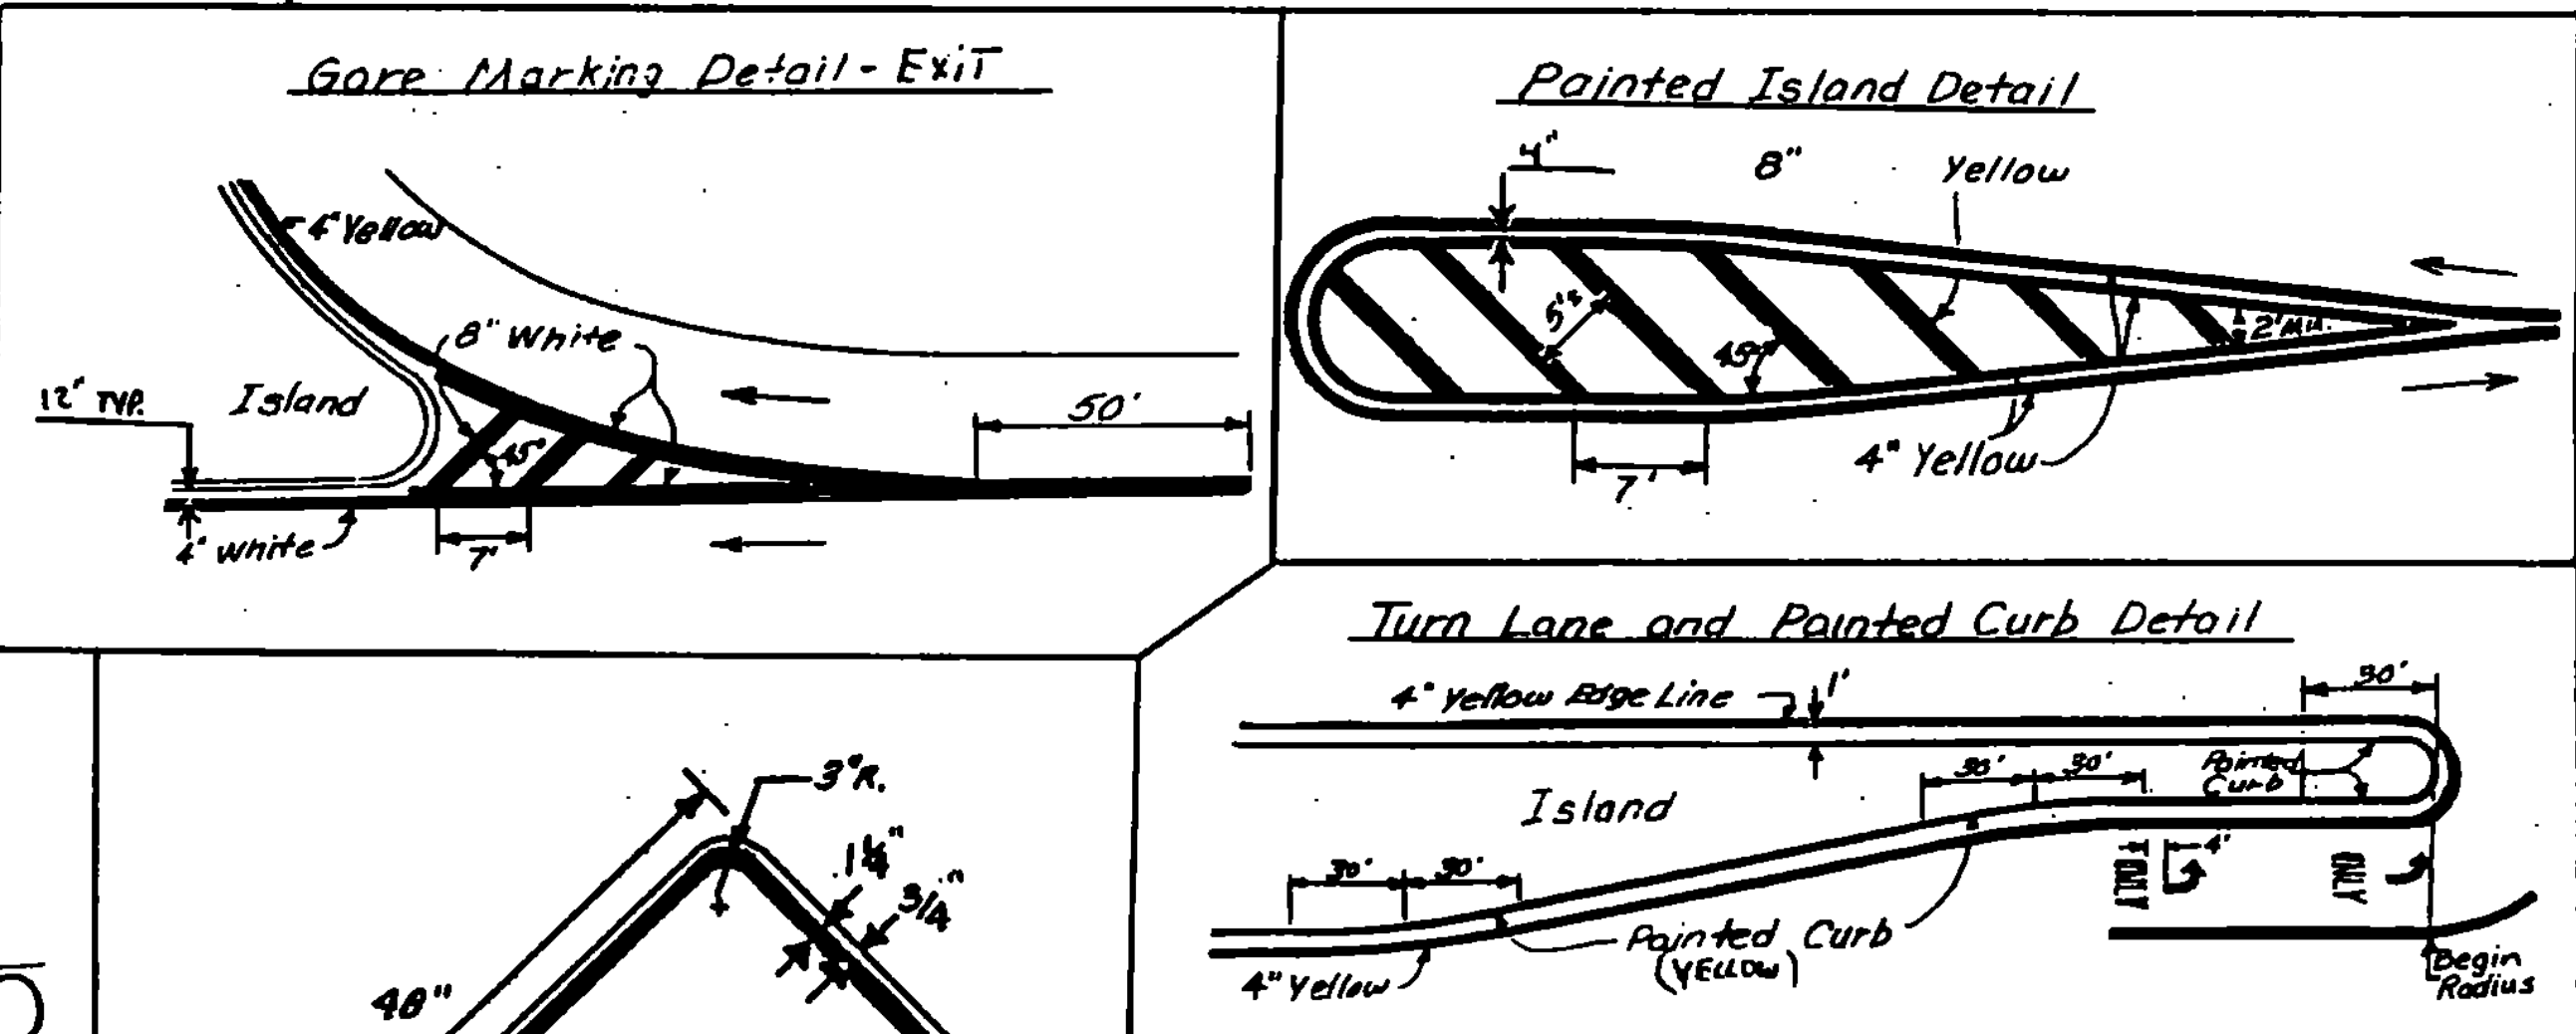

ALL TYPE B SIGNS SHALL HAVE ENCAPSULATED LENS LEGEND AND BACKING. BACKGROUND: GREEN TEXT & BORDER } WHITE SEE STD. E-131 FOR OTHER MATERIALS NOTES.

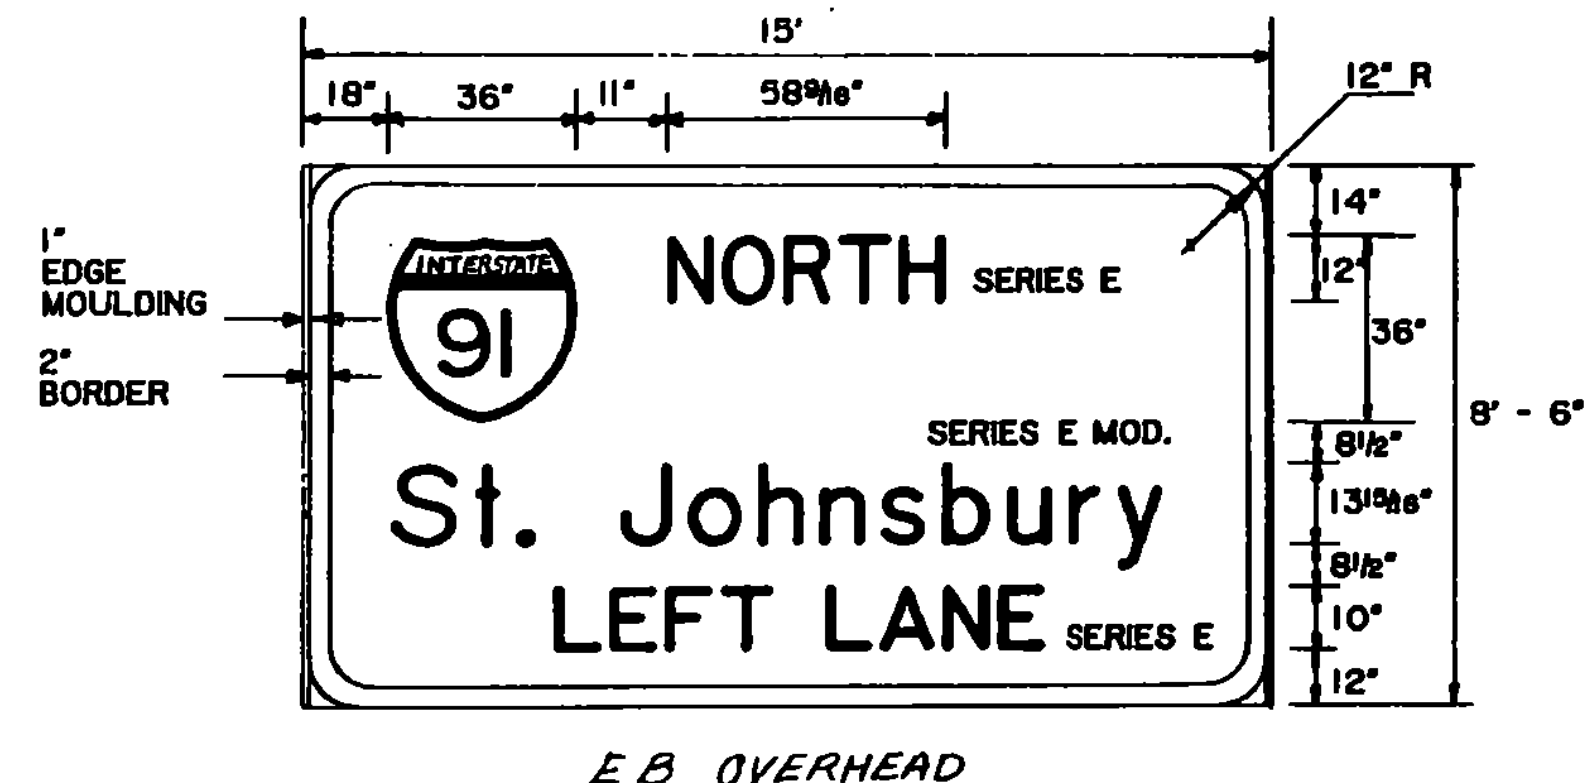

SIGN DETAIL SHEET

SURVEYED BY _____ DATE _____

DRAWN BY _____ DATE _____

TRACED BY _____ DATE _____

NEWBURY

F 026-1 (31) S F 026-2 (3) S

TRAFFIC SHEET NO. 510 OF 510

SHEET 15 OF 43