


DESCRIPTION AND LOCATION

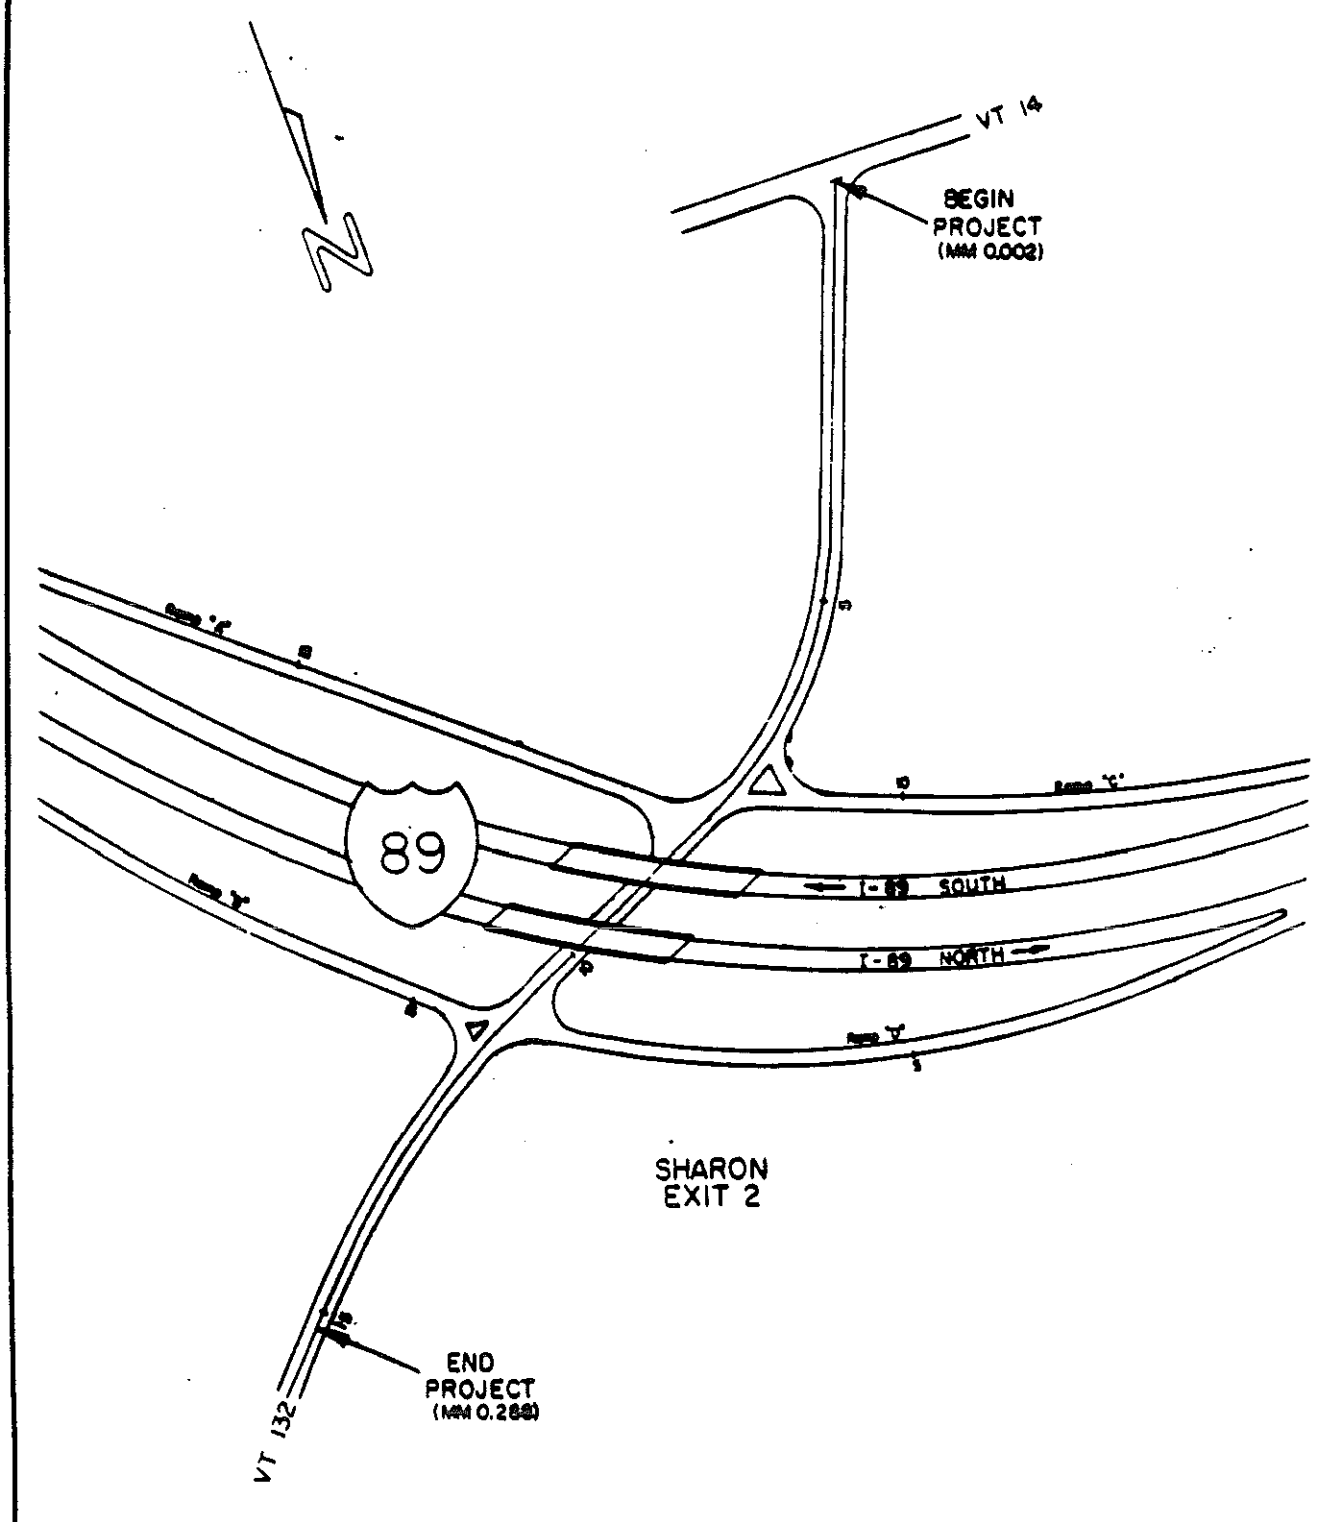

PROJECT SHARON

NO. RS 01715
SHEET 7 OF 31 SHEETS