
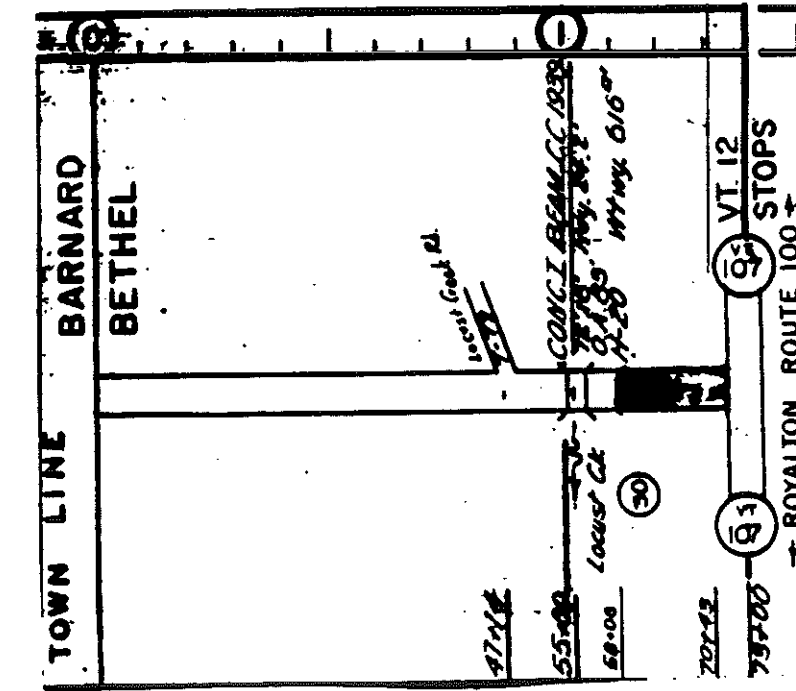


DESCRIPTION AND LOCATION

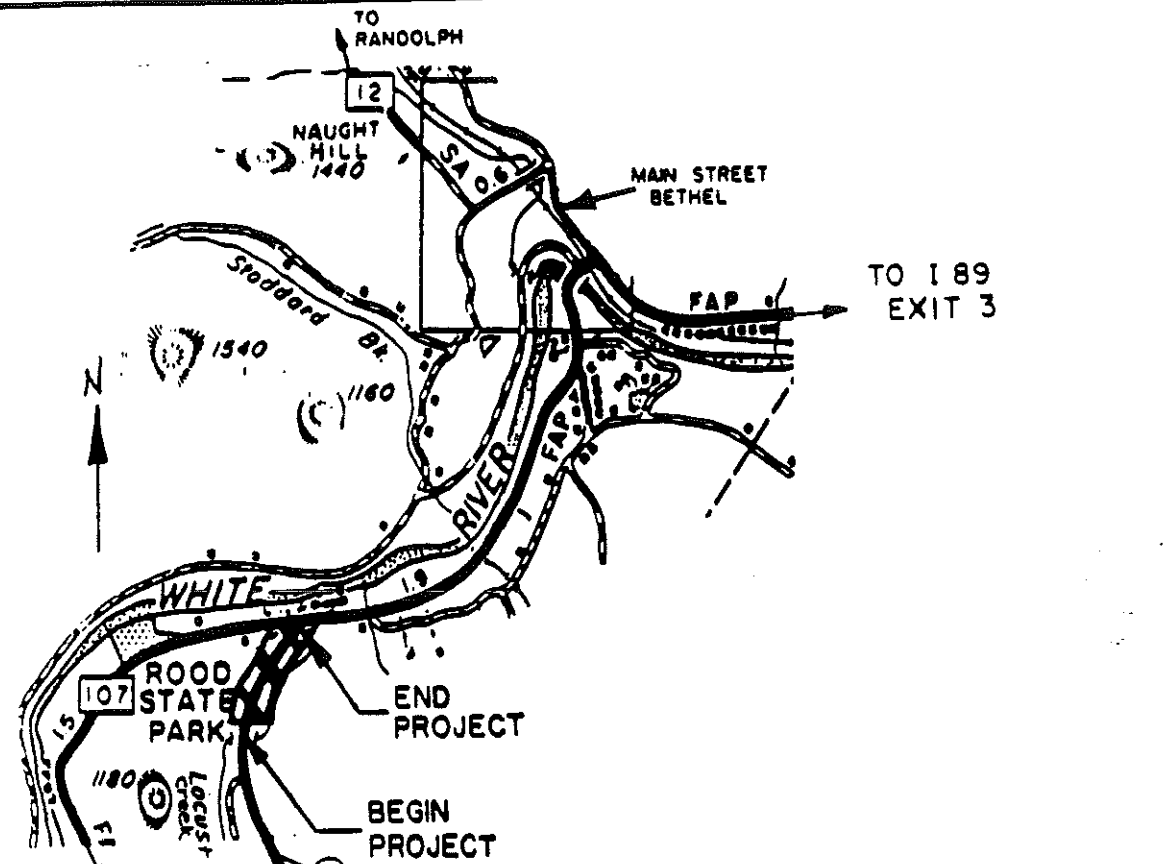

PROJECT BETHEL

NO. HMA 2318
SHEET 23 OF 34 SHEETS