


PROJECT DESCRIPTION AND LOCATION

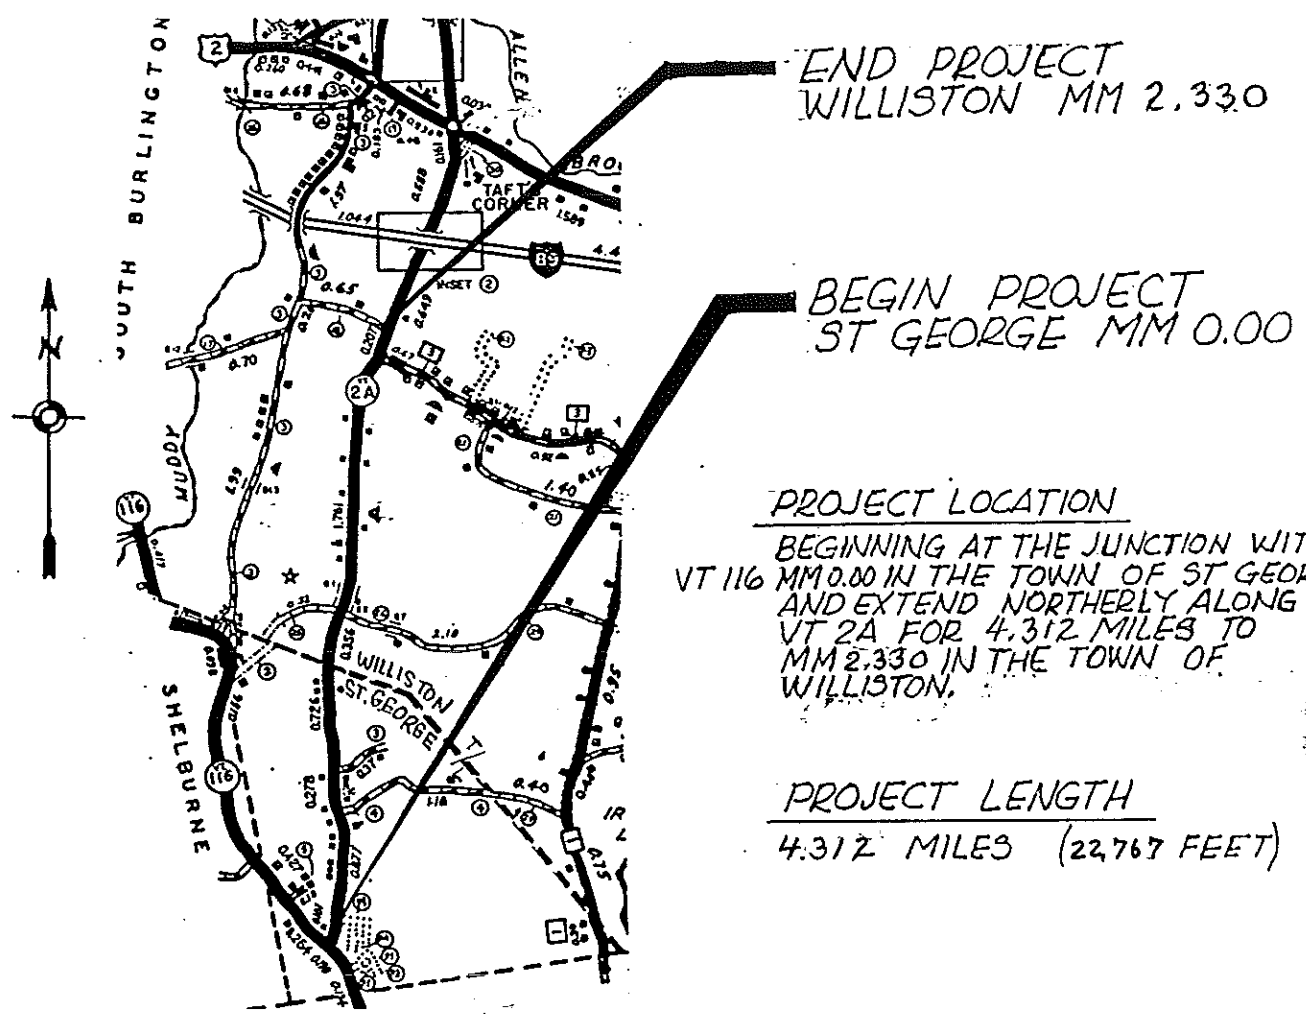

PROJECT LOCATION
 BEGINNING AT THE JUNCTION WITH
 VT 116 MM 0.00 IN THE TOWN OF ST GEORGE
 AND EXTEND NORTHERLY ALONG
 VT 2A FOR 4.312 MILES TO
 MM 2.330 IN THE TOWN OF
 WILLISTON.

PROJECT LENGTH
 4.312 MILES (22,787 FEET)

PROJECT DESCRIPTION
 RESURFACE WITH A LEVELING COURSE AND 1 1/2" BITUMINOUS
 OVERLAY. PROVIDE PAVED SHOULDERS AND NEW PAVEMENT
 MARKINGS AS INDICATED ON THE PLANS OR AS DIRECTED
 BY THE ENGINEER.

TRAFFIC DATA
 AADT 4600
 35-50 VARIABLE (1987)

NO. HMA 2915

PROJECT ST GEORGE - WILLISTON

SHEET 21 OF 31 SHEETS