


PROJECT DESCRIPTION AND LOCATION

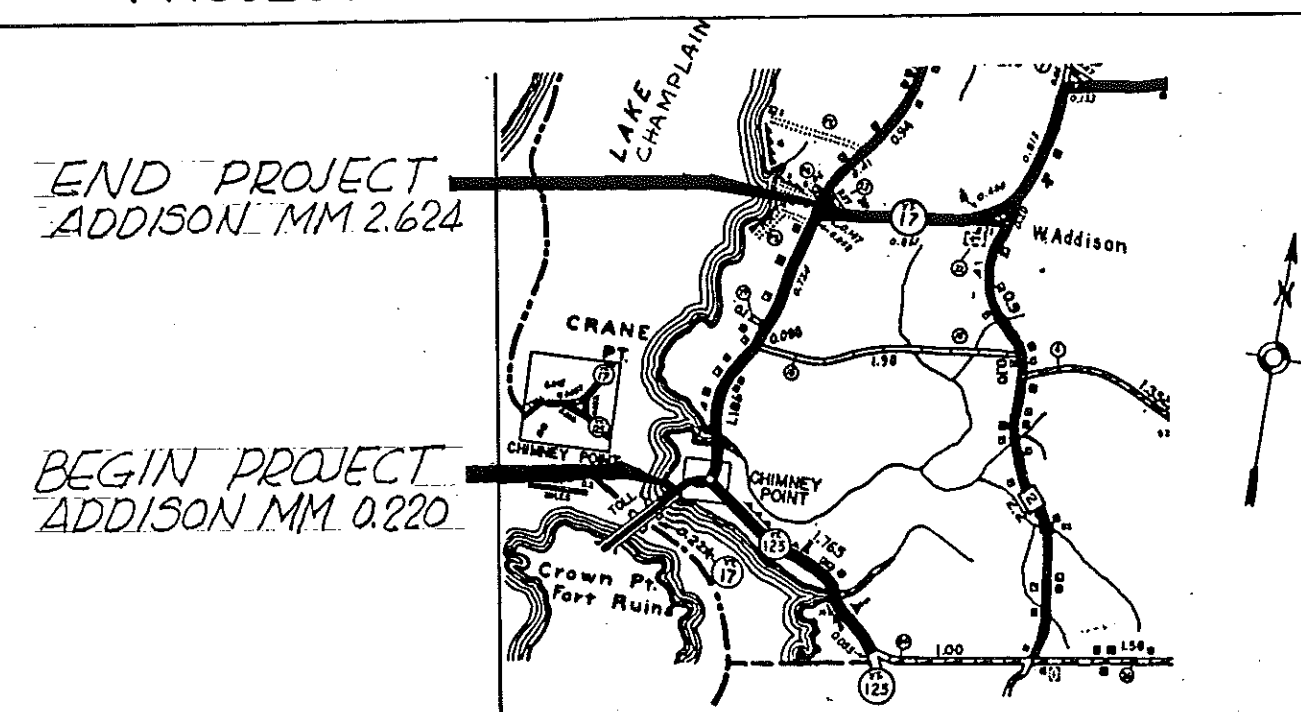

PROJECT LOCATION

BEGINNING IN THE TOWN OF ADDISON AT MM 0.220 AND EXTENDING EASTERLY ALONG VT. 17 FOR 2.404 MILES TO MM 2.624.

PROJECT LENGTH

2.404 MILES (12693 FEET)

PROJECT DESCRIPTION

RESURFACE WITH A LEVELING COURSE AND 1 1/4" BITUMINOUS OVERLAY, PROVIDE PAVED SHOULDERS AND NEW PAVEMENT MARKINGS AS INDICATED ON THE PLANS OR AS DIRECTED BY THE ENGINEER.

TRAFFIC DATA

AADT 1560 (1987)
V 50 MPH