


TYPICAL SECTIONS & DESIGN DATA

ITEM 406.25 BITUMINOUS CONCRETE PAVEMENT
 AGGREGATE SHOULDERS ($\pm 1/2"$)
 LEVELING COURSE TYPE IV (350 TONS/MILE)
 1 1/4" WEARING COURSE TYPE III ($\pm 1/4"$)
 AS DIRECTED BY THE ENGINEER

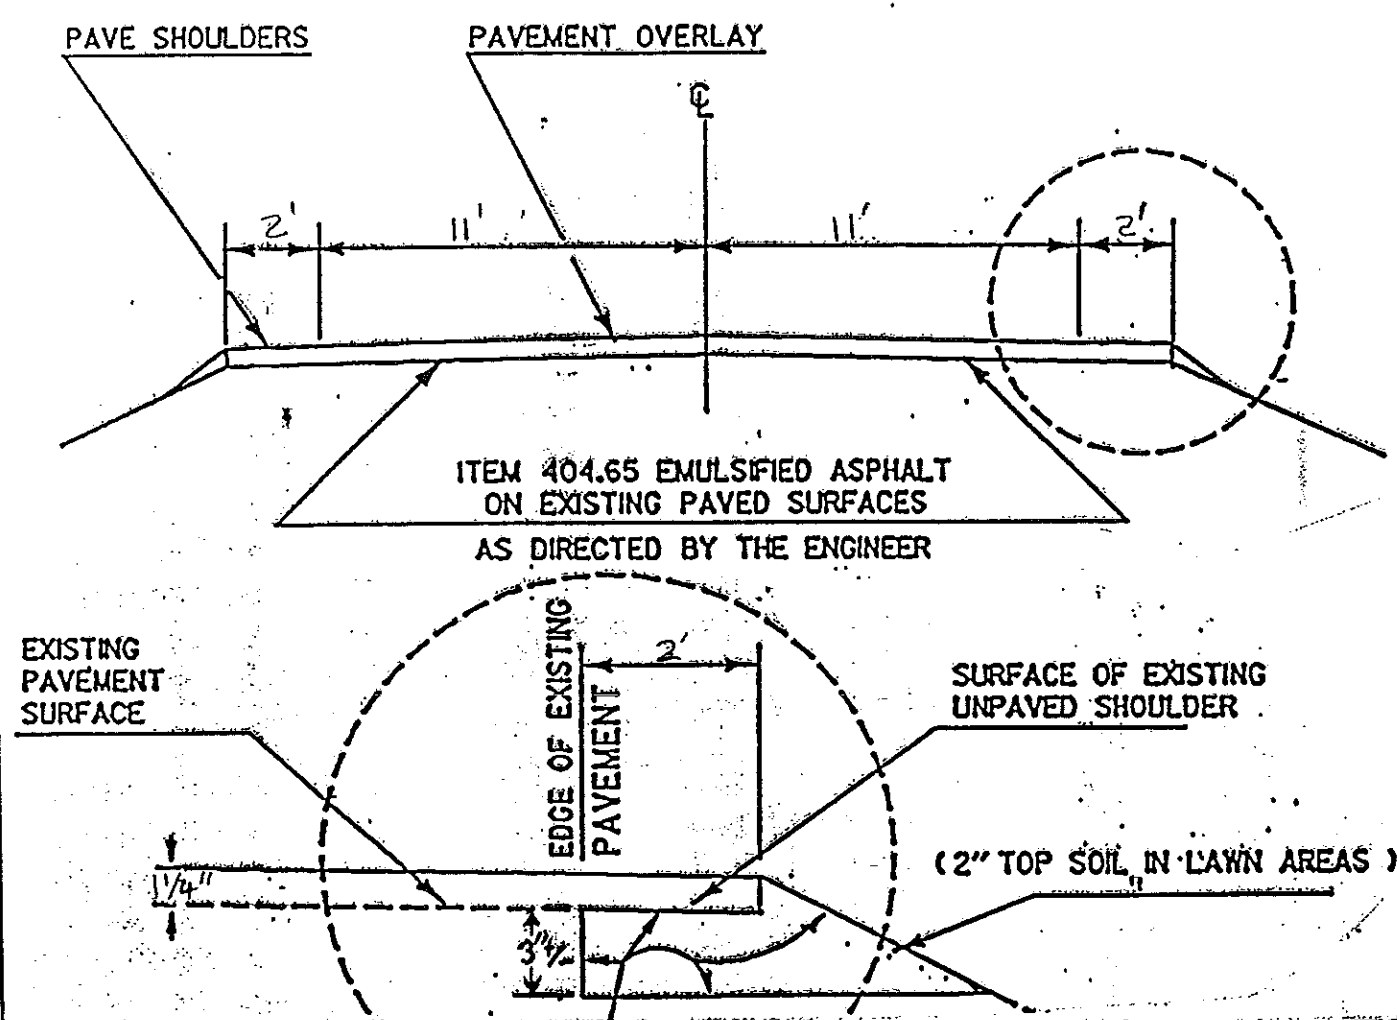

EXCAVATE ALL UNSUITABLE SHOULDER MATERIAL TO THREE INCHES (PLUS OR MINUS) AS DIRECTED BY THE ENGINEER. USE ALL PURPOSE EXCAVATOR RENTAL ADJACENT TO GUARDRAIL, GRADER RENTAL ELSEWHERE. EXCAVATED MATERIAL MUST BE REMOVED FROM THE PROJECT UNLESS SPREAD ON THE SLOPE TO THE SATISFACTION OF THE ENGINEER. USE ALL PURPOSE EXCAVATOR RENTAL AND TRUCK RENTAL FOR REMOVING, GRADER RENTAL AND/OR ALL PURPOSE EXCAVATOR RENTAL FOR SPREADING. REPLACE WITH AGGREGATE SHOULDER MATERIAL. COMPACT TO THE SATISFACTION OF THE ENGINEER.

NO. HMA 2922

PROJECT ADDISON

SHEET 10 OF 31 SHEETS