


PROJECT DESCRIPTION AND LOCATION

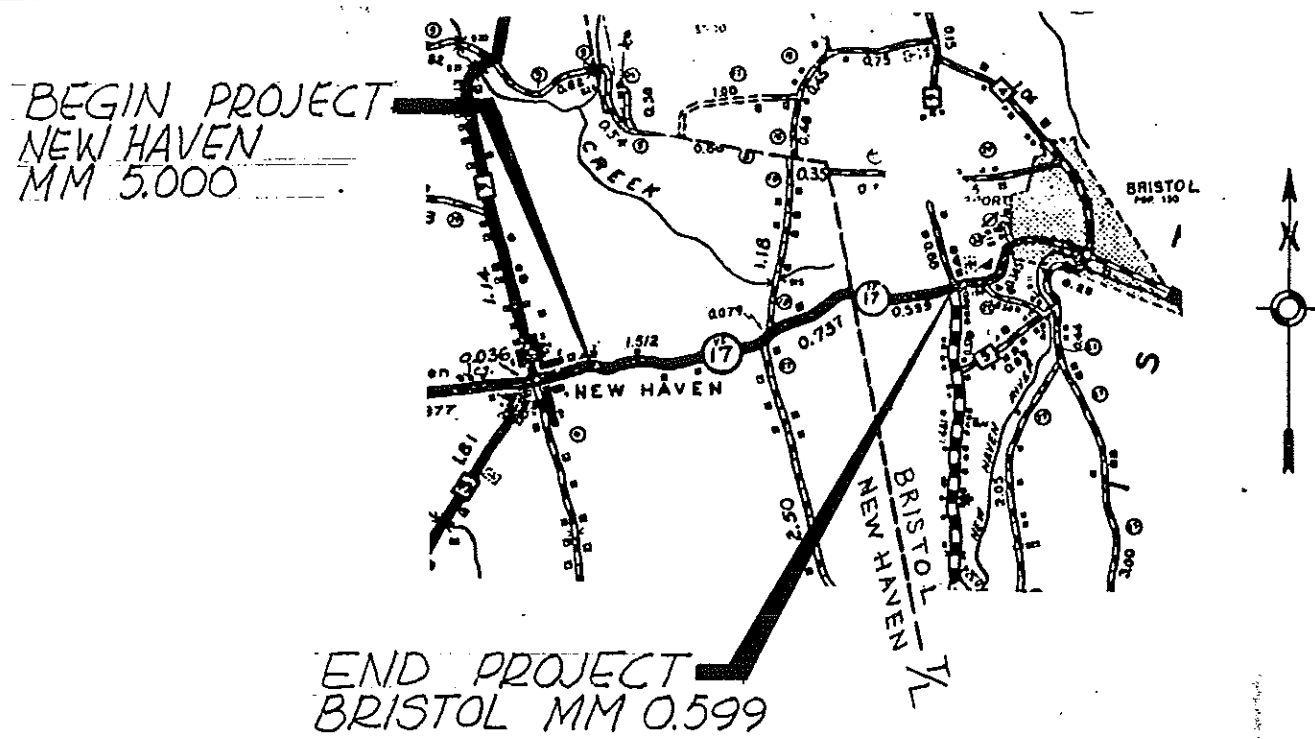

PROJECT LOCATION  
BEGINNING IN THE TOWN OF NEW HAVEN AT MM 5.000 AND  
EXTENDING EASTERLY ALONG VT. 17 FOR 2.795 MILES TO  
MM 0.599 IN THE TOWN OF BRISTOL AT THE JUNCTION  
WITH VT. 116.

PROJECT LENGTH  
2.795 MILES (14750 FEET)

PROJECT DESCRIPTION  
RESURFACE WITH A LEVELING COURSE AND 1 1/4" BITUMINOUS  
OVERLAY, PROVIDE PAVED SHOULDERS AND NEW PAVEMENT  
MARKINGS AS INDICATED ON THE PLANS OR AS DIRECTED BY  
THE ENGINEER.

TRAFFIC DATA  
AADT 2040 (1987)  
V 35-50 MPH VARIABLE