


TYPICAL SECTIONS & DESIGN DATA

BITUMINOUS CONCRETE PAVEMENT  
LEVELING COURSE TYPE IV (450 TONS/MILE)  
OR AS DIRECTED BY THE ENGINEER  
1/4" WEARING COURSE TYPE III (1/4")

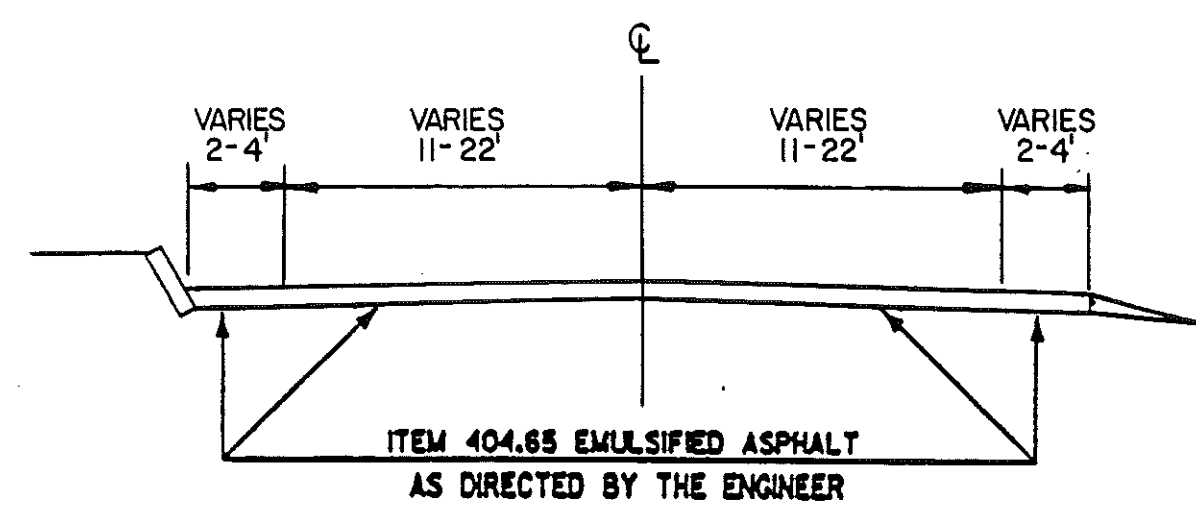

MM 0.002 TO MM 0.120  
MM 0.190 TO MM 0.288

The roadway is to be overlaid to cover the entire width of the existing paved surfaces.  
The contractor must duplicate the existing markings and is responsible for documenting the location of those markings prior to any paving operations.