


TYPICAL SECTIONS & DESIGN DATA

BITUMINOUS CONCRETE PAVEMENT  
LEVELING COURSE TYPE IV (450 TONS/MILE)  
OR AS DIRECTED BY THE ENGINEER  
1 1/4" WEARING COURSE TYPE III (± 1/4")

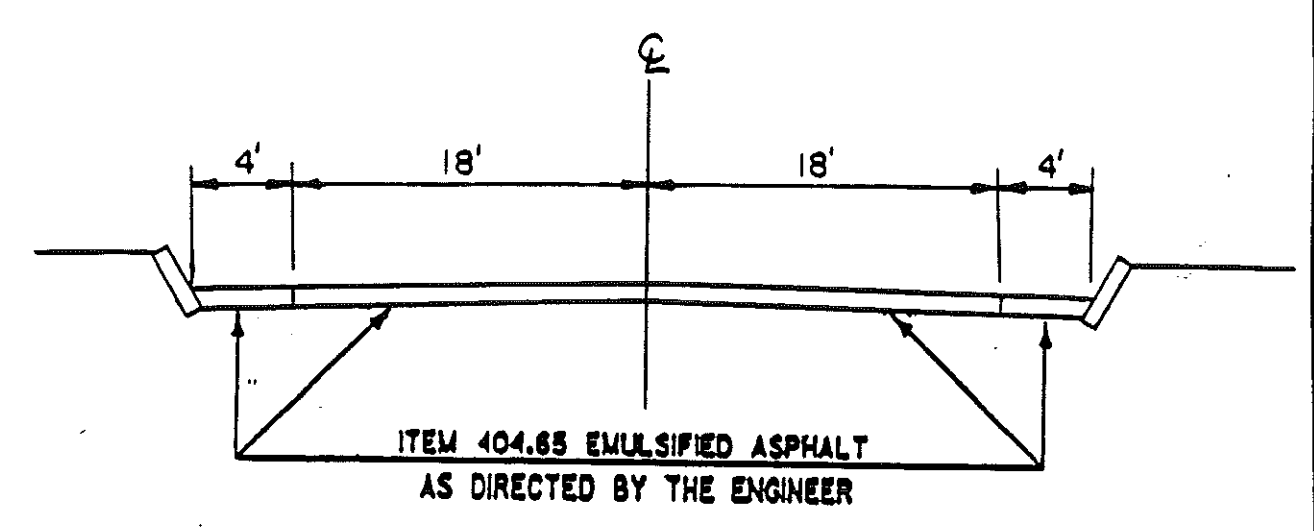

MM 0.15 TO 0.22