


PAVING LIMITS FOR TOWN ROADS & DRIVES

PAVING LIMITS FOR TOWN ROADS



PAVING LIMITS FOR DRIVES

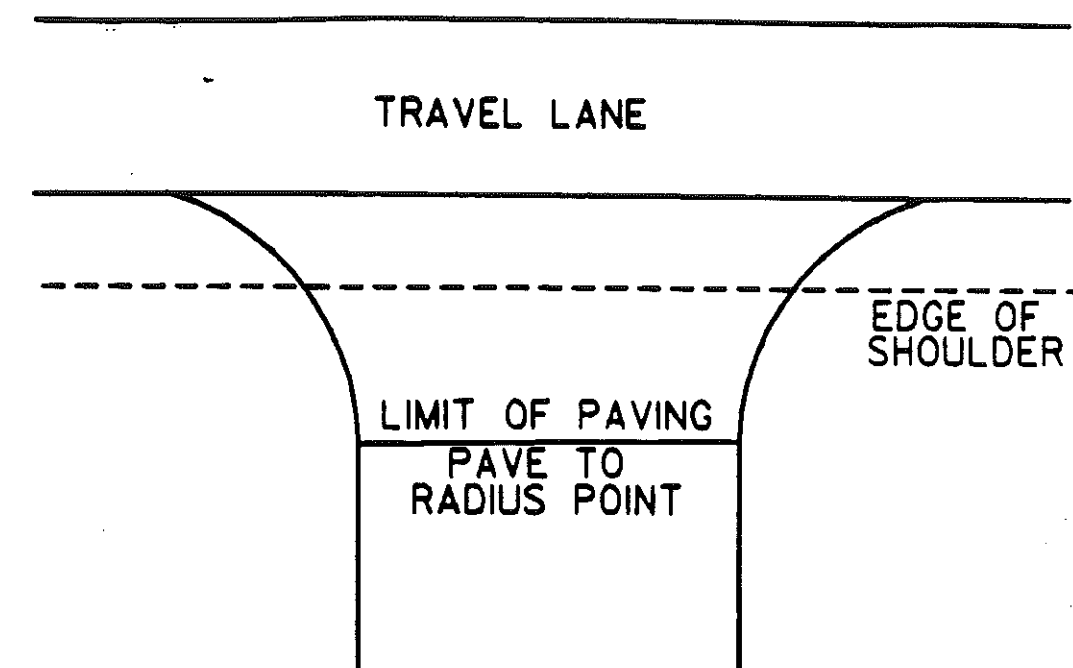