


*NOTES ARE FOUND ON PLAN SHEET 7E.

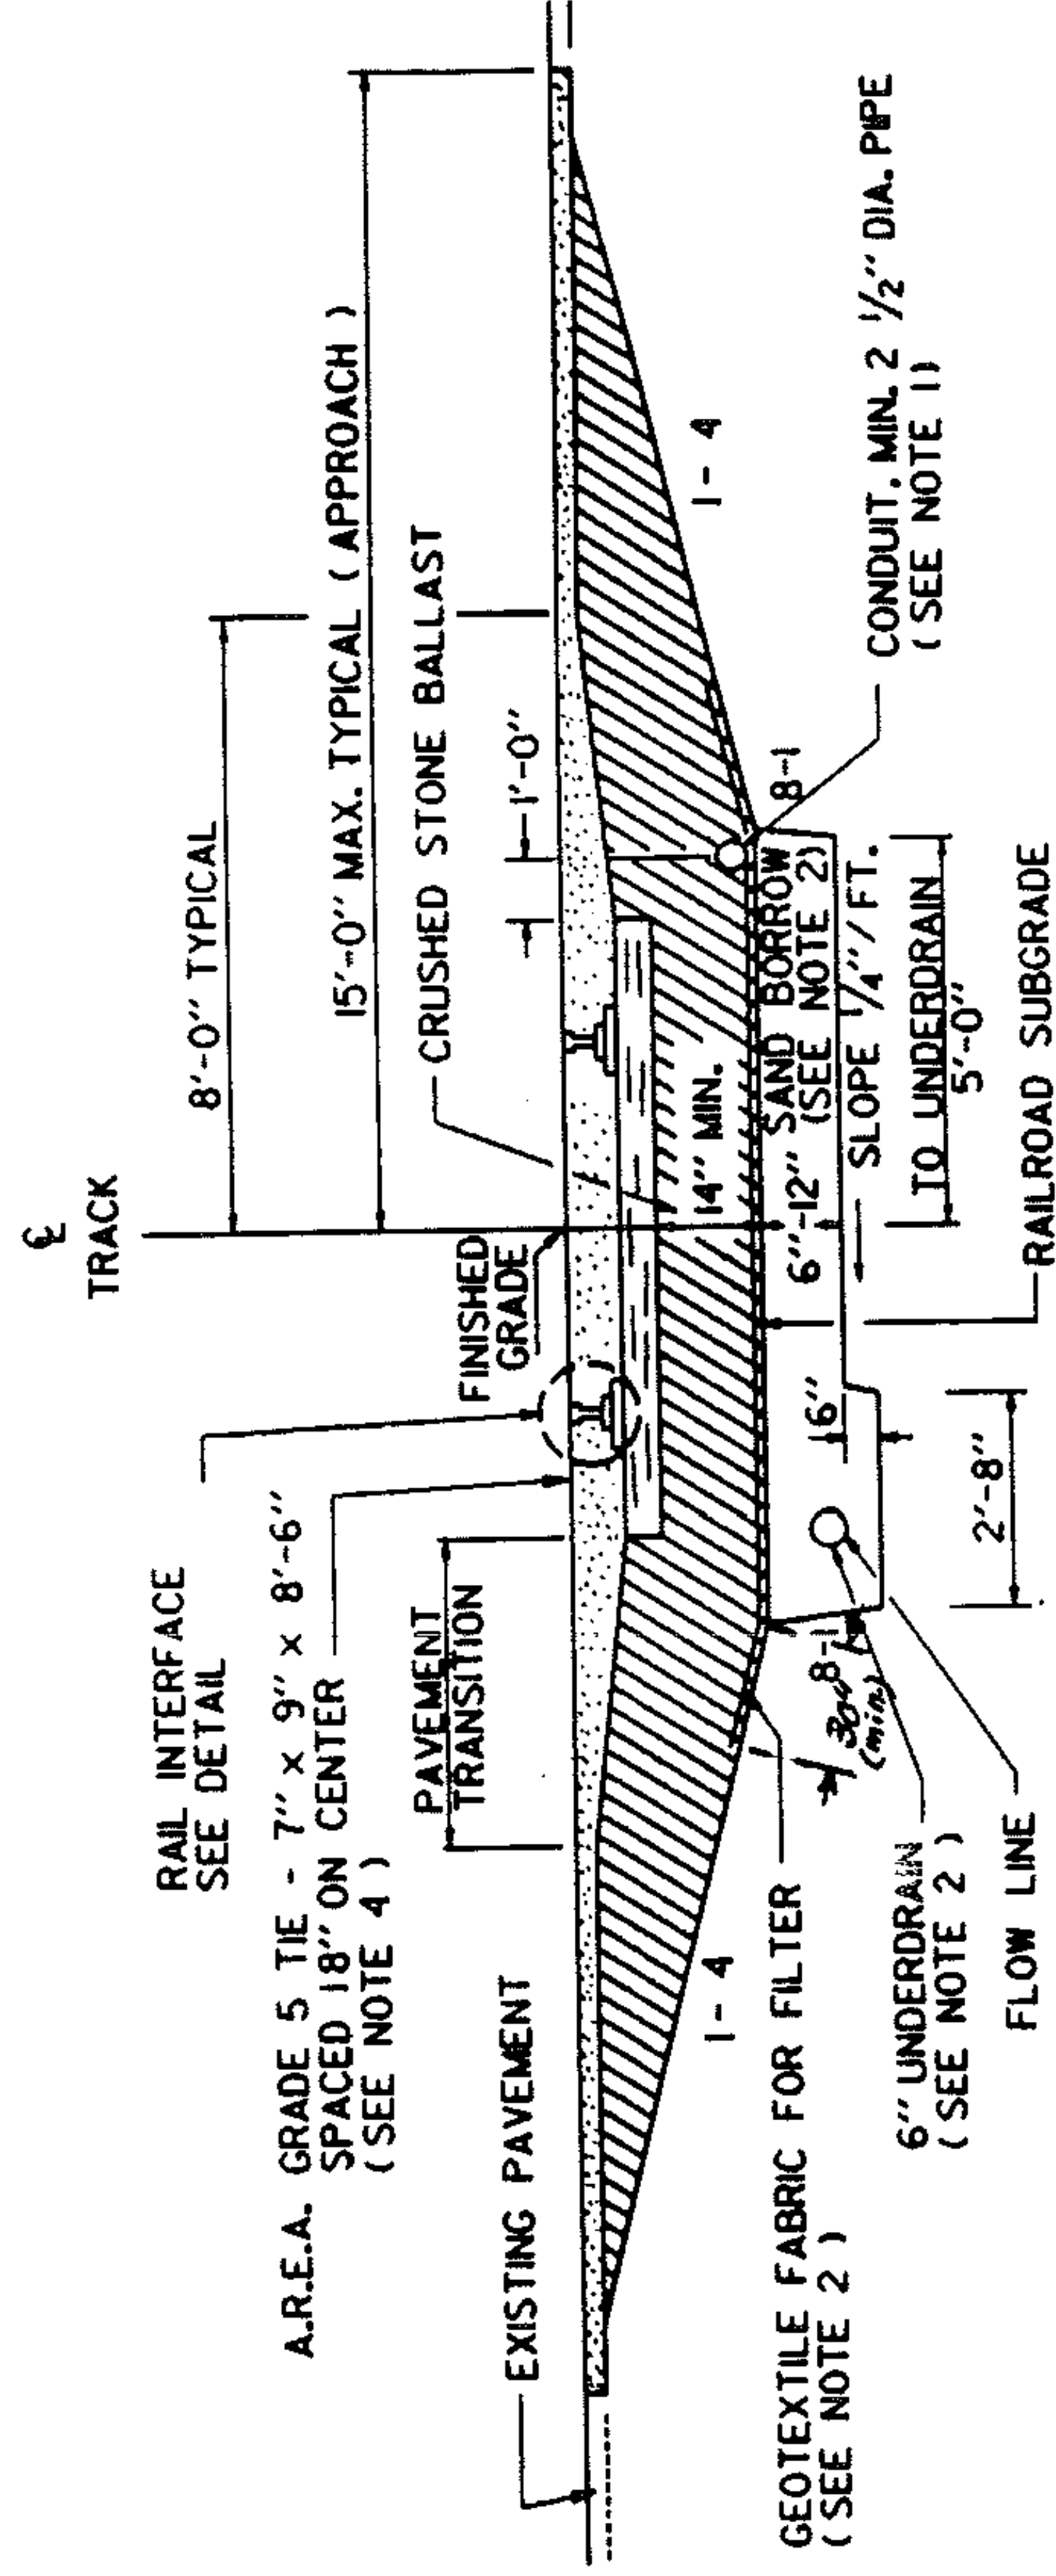

TYPICAL FOR RAILROAD CROSSING-PAVED HIGHWAY
WITH EPFLEX RAIL SEAL INTERFACE

CAVENDISH

NO. E025-1132 IS

SHEET 7 OF 33 SHEETS