


GORE MARKING DETAIL
NOT TO SCALE

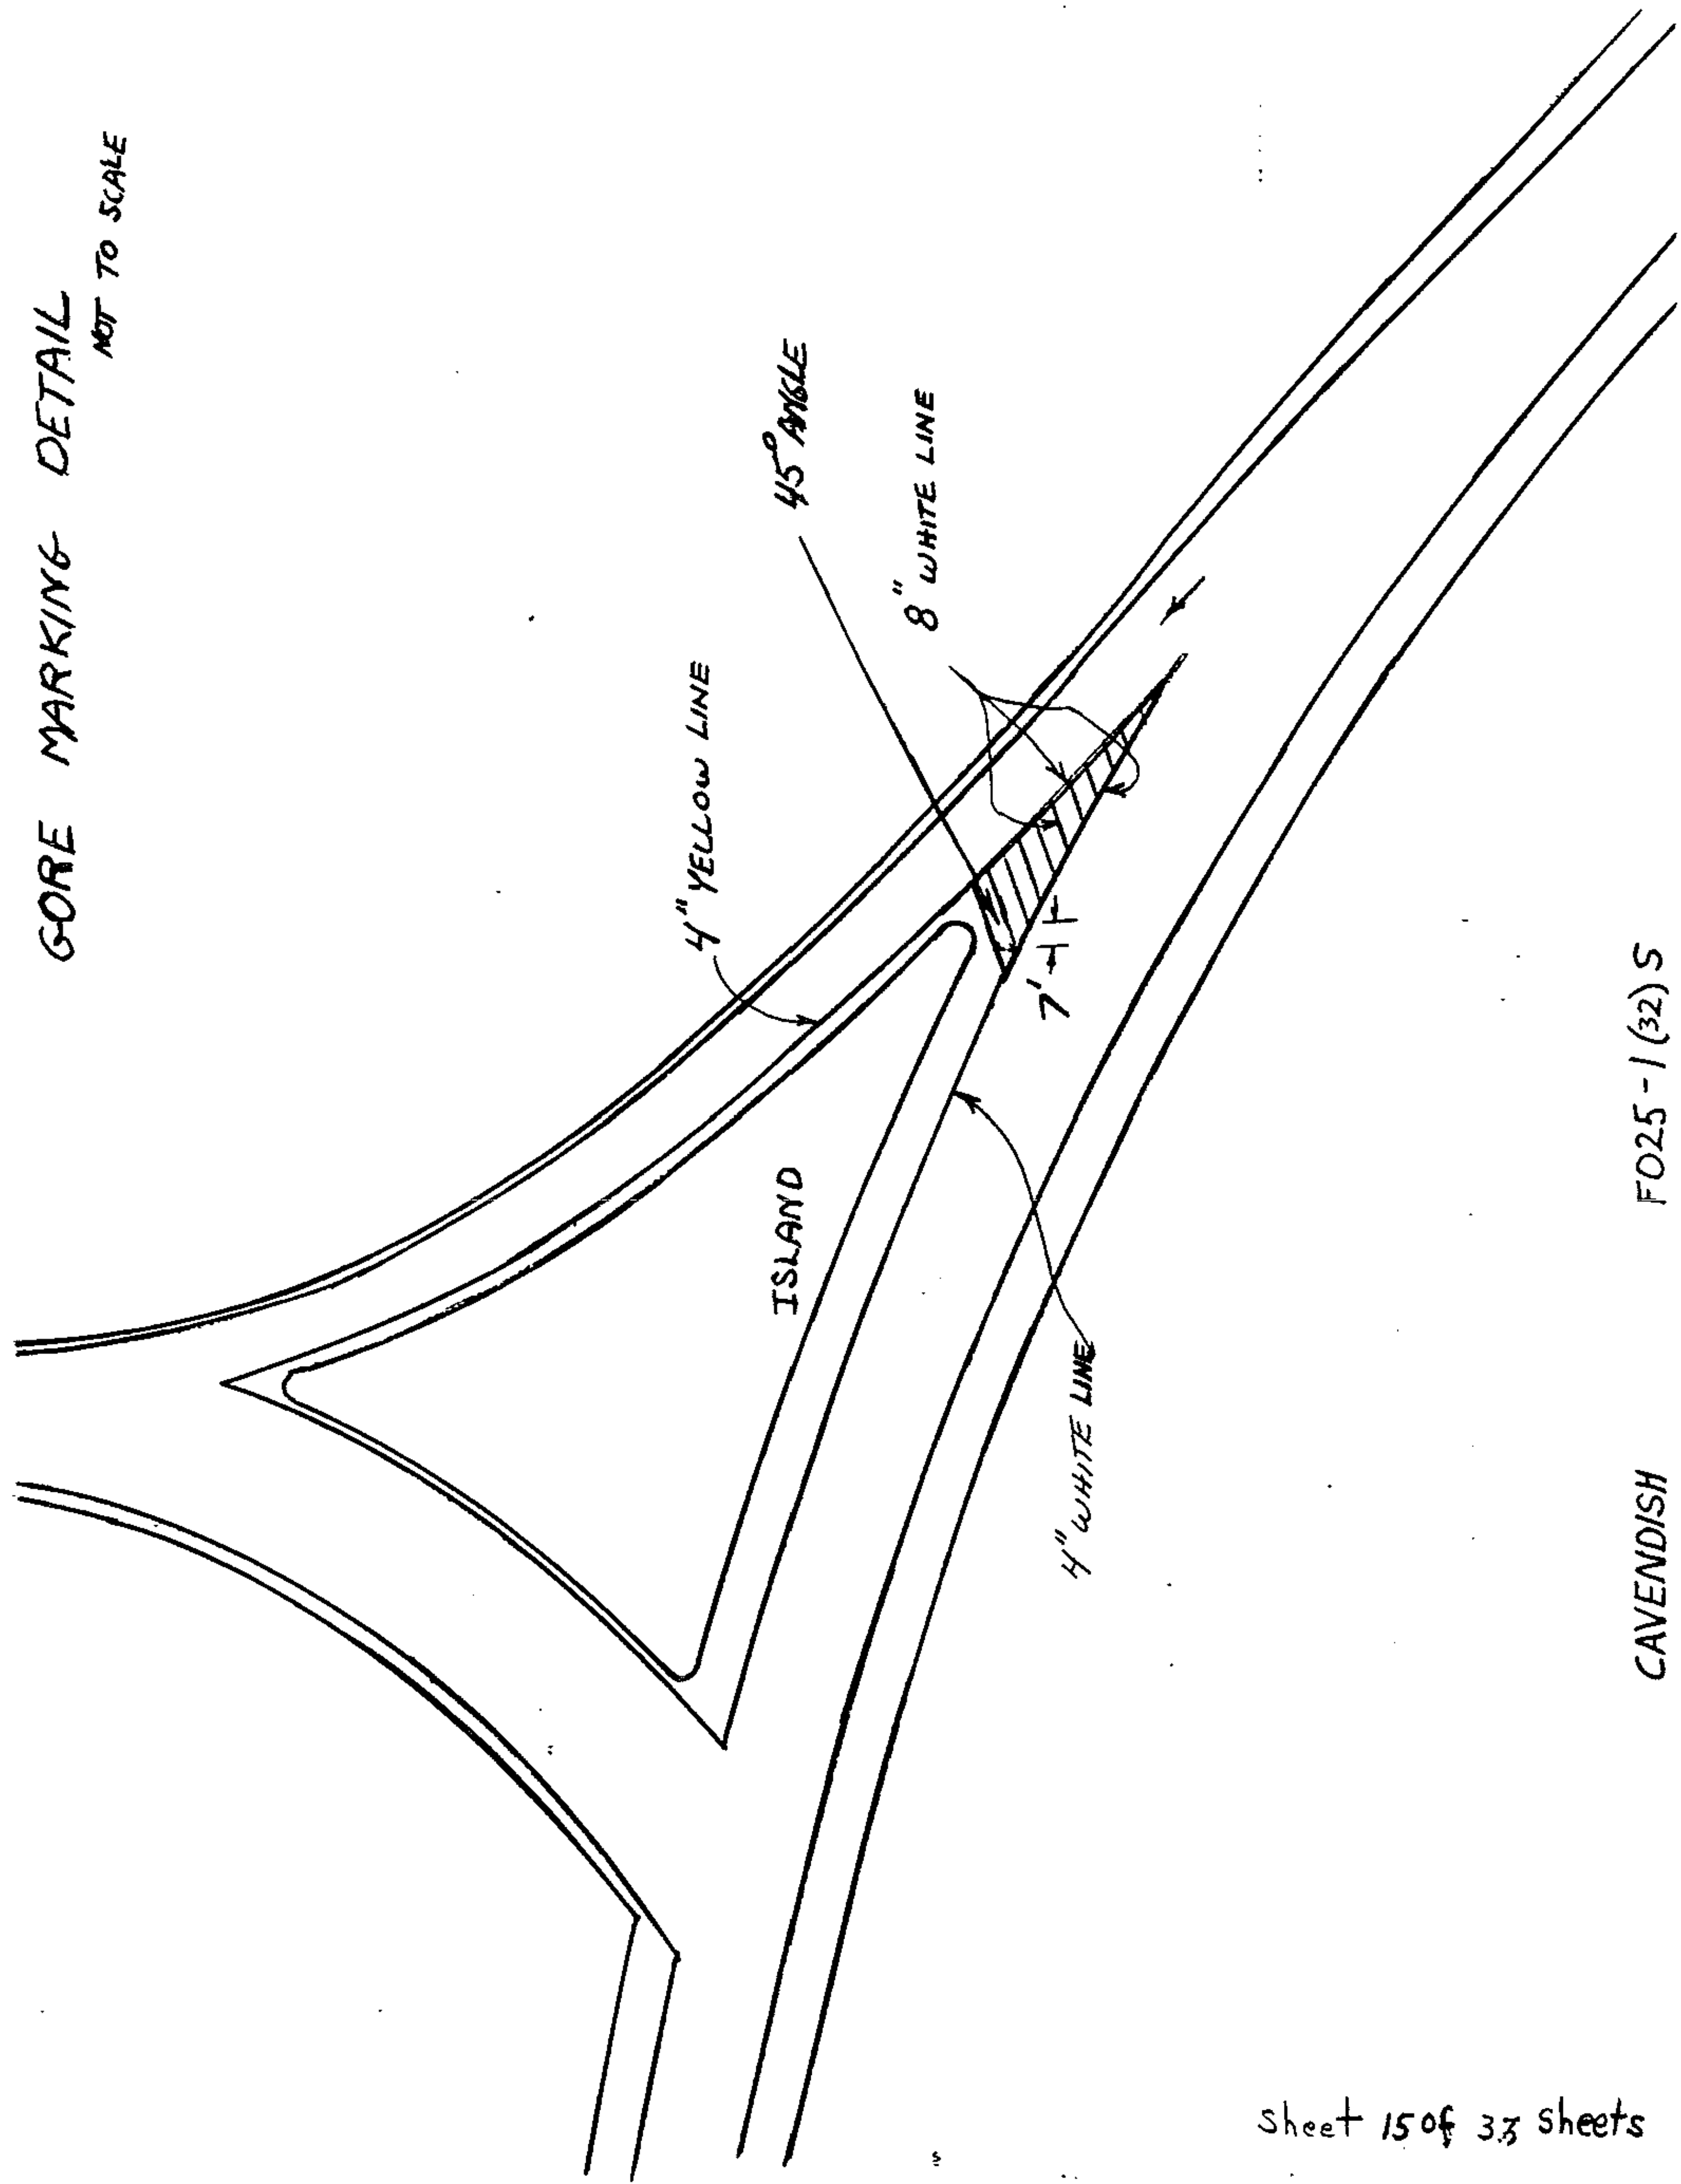

CAVENDISH

FO25-1(32)S