


AHEAD

NOTE:
SEE STANDARD E-191
FOR LETTERING DETAIL.

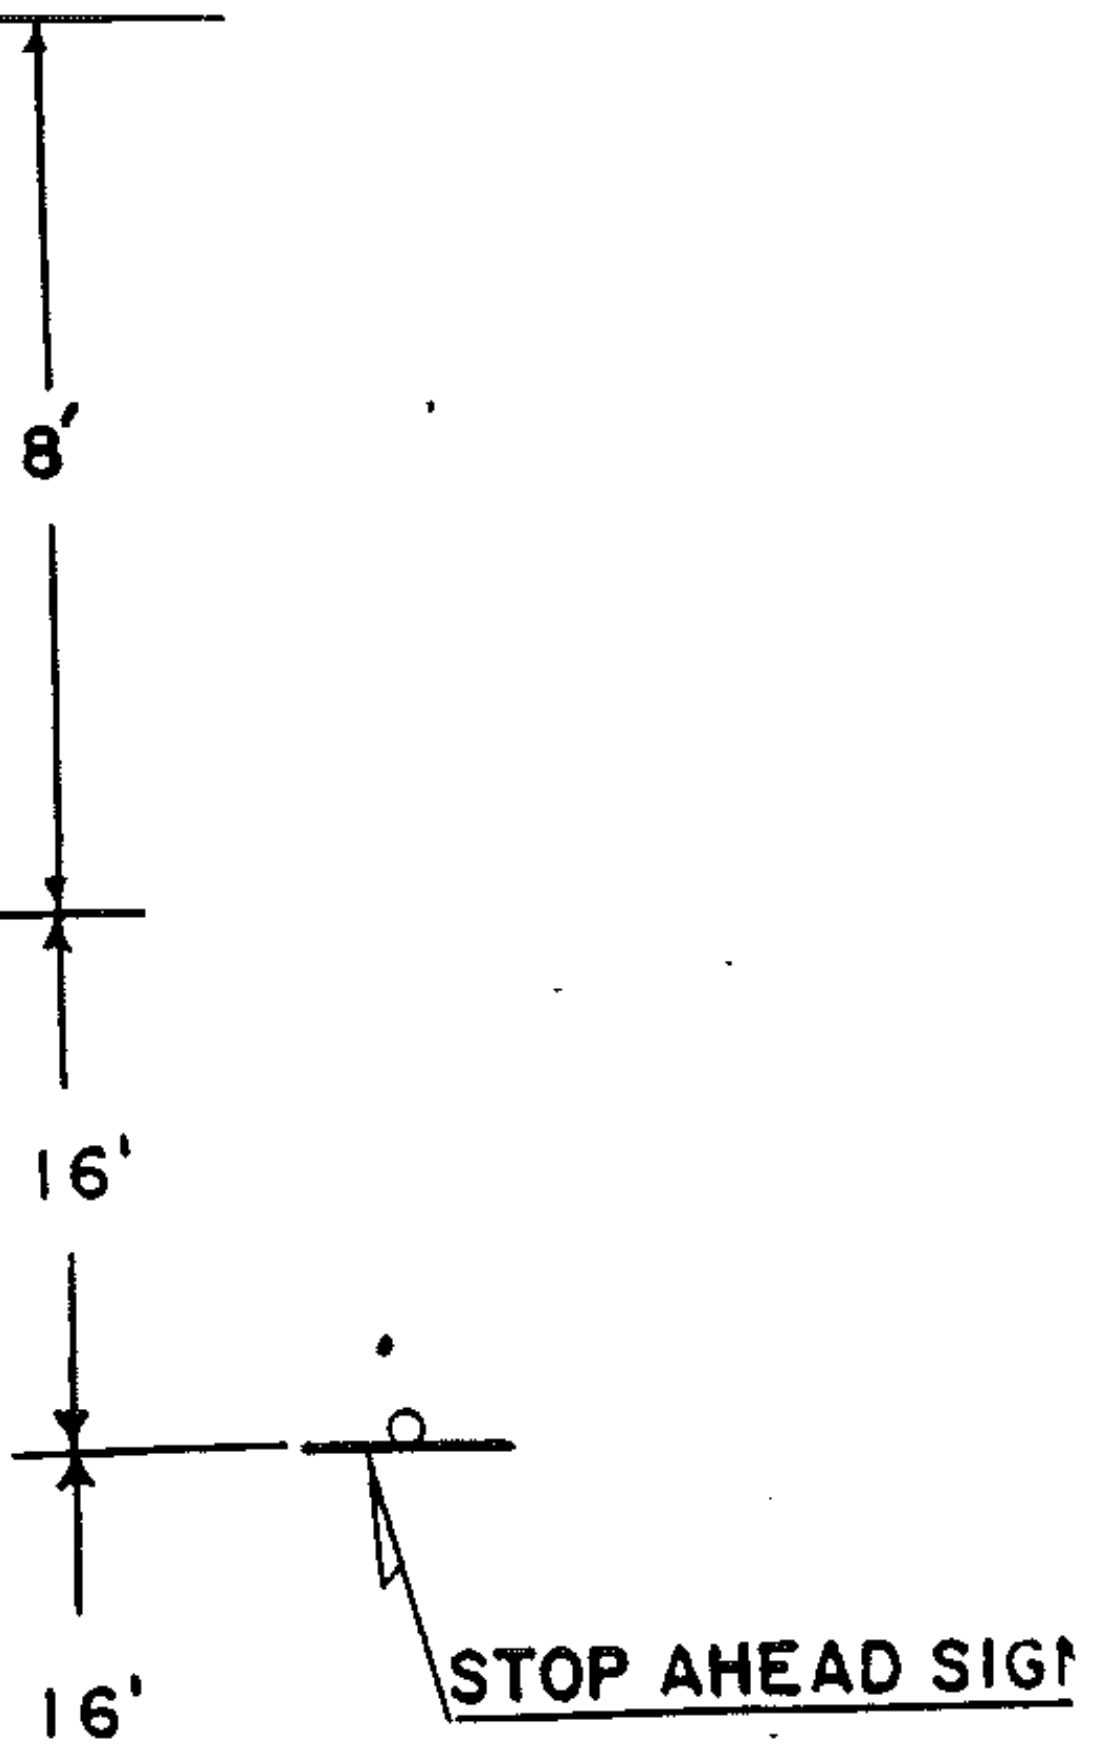

STOP

WORD MARKING LAYOUT DETAIL