


DESCRIPTION AND LOCATION

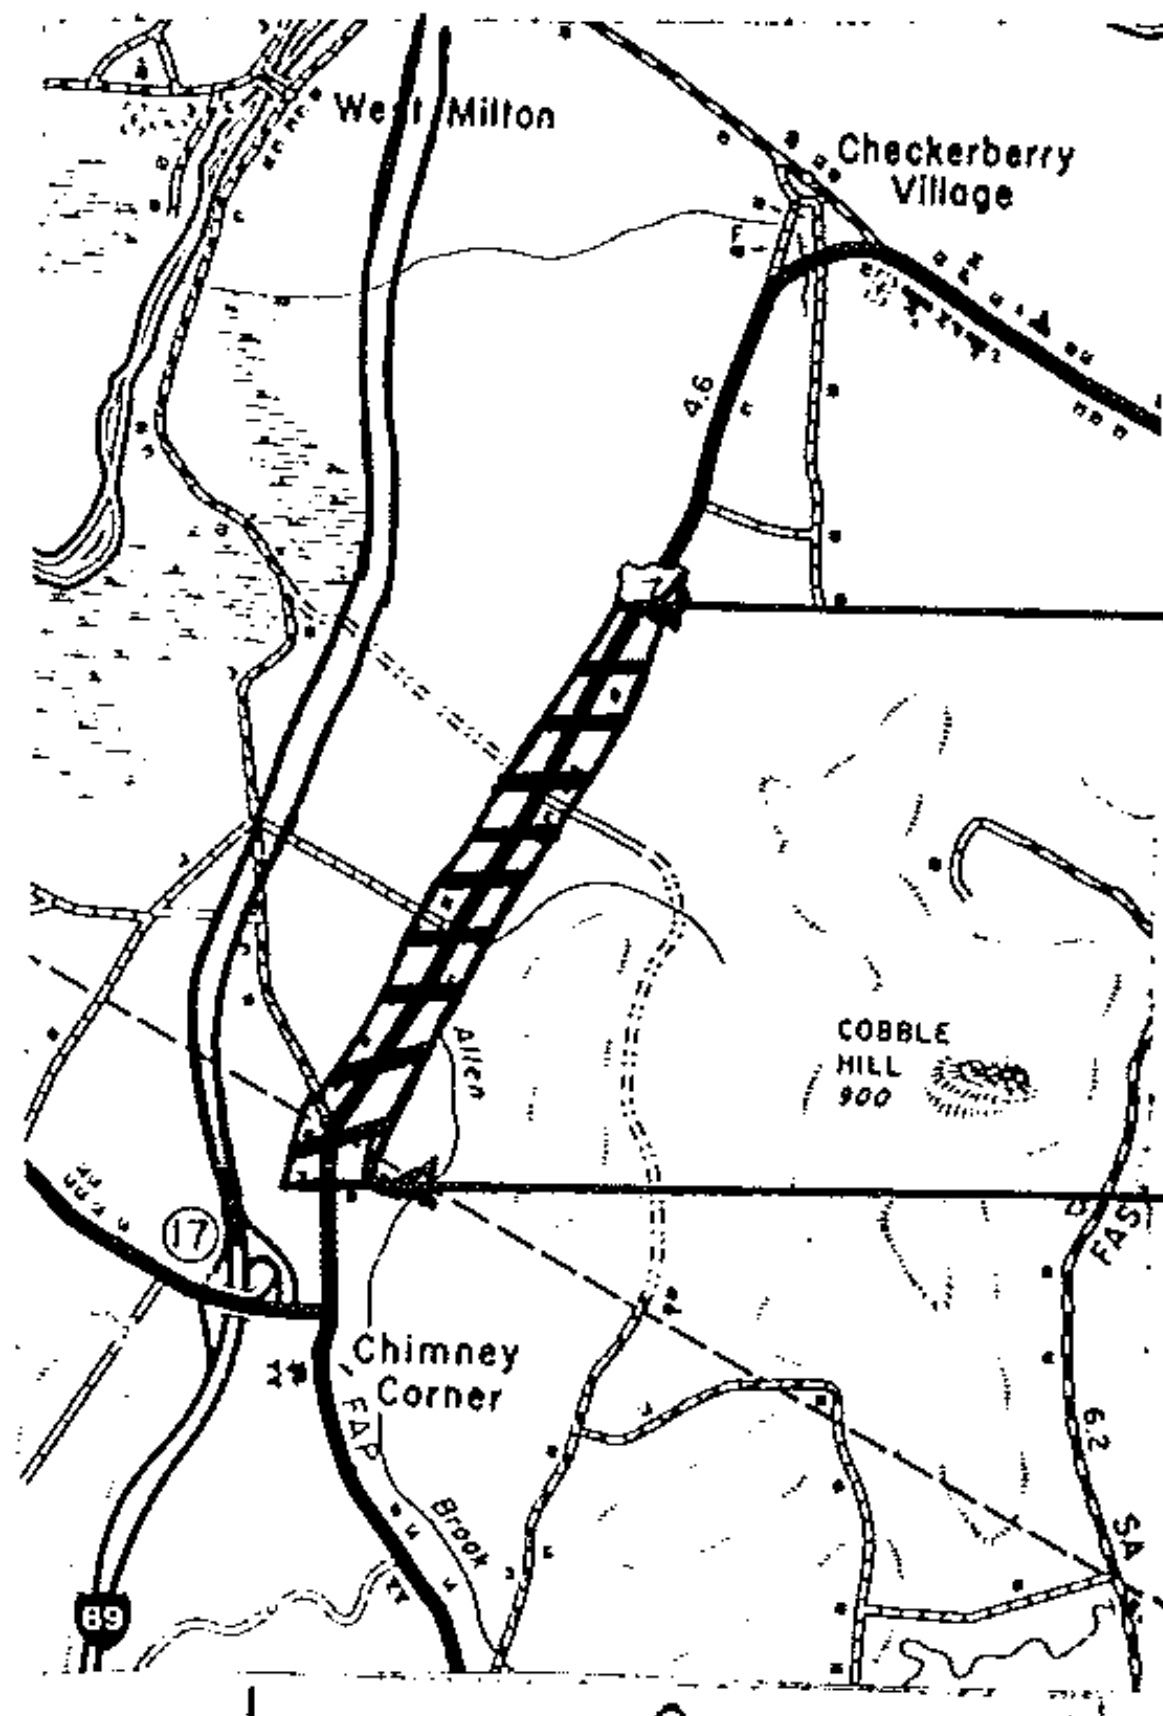

END PROJECT
MM 1.446

BEGIN PROJECT
MM 6.853

MILTON — — — T/L
COLCHESTER

1 INCH REPRESENTS 1 MILE

BEGINNING IN THE TOWN OF COLCHESTER AT
MM 6.853 AND EXTENDING NORTHERLY 1.553 MILES
TO MM 1.446 IN THE TOWN OF MILTON. RESURFACING,
PAVEMENT MARKINGS, SIGNS AND REPLACE UNSAFE
MAILBOXES.

1986 ADT 6760

LENGTH OF PROJECT: 1.553 MILES
8200 FEET

PROJECT COLCHESTER - MILTON

NO. RS 0285(11)

SHEET 3 OF 28 SHEETS