


PAVING LIMITS FOR DRIVES & TOWN ROADS

PAVING LIMITS FOR TOWN ROADS



PAVING LIMITS FOR DRIVES

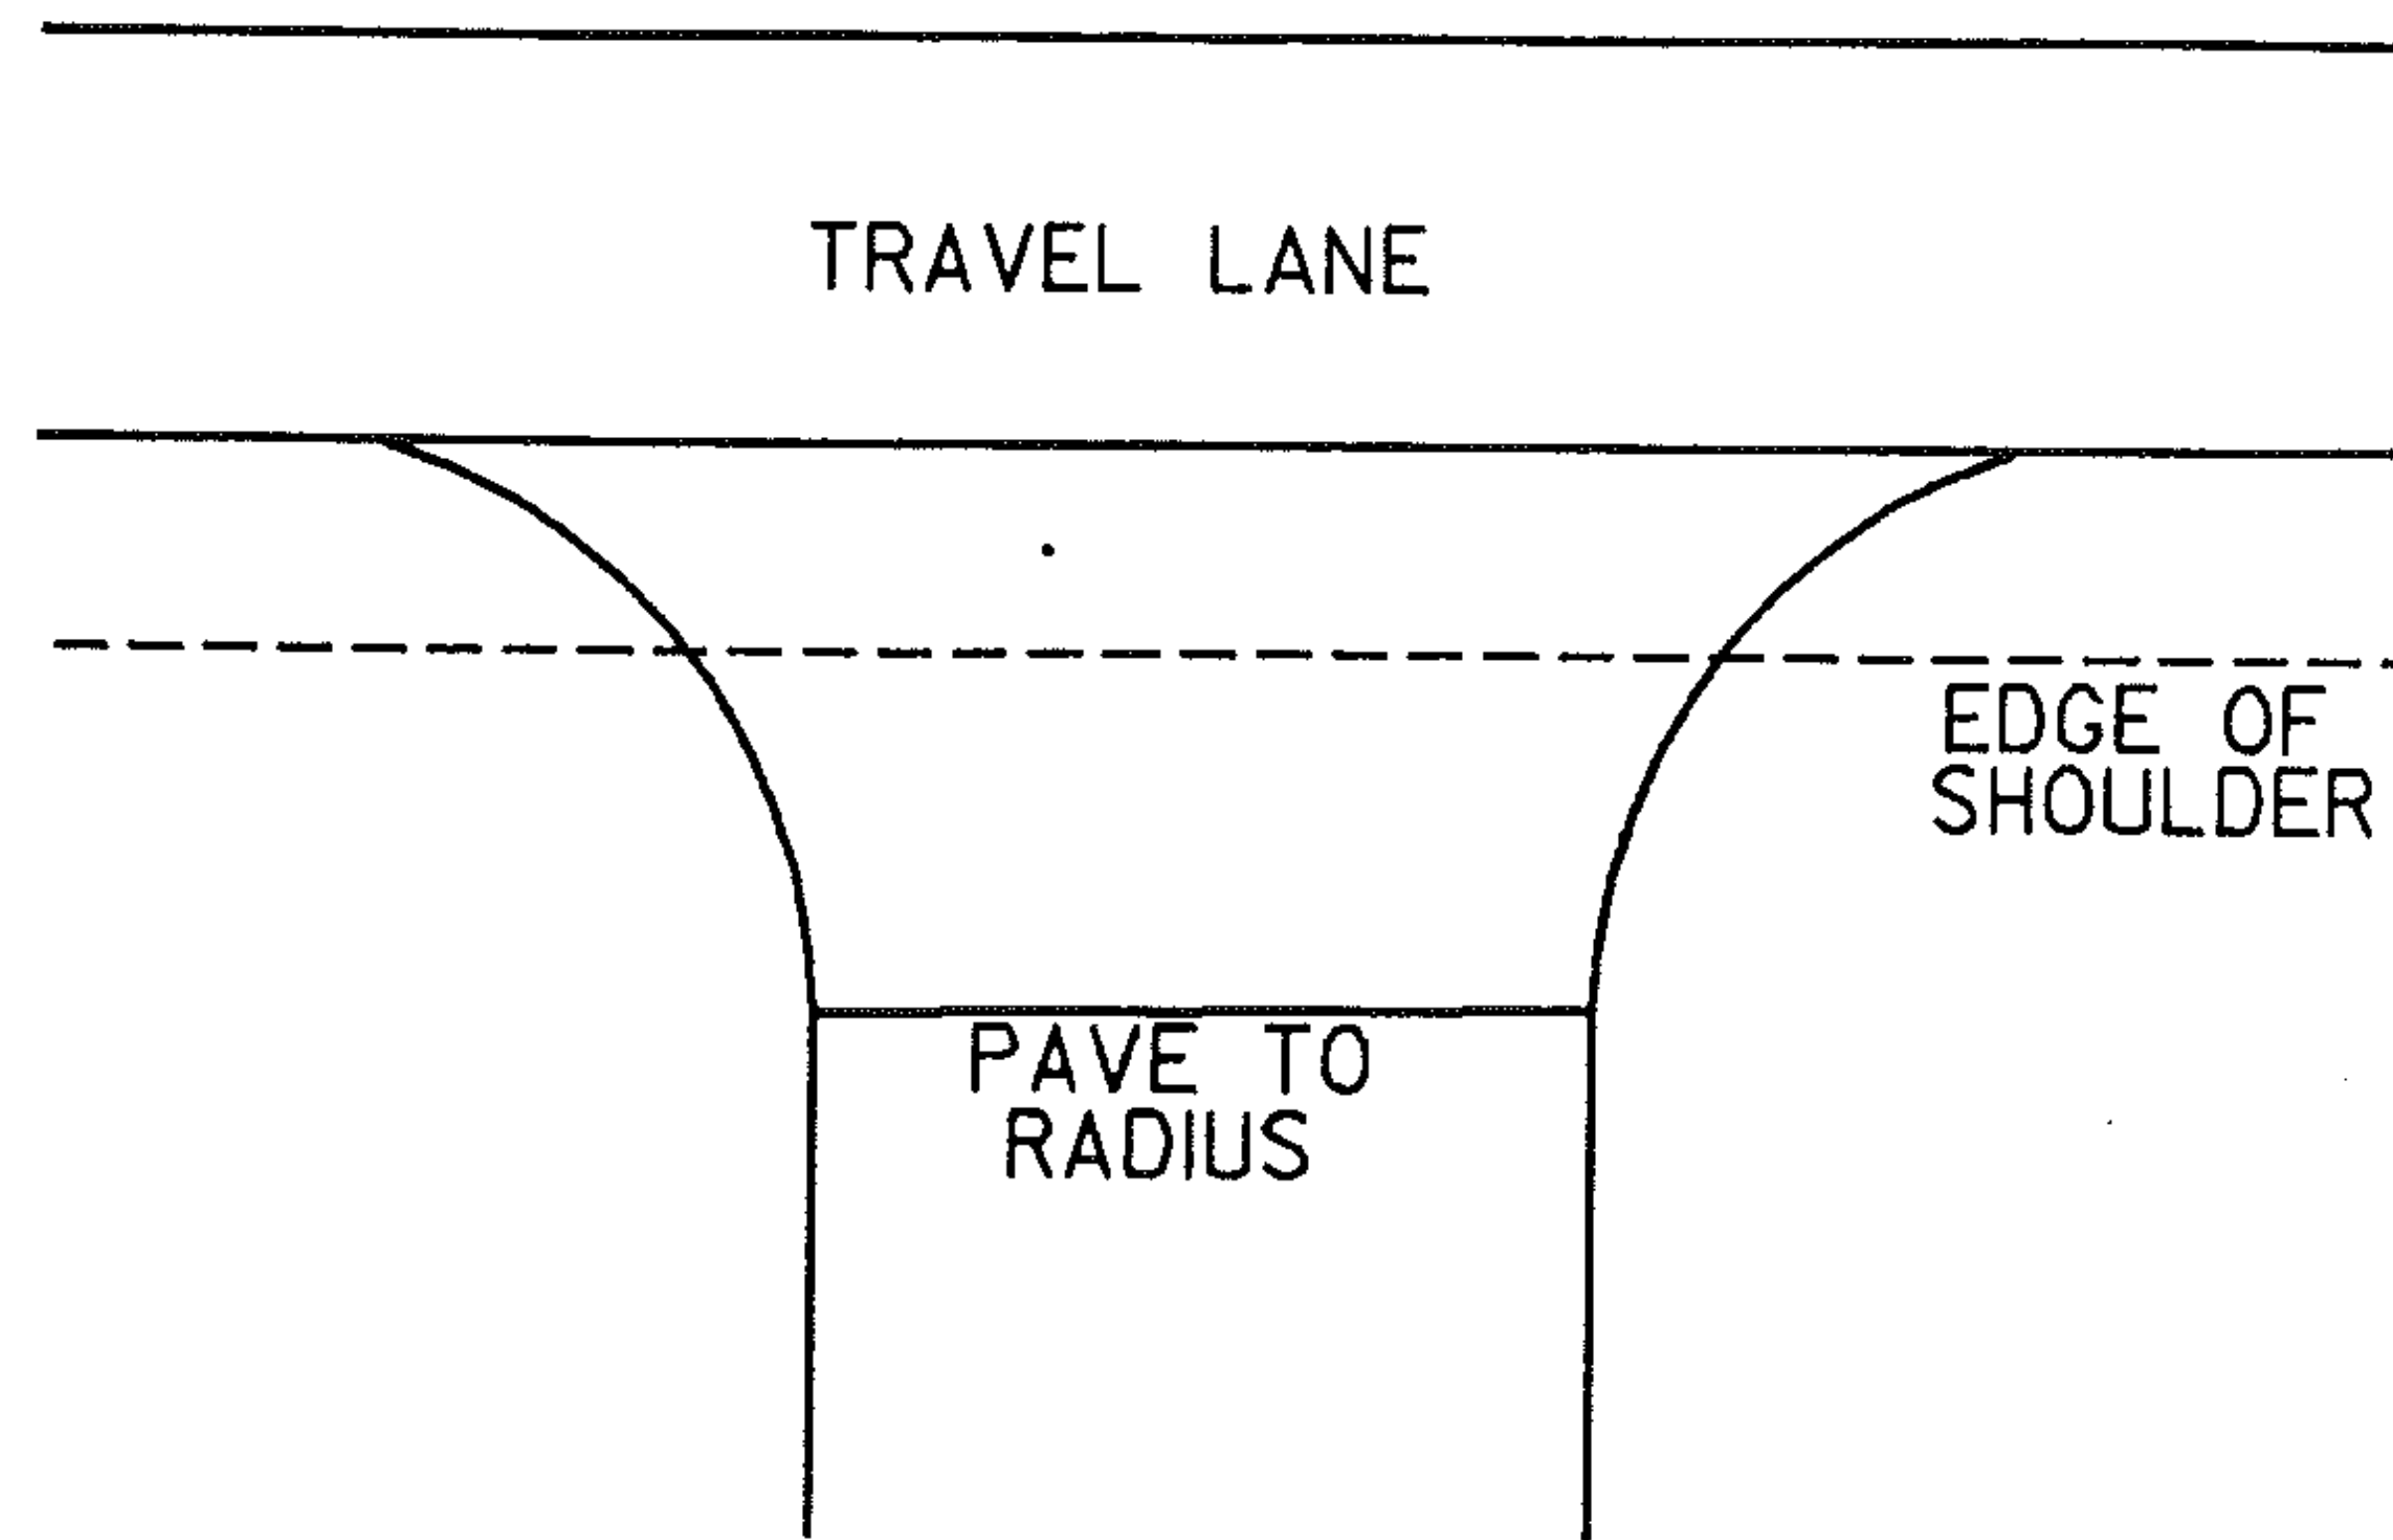