

DURABLE 4" YELLOW LINE
 160+00 E DBL. YEL. - 165+00 DBL. YEL. LT.+RT. (AS SHOWN) *
 165+00 DBL. YEL. LT.+RT. - 167+40 DBL. YEL. E (AS SHOWN) *
 168+07 DBL. YEL. LT.+RT. - 170+40 DBL. YEL. LT.+RT. (AS SHOWN) *
 170+70 DBL. YEL. LT.+RT. - 171+50 DBL. YEL. LT.+RT. (AS SHOWN) *

DURABLE 8" YELLOW LINE (DIAGS.)
 PAINTED ISLAND (AS SHOWN)
 (SEE DETAIL T.S #505)


DURABLE ARROW MARKING
 165+17 E *
 166+5 E *
 167+37 E *

DURABLE LETTER IN WORD MARKING
 165+05 E *
 166+13 E *
 167+25 E *

TEMPORARY 4" WHITE LINE
 159+00 RT. - 170+41 RT. 159+00 LT. - 167+45 LT.
 170+80 RT. - 172+00 RT. 168+40 LT. - 172+00 LT.
 165+00, 6' RT. - 167+45, 6' RT. (LANE LINE)
 167+45 - 167+75, 50' RADIUS (LANE LINE)



TEMPORARY 4" YELLOW LINE
 159+00 E - 160+00 E
 165+00 E - 167+43 E
 171+50 E - 172+00 E

DURABLE 4" WHITE LINE
 165+00 ~ 167+45, 6' RT. (LANE LINE)
 167+45 ~ 167+75, 50' R. (LANE LINE)

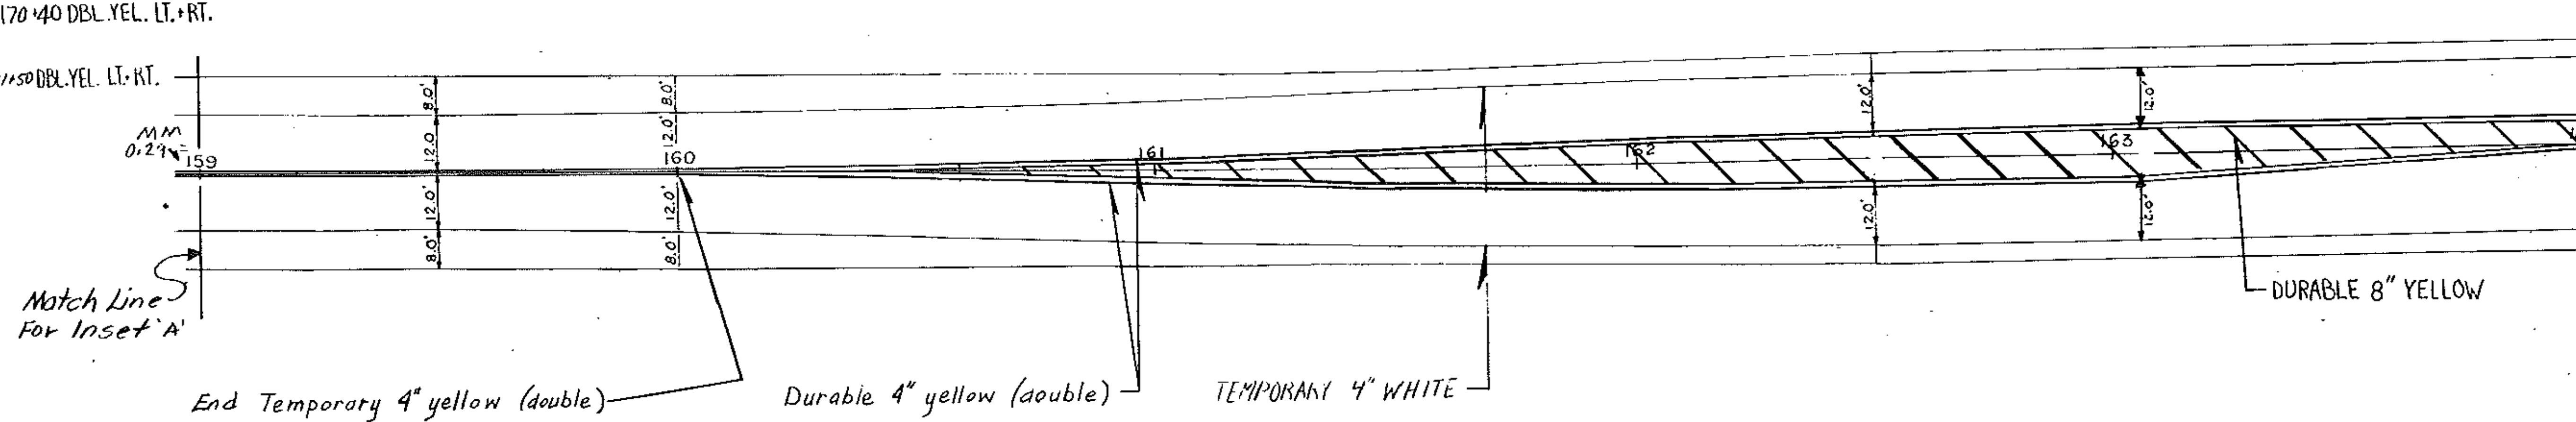

* INDICATES PAVEMENT MARKING PLANS WHICH MUST ALSO BE APPLIED TO THE PAISE COURSE AS TEMPORARY MARKING.

NOTE: Painted Island Width Variable, Maintain 12' Lanes and Min. 4" Shoulder.

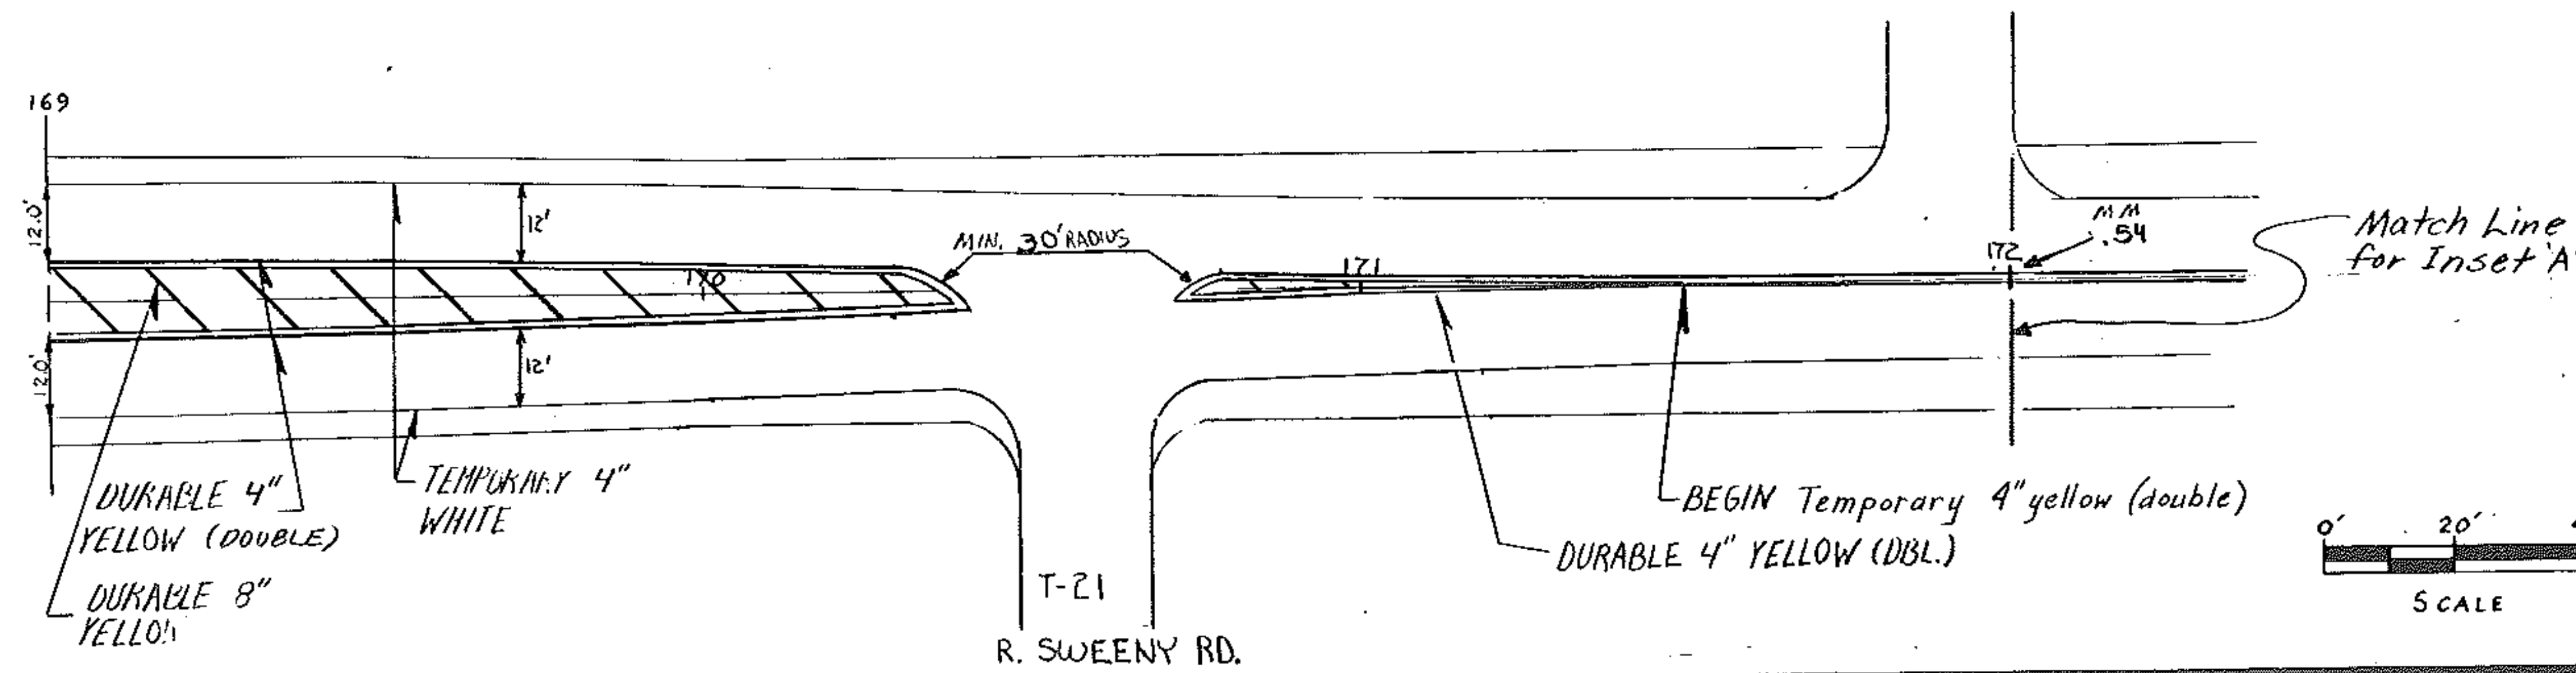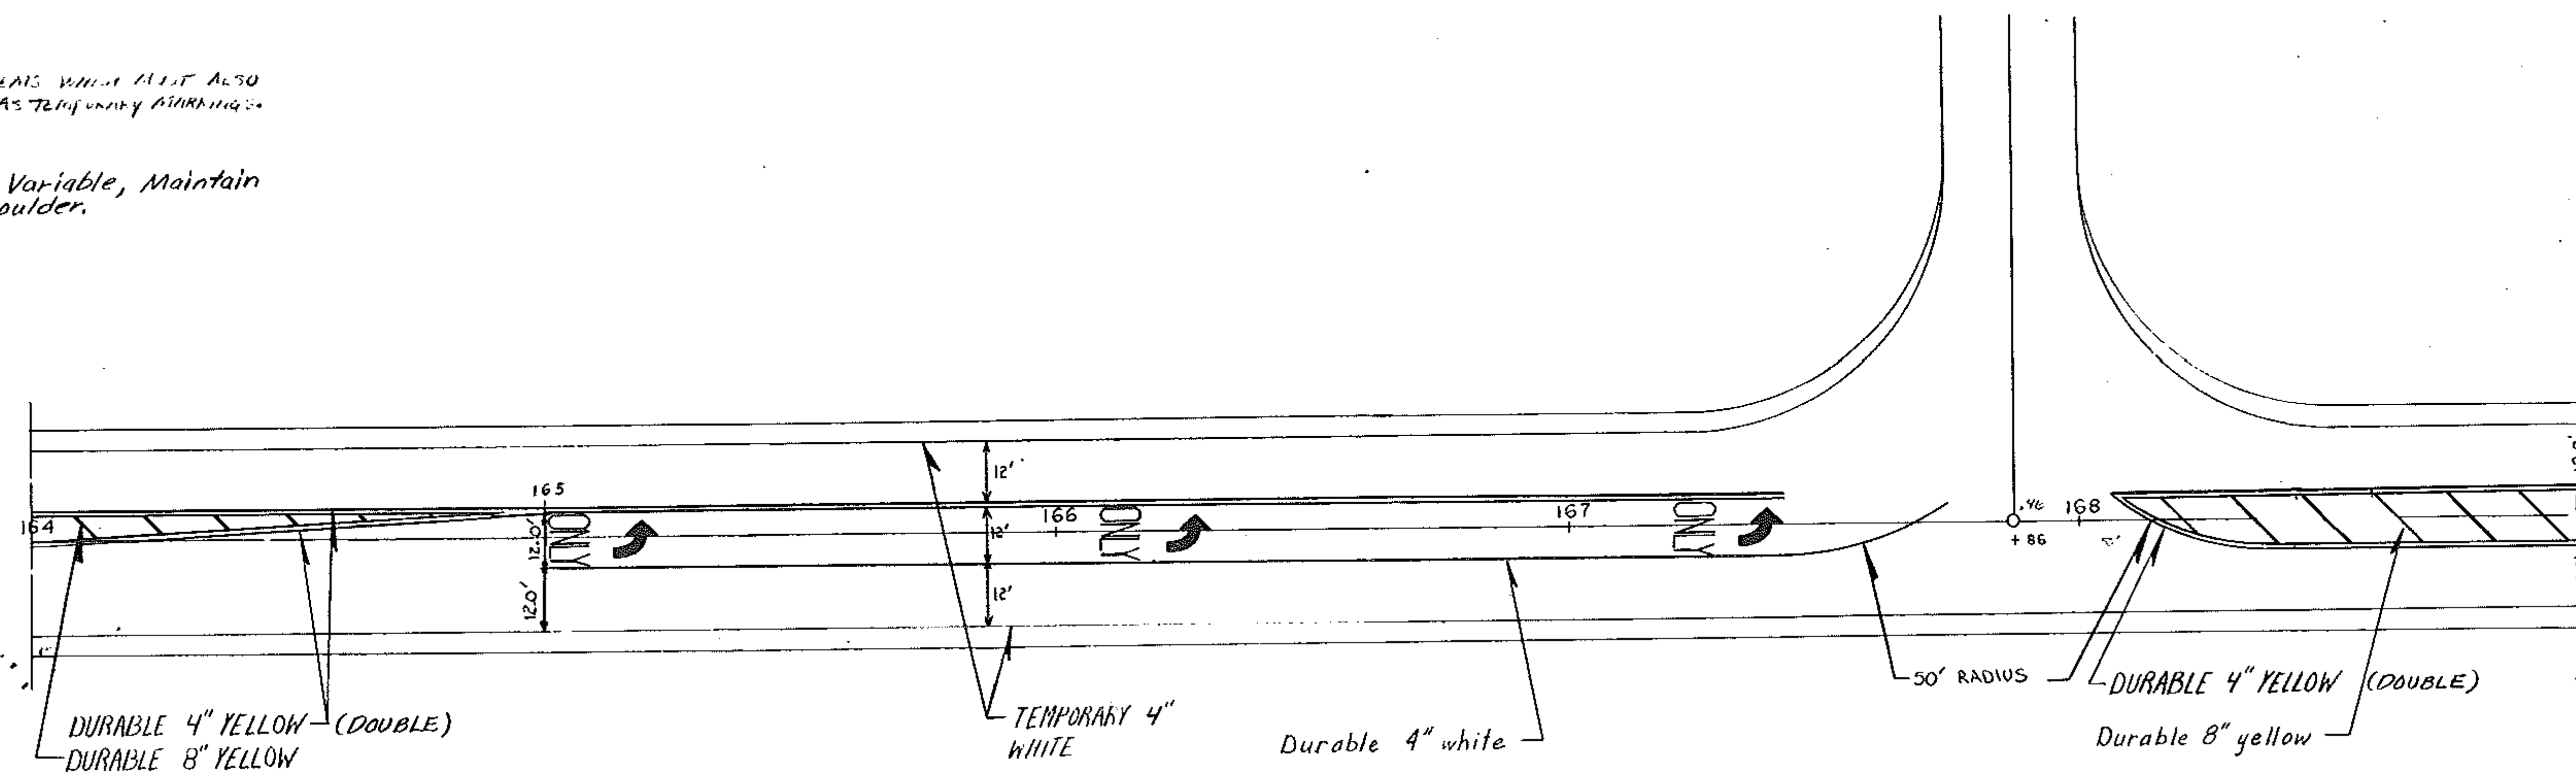

"INSET A"

PAVEMENT MARKING DETAIL SHEET

PREPARED BY LSW DATE 5/87
 CHECKED BY TB DATE 5/87
 DESIGN SUPERVISOR DBR DATE 5/87
 PROJ. COLCHESTER-MILTON RS 0285(11)
 TRAFFIC SHEET NO. 502 OF 505
 SHEET 10 OF 128 SHEETS

