
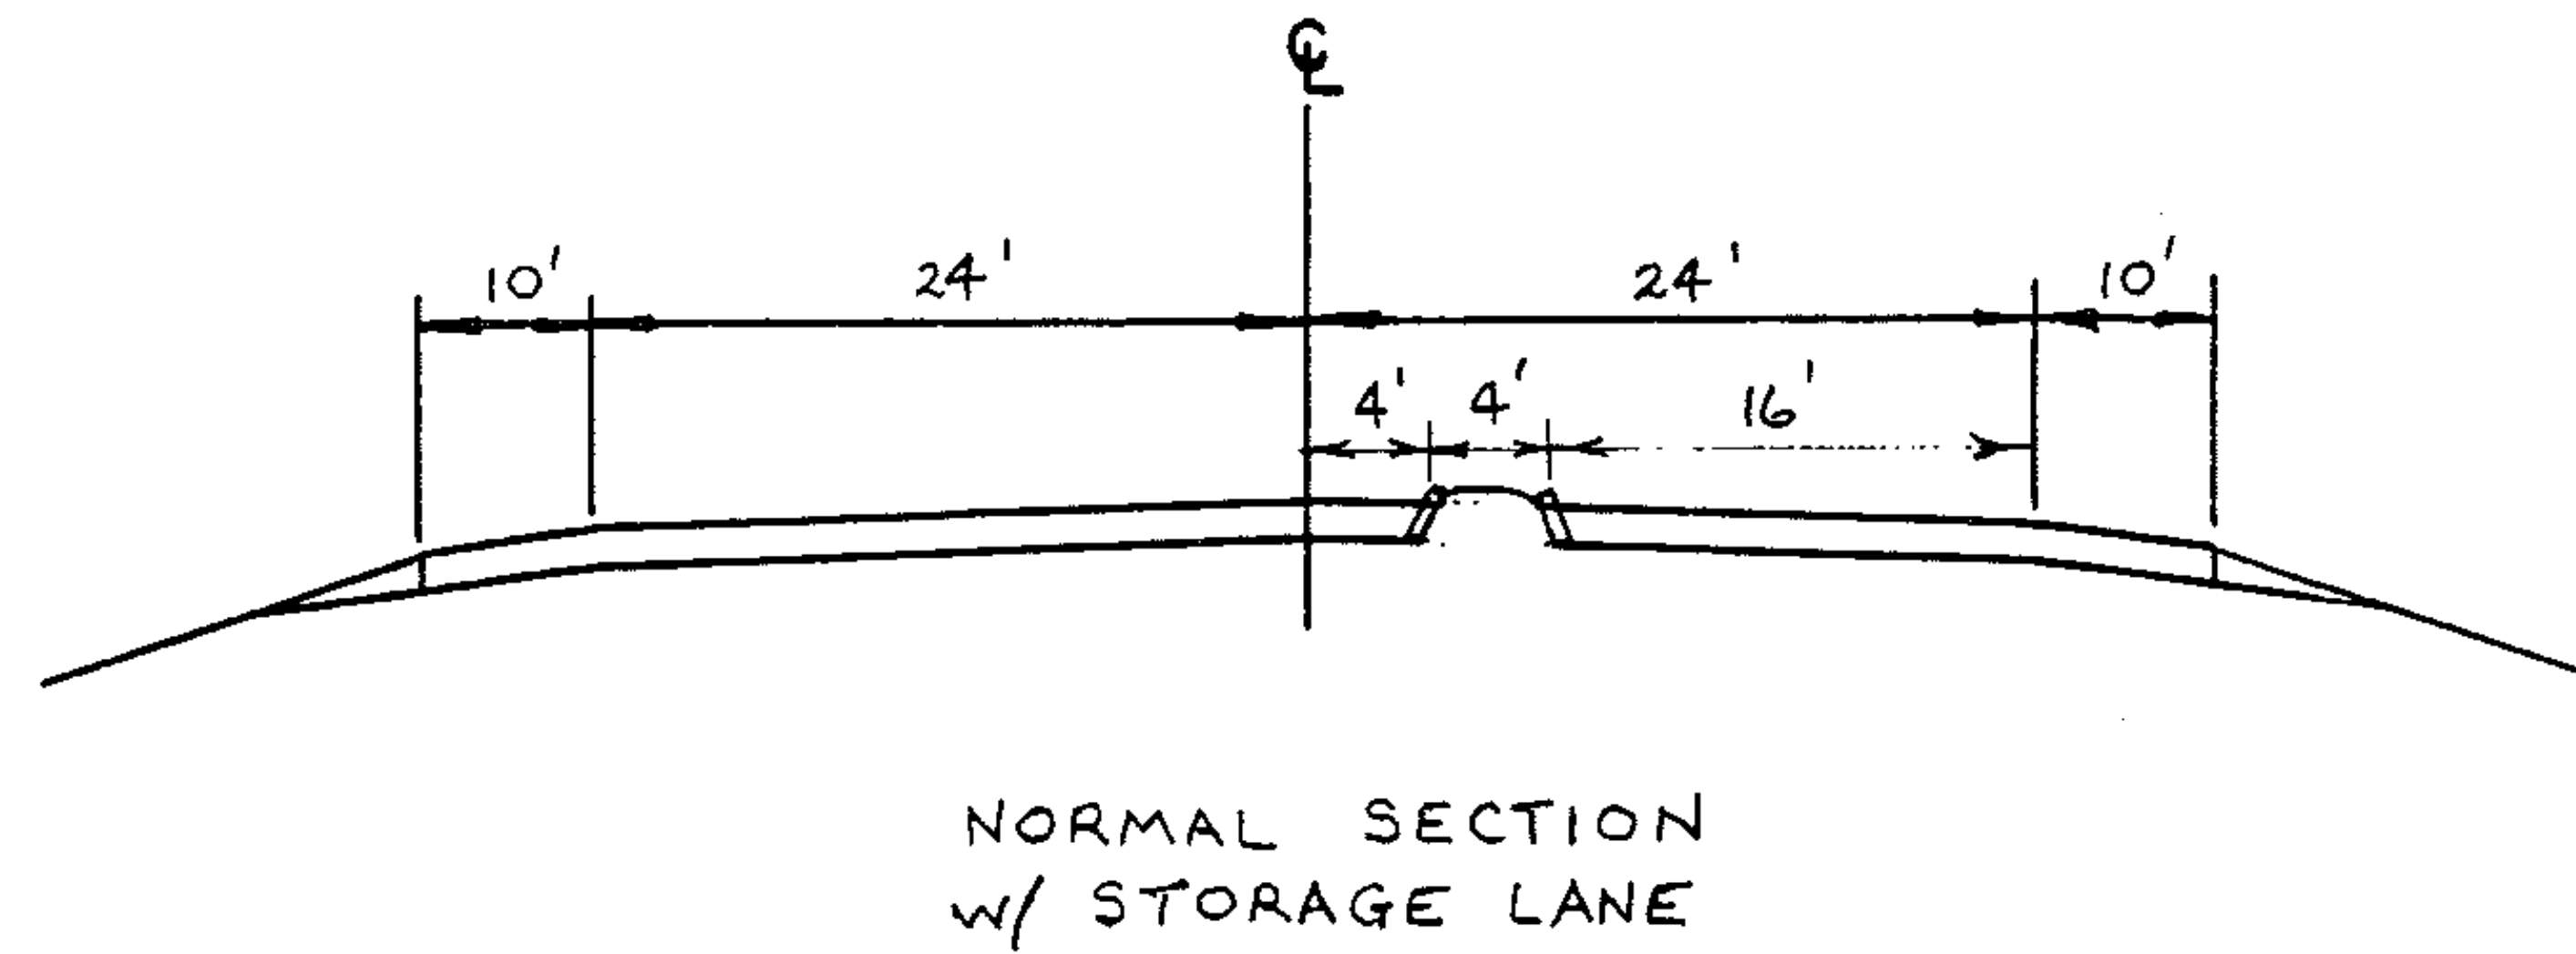


TYPICAL SECTIONS & DESIGN DATA

Item 406.25, Bit. Conc. Pavmt
 1 1/4" wearing course, Type III ($\pm 1/4"$)
 over leveling course, Type IV (250 tons/mi)

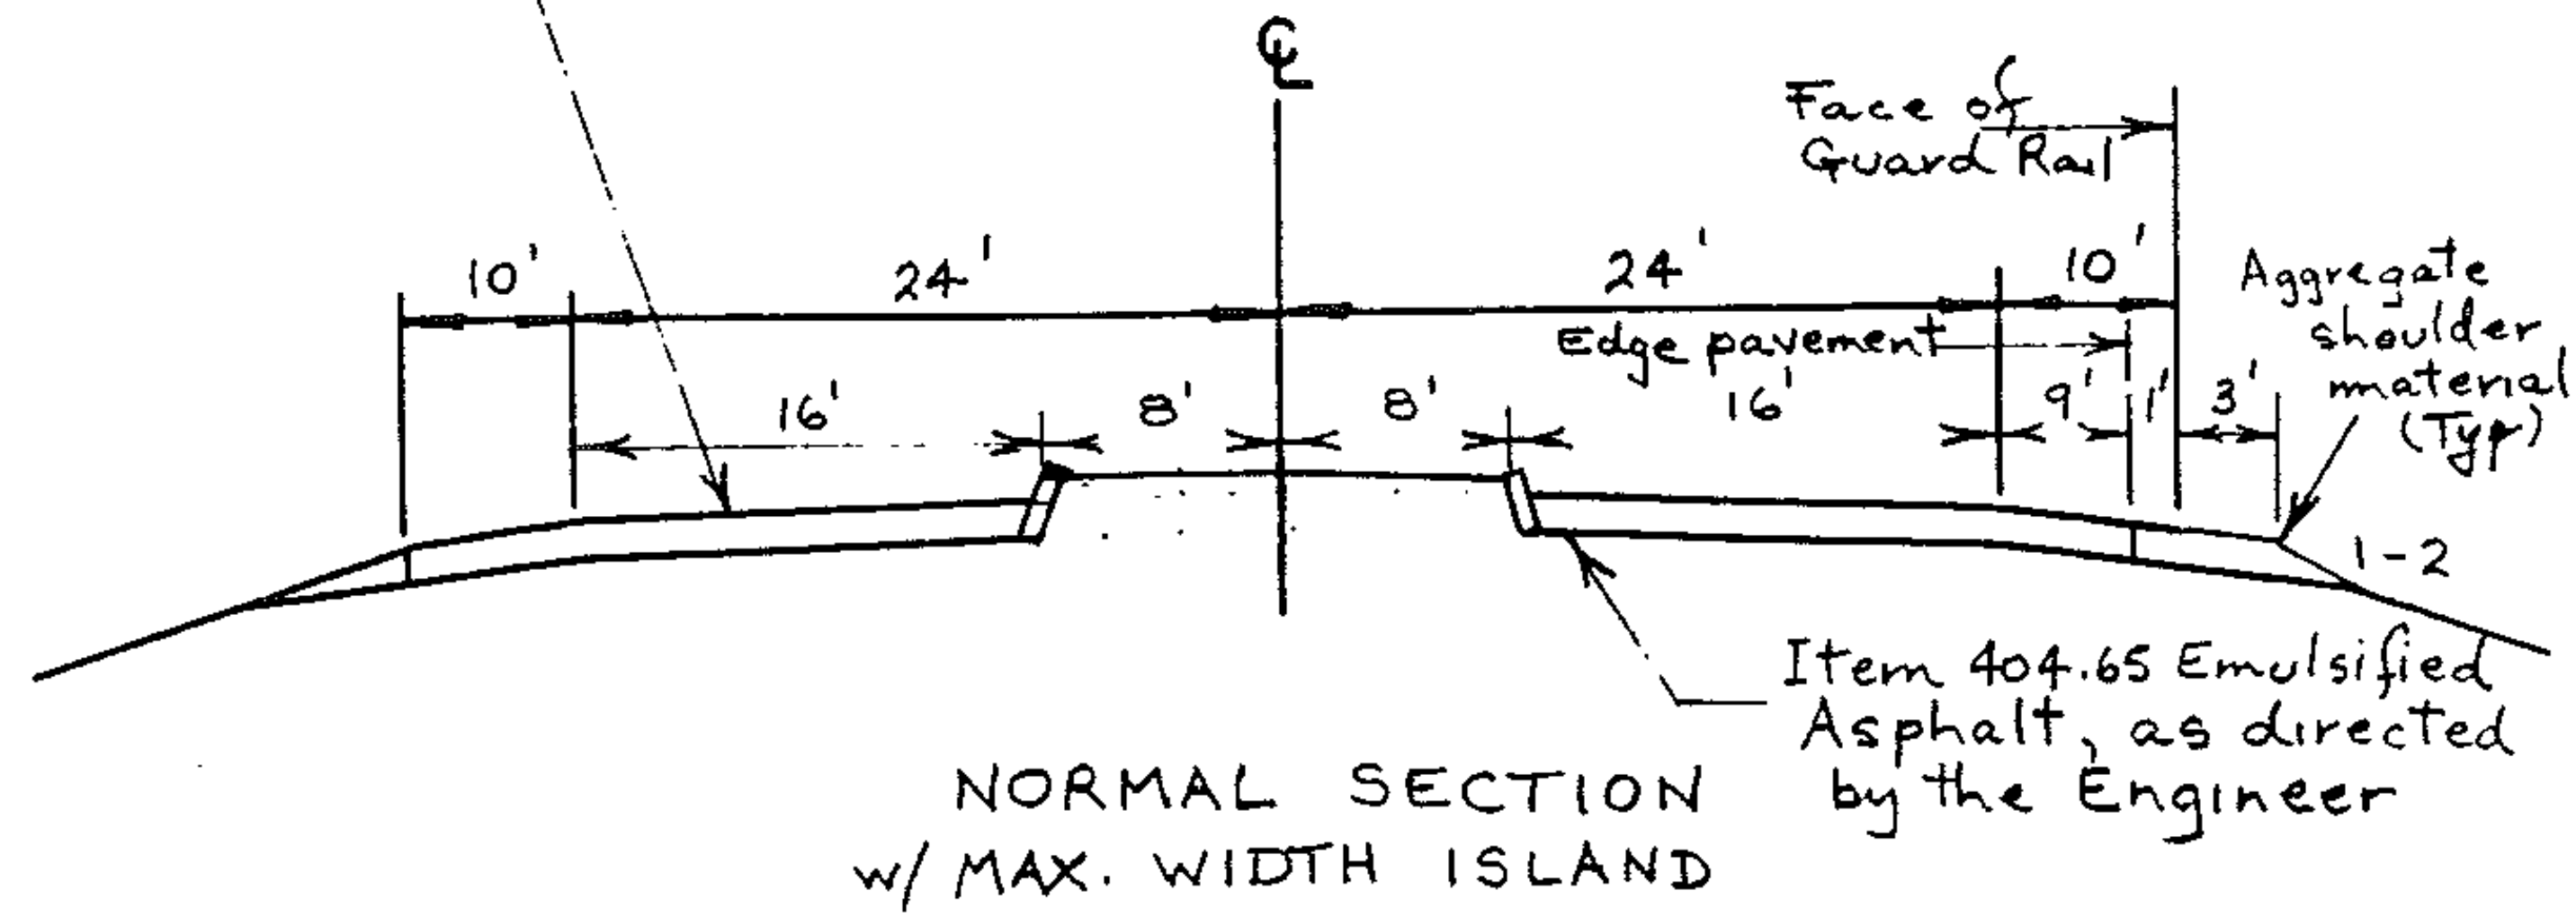

PROJECT BARTON

NO. RS 0310 (5)
 SHEET 4 OF 18