

PROJECT BARTON

NO. RS 0310 (5)
SHEET 8 OF 18 SHEETS


Item 621.80 Removal and Disposal
of
Guard Rail
Sta. 53+50 - 60+14 RT

Item 621.50 Breakaway Cable Terminal
as per Std. G-15
Sta. 53+43 - 53+68 RT

Item 621.20 Steel Beam Guard Rail
(steel posts @ 6'-3" spacing)
Sta. 53+68 - 60+12 RT

Item 621.21 Hwy Duty Steel Beam Guard Rail
(steel posts @ 6'-3" spacing)
Terminate guard rail with approach
end detail as per Std. G-1d
S.L. Sta. 1+38 - 2+63 RT

Applicable Standards : G1, G1d, G15 & G16

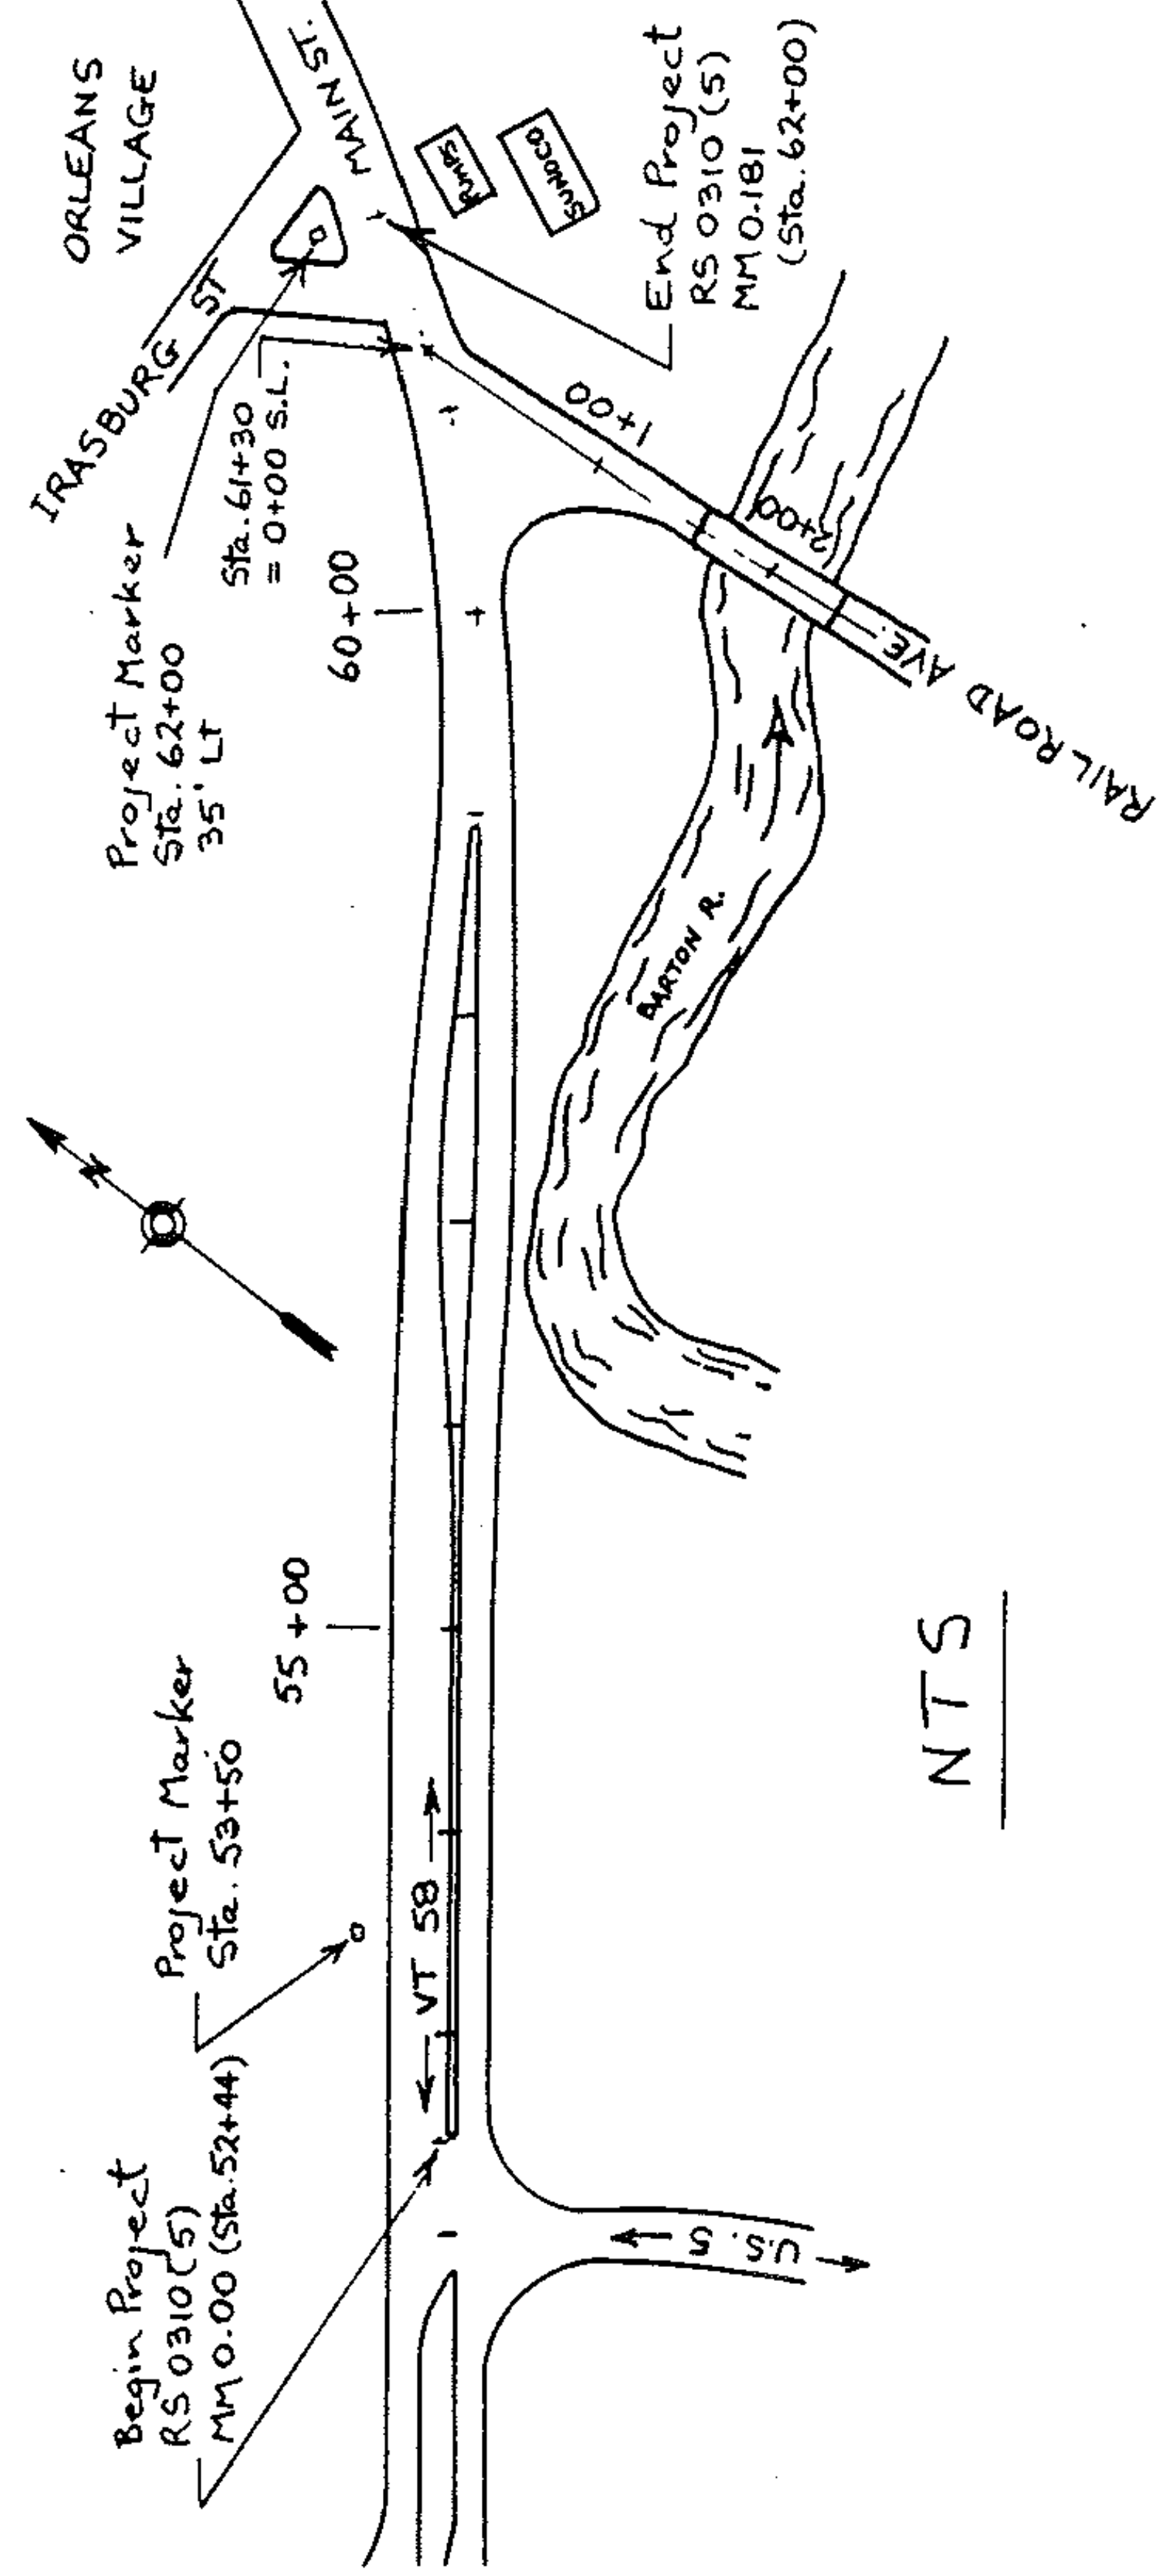

DETAILS