

# STATE OF VERMONT AGENCY OF TRANSPORTATION



## PROPOSED IMPROVEMENT BRIDGE PROJECT


TOWN OF STOWE  
COUNTY OF LAMOILLE

ROUTE NO : VT RT 108, MAJOR COLLECTOR BRIDGE NO : 2


PROJECT LOCATION: BEGINNING 0.066 MILES NORTH OF THE INTERSECTION OF VT 108 AND VT 100 AND EXTENDING 0.025 MILES NORTH ON VT 108.

PROJECT DESCRIPTION: REPLACEMENT OF EXISTING BRIDGE TO INCLUDE THE SUPERSTRUCTURE AND SUBSTRUCTURE AND APPROACH ROADWAY WORK.

LENGTH OF STRUCTURE: 131.56 FEET  
LENGTH OF ROADWAY: 0.00 FEET  
LENGTH OF PROJECT: 131.56 FEET

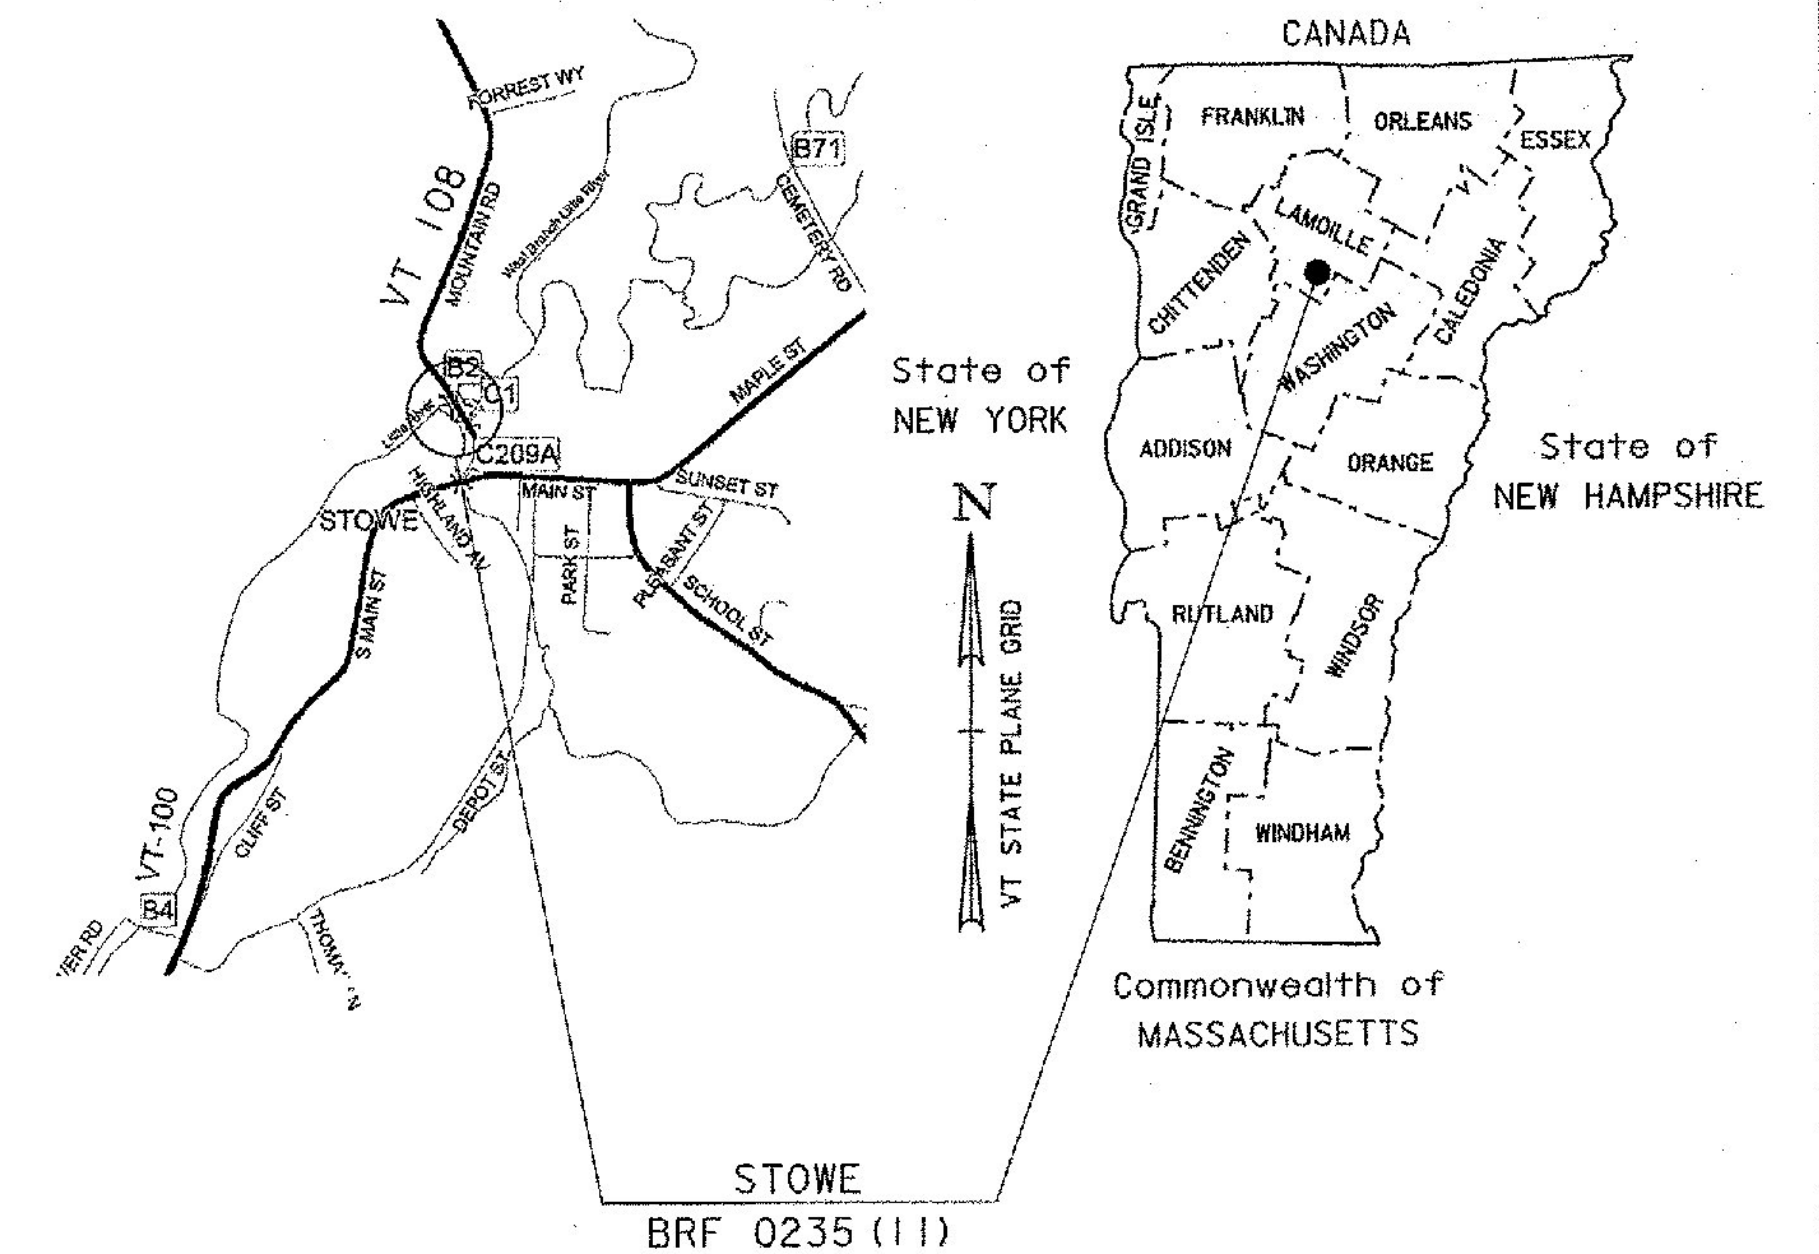


RECORD PLANS	
CONTRACTOR:	CCS CONSTRUCTORS LLC- MORRISVILLE, VT
RESIDENT ENGINEER:	BOB SUCKERT
CONSTRUCTION BEGAN:	NOVEMBER 10, 2014
CONSTRUCTION COMPLETE:	JULY 31, 2015
RECORD PLANS BY:	BOB SUCKERT & KEVIN KING
I HEREBY CERTIFY THAT ALL THE CONSTRUCTION REQUIRED BY THIS SET OF DRAWINGS HAS BEEN ACCOMPLISHED AS INDICATED HEREIN.	
BY:	<i>Bob Suckert</i> RESIDENT ENGINEER
DATE:	3-2-17
NOTE: Any further information concerning final quantities, amounts or other details relative to this project may be found at Central Files in the electronic archives.	

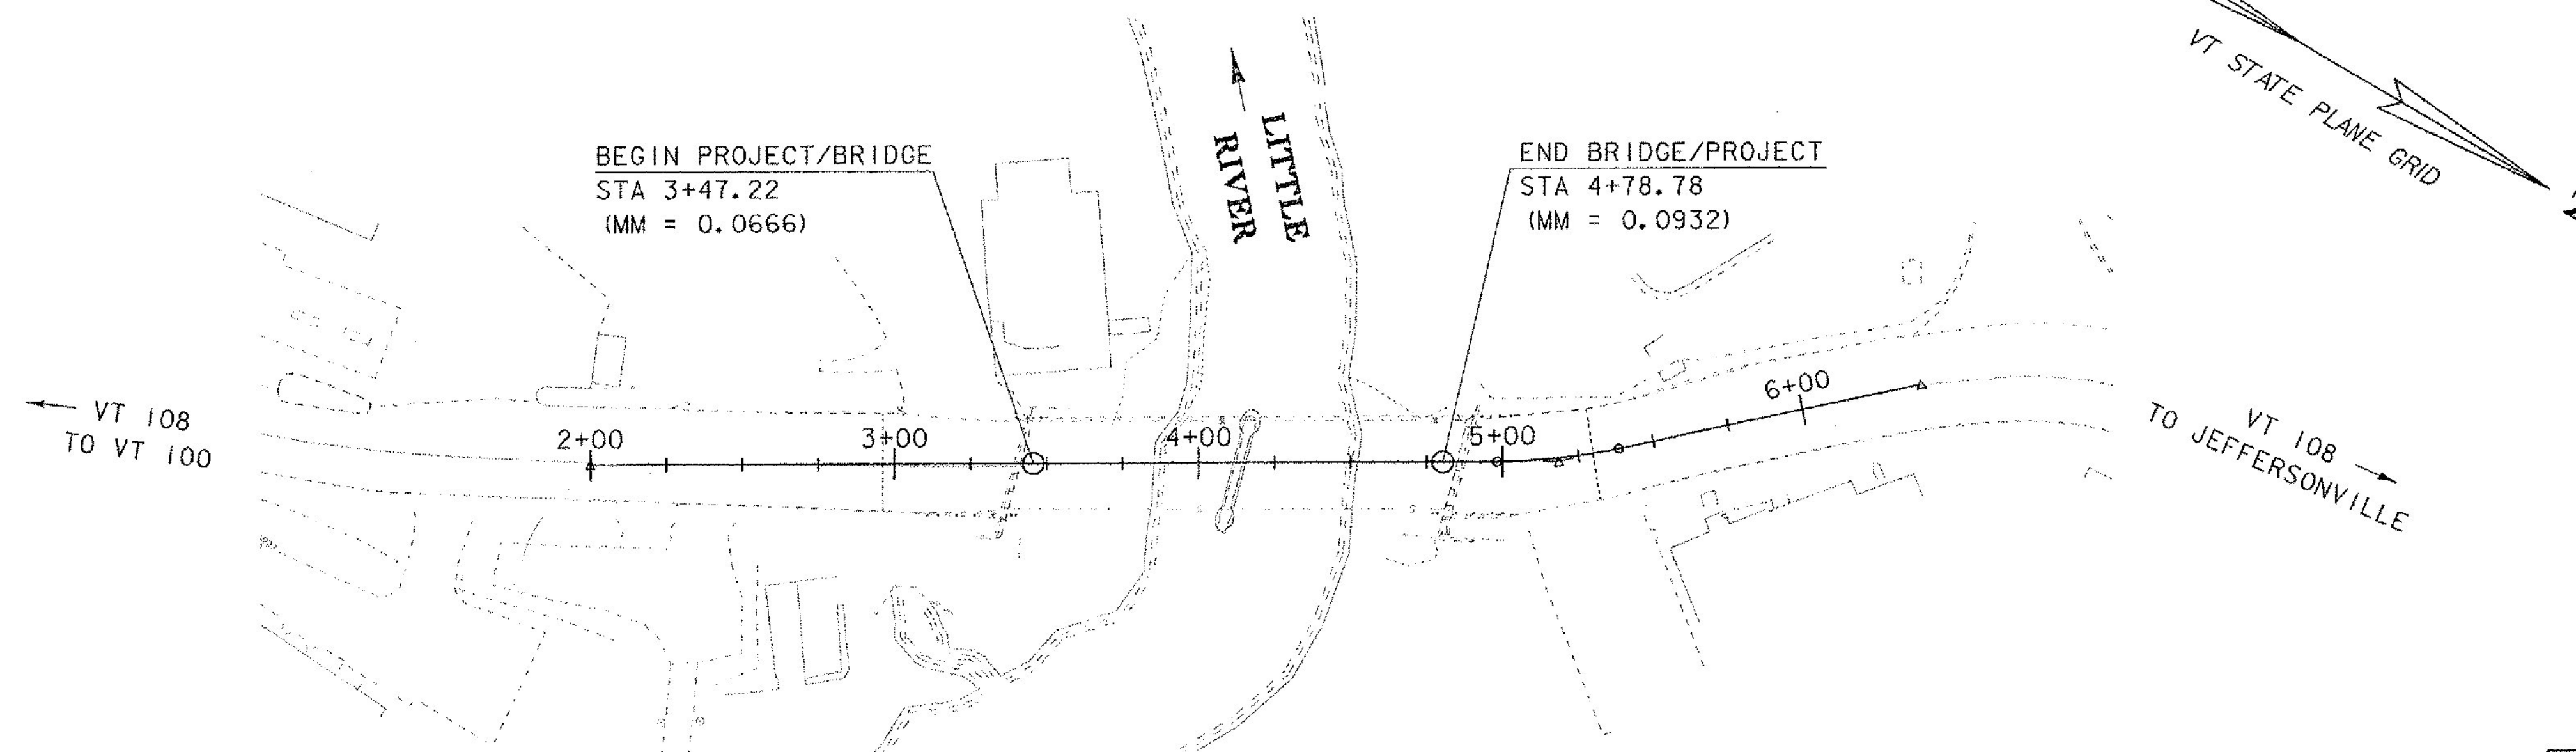

CONSTRUCTION IS TO BE CARRIED ON IN ACCORDANCE WITH THESE PLANS AND THE STANDARD SPECIFICATIONS FOR CONSTRUCTION DATED 2011, AS APPROVED BY THE FEDERAL HIGHWAY ADMINISTRATION ON JULY 20, 2011 FOR USE ON THIS PROJECT, INCLUDING ALL SUBSEQUENT REVISIONS AND SUCH REVISED SPECIFICATIONS AND SPECIAL PROVISIONS AS ARE INCORPORATED IN THESE PLANS.

QUALITY ASSURANCE PROGRAM : LEVEL 2	
SURVEYED BY :	R. GILMAN
SURVEYED DATE :	9/21/2009
DATUM	
VERTICAL	NAVD88
HORIZONTAL	NAD83 (96)

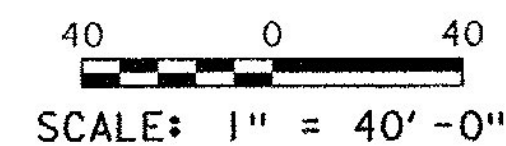

CHIEF ENGINEER OF THE HIGHWAY DIVISION	
APPROVED: <i>Richard Filmore</i>	DATE: 7-16-14
PROJECT MANAGER : C. CARLSON, P.E.	
PROJECT NAME : STOWE	
PROJECT NUMBER : BRF 0235 (11)	
SHEET 1 OF 64 SHEETS	