


PLAN

SCALE 1" = 10'-0"
 10 0 10

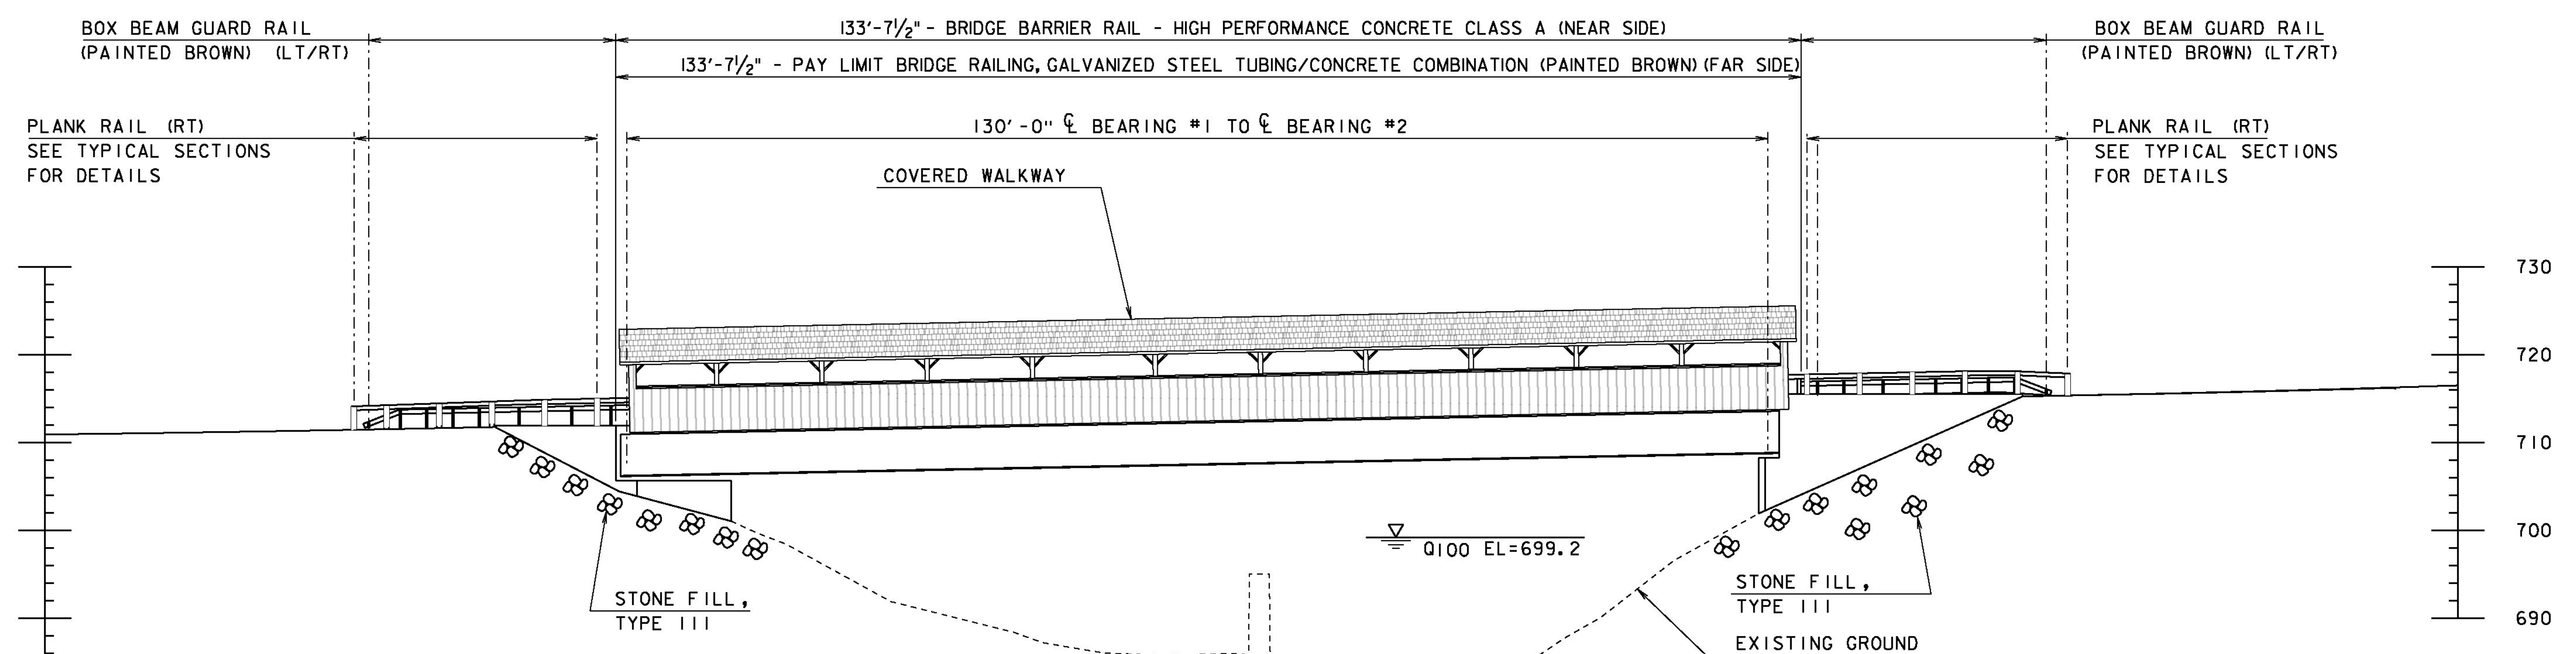

ELEVATION

SCALE 1" = 10'-0"
 10 0 10

PROJECT NAME:	STOWE	FILE NAME:	s87e052pe.dgn	PLOT DATE:	28-JUL-2014
PROJECT NUMBER:	BRF 0235 (II)	PROJECT LEADER:	C. CARLSON	DRAWN BY:	M. LONGSTREET
		DESIGNED BY:	D. PETERSON	CHECKED BY:	J. LACROIX
		PLAN & ELEVATION			SHEET 27 OF 64