



**BRIDGE DECK TYPICAL**  
SCALE 1/2" = 1'-0"

- NOTES:**
- 1.) DECK DRAIN AND DOWNSPOUT PAYMENT METHOD SHALL BE INCIDENTAL TO CONCRETE, HIGH PERFORMANCE CLASS A
  - 2.) PROVIDE DECK DRAIN, HEAVY DUTY, NEENAH STYLE, R-4015-B1 OR EQUIVALENT, WITH TYPE "P" GRATE OR EQUIVALENT.
  - 3.) GRATE AND DECK DRAIN SHALL BE HOT-DIP GALVANIZED.

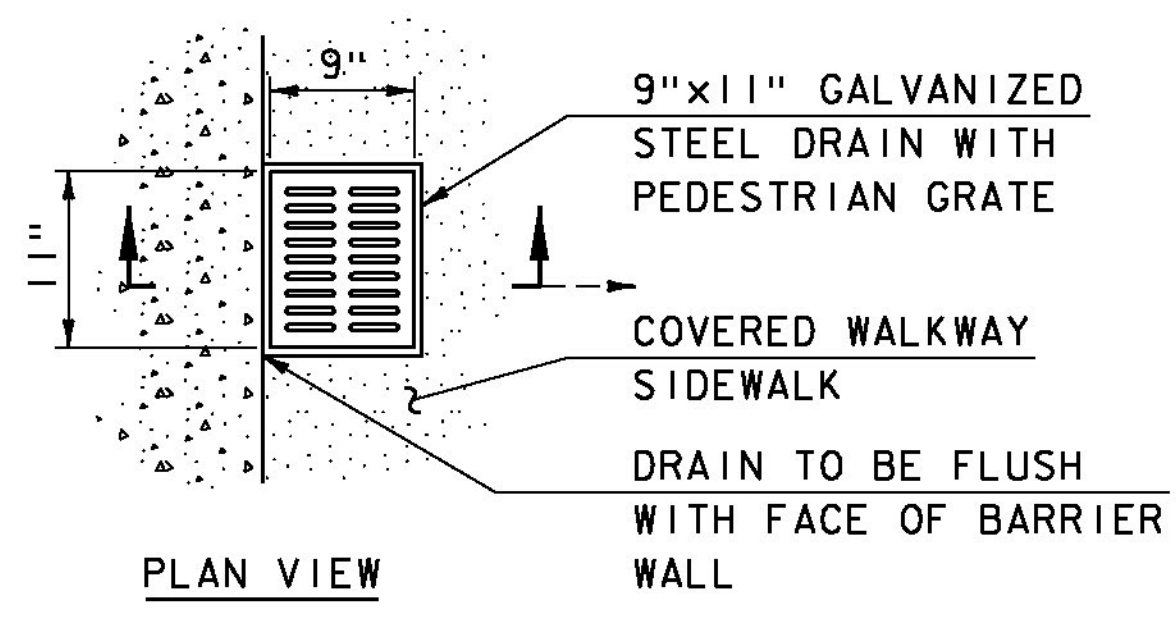

**DRAIN DETAILS**  
SCALE 1" = 1'-0"

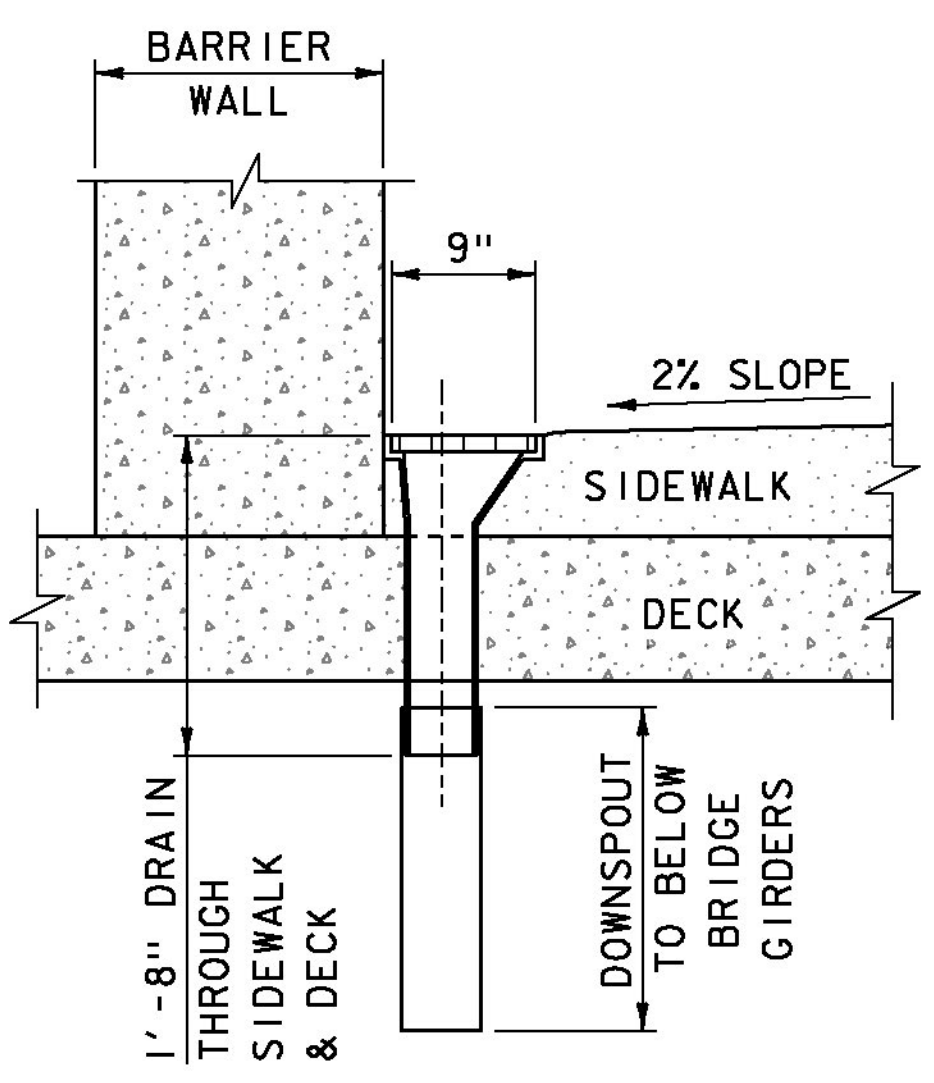

SECTION VIEW

**NOTE:**  
 NF = NEAR FACE  
 FF = FAR FACE  
 EF = EACH FACE  
 ▲ = CUT TO FIT IN FIELD  
 3" CLEAR, UNLESS OTHERWISE SPECIFIED ON THE PLANS.  
 2'-2" BAR LAP UNLESS OTHERWISE SPECIFIED ON THE PLANS.

PROJECT NAME:	STOWE	FILE NAME:	s87e052sup.dgn	PLOT DATE:	28-JUL-2014
PROJECT NUMBER:	BRF 0235 (II)	PROJECT LEADER:	C. CARLSON	DRAWN BY:	M. LONGSTREET
		DESIGNED BY:	D. PETERSON	CHECKED BY:	J. LACROIX
		DECK TYPICAL & DETAILS		SHEET	28 OF 64