


CAMBER DIAGRAM
NOT TO SCALE

DEAD LOAD DEFLECTION DIAGRAM
NOT TO SCALE

NOTE:
DEFLECTION INCLUDES, GIRDER, CROSS FRAMES, DECK, SIDEWALK, COVERED WALKWAY, AND RAILING.

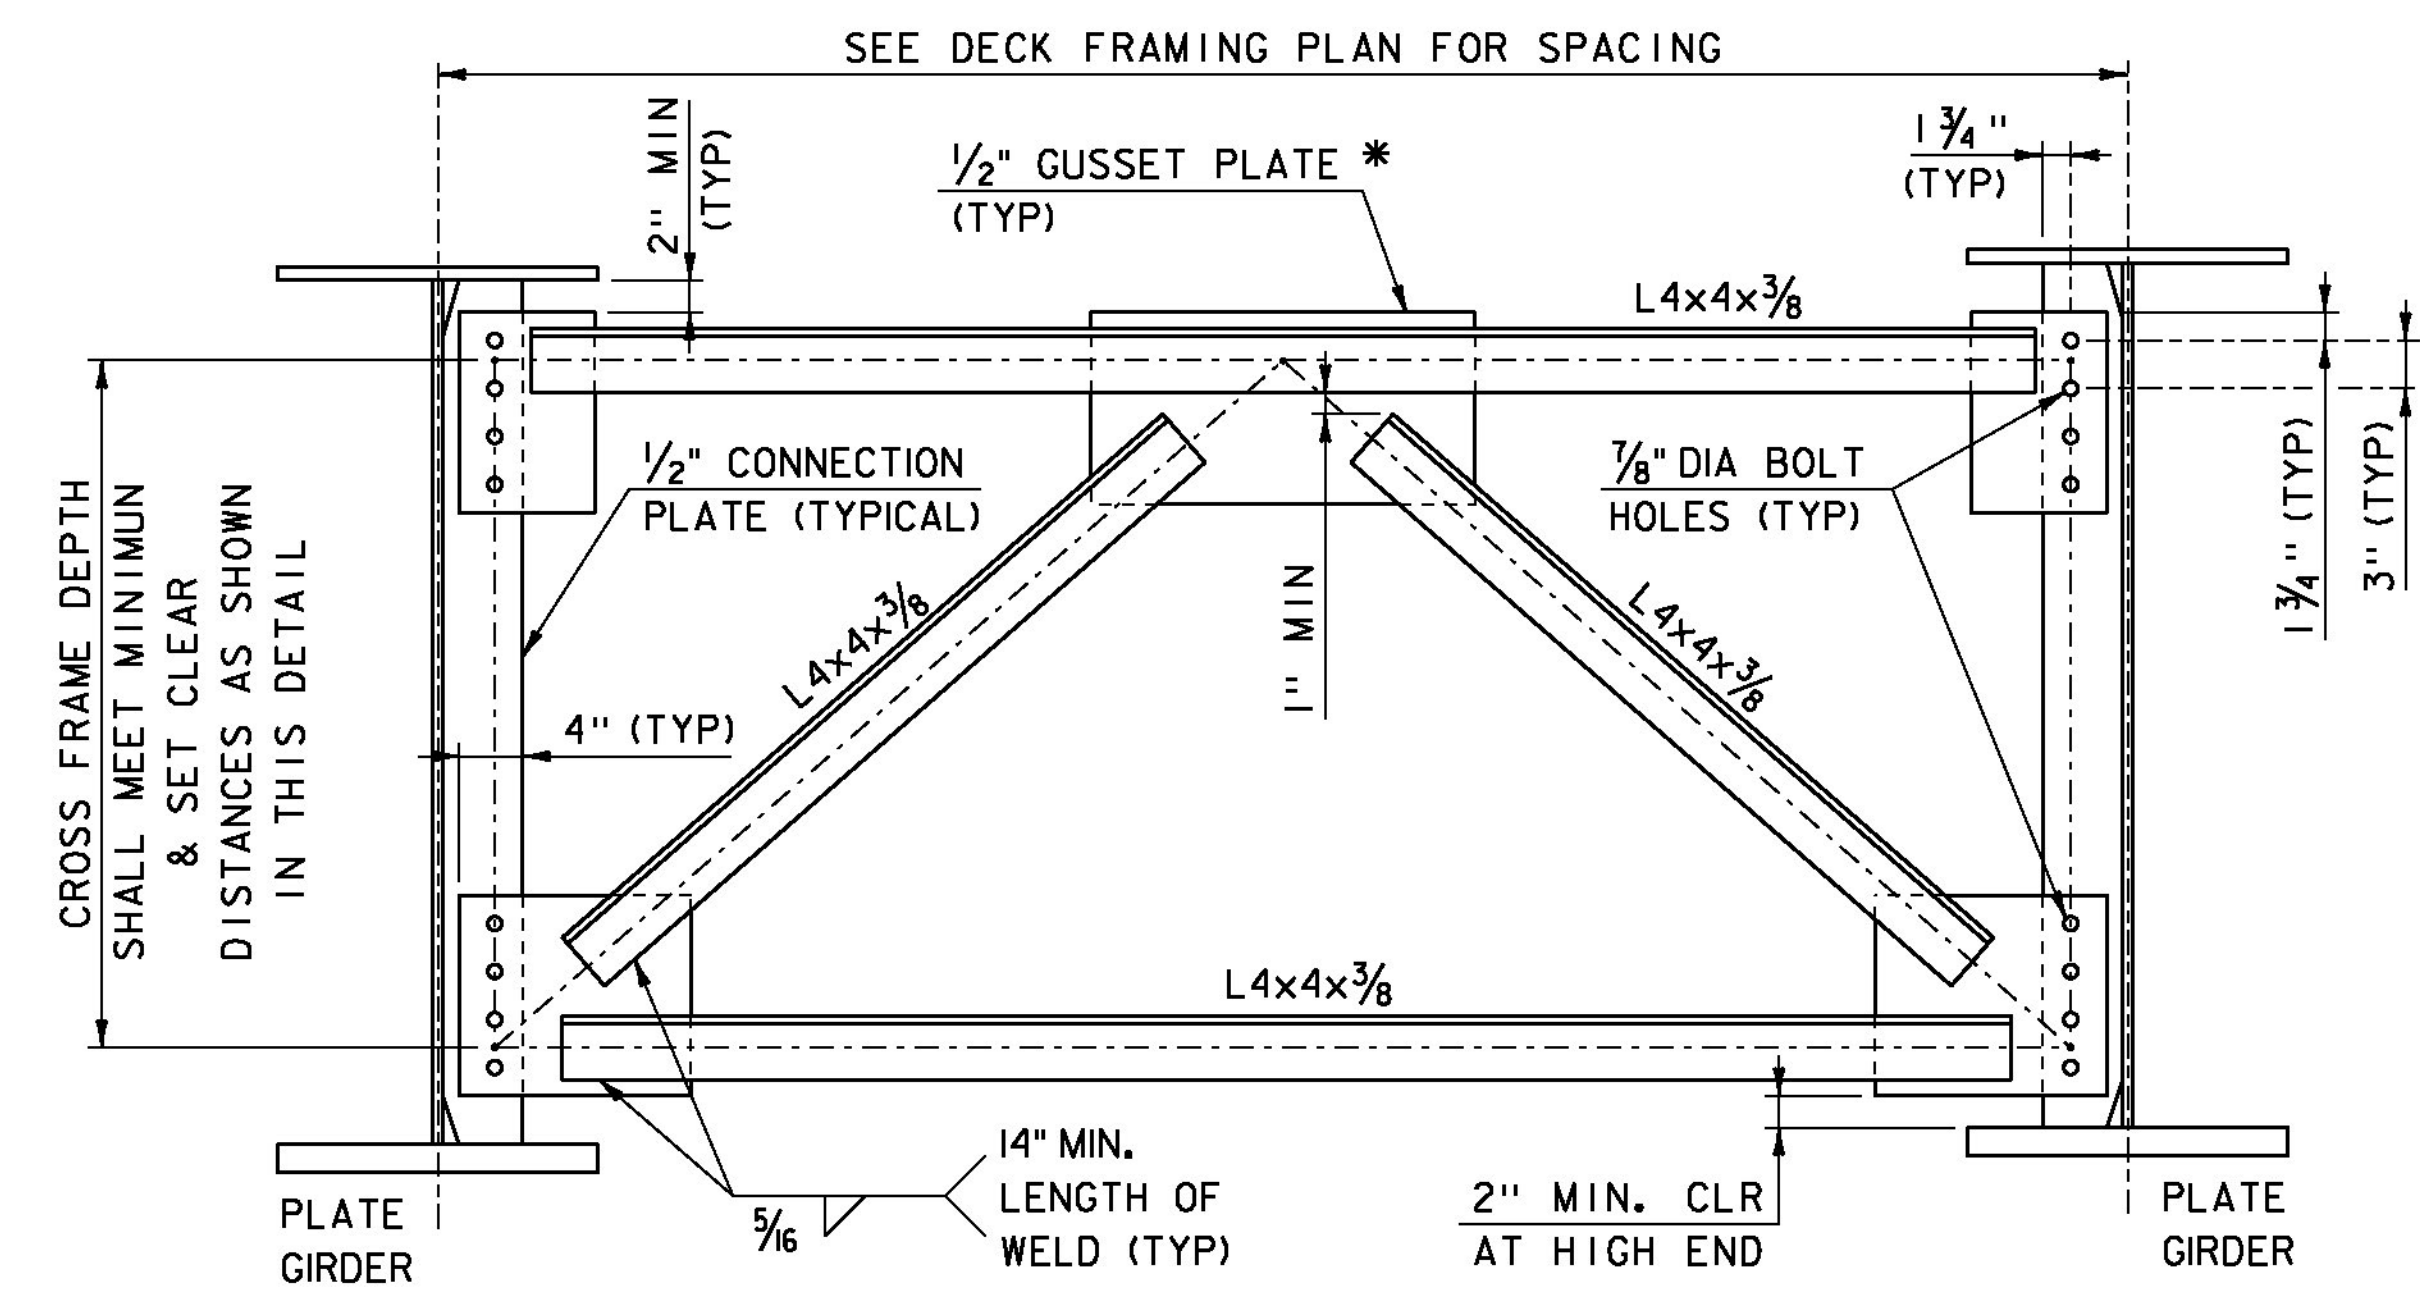

INTERMEDIATE CROSSFRAME DETAILS
SCALE 1" = 1'-0"

* THE FABRICATOR MAY ALTER THE SHAPE OF THE GUSSET PLATES AS REQUIRED TO MEET MINIMUM WELDING LENGTH AND TO MAINTAIN THE BOLT HOLE LOCATIONS.

PROJECT NAME:	STOWE
PROJECT NUMBER:	BRF 0235 (II)
FILE NAME: s87e052sup.dgn	PLOT DATE: 28-JUL-2014
PROJECT LEADER: C. CARLSON	DRAWN BY: D. KARABEGOVIC
DESIGNED BY: D. PETERSON	CHECKED BY: M. LONGSTREET
CAMBER & DEFLECTION	SHEET 31 OF 64