


ABUTMENT 2 PRECAST - REINFORCEMENT PLAN

SCALE: 1/4" = 1'-0"

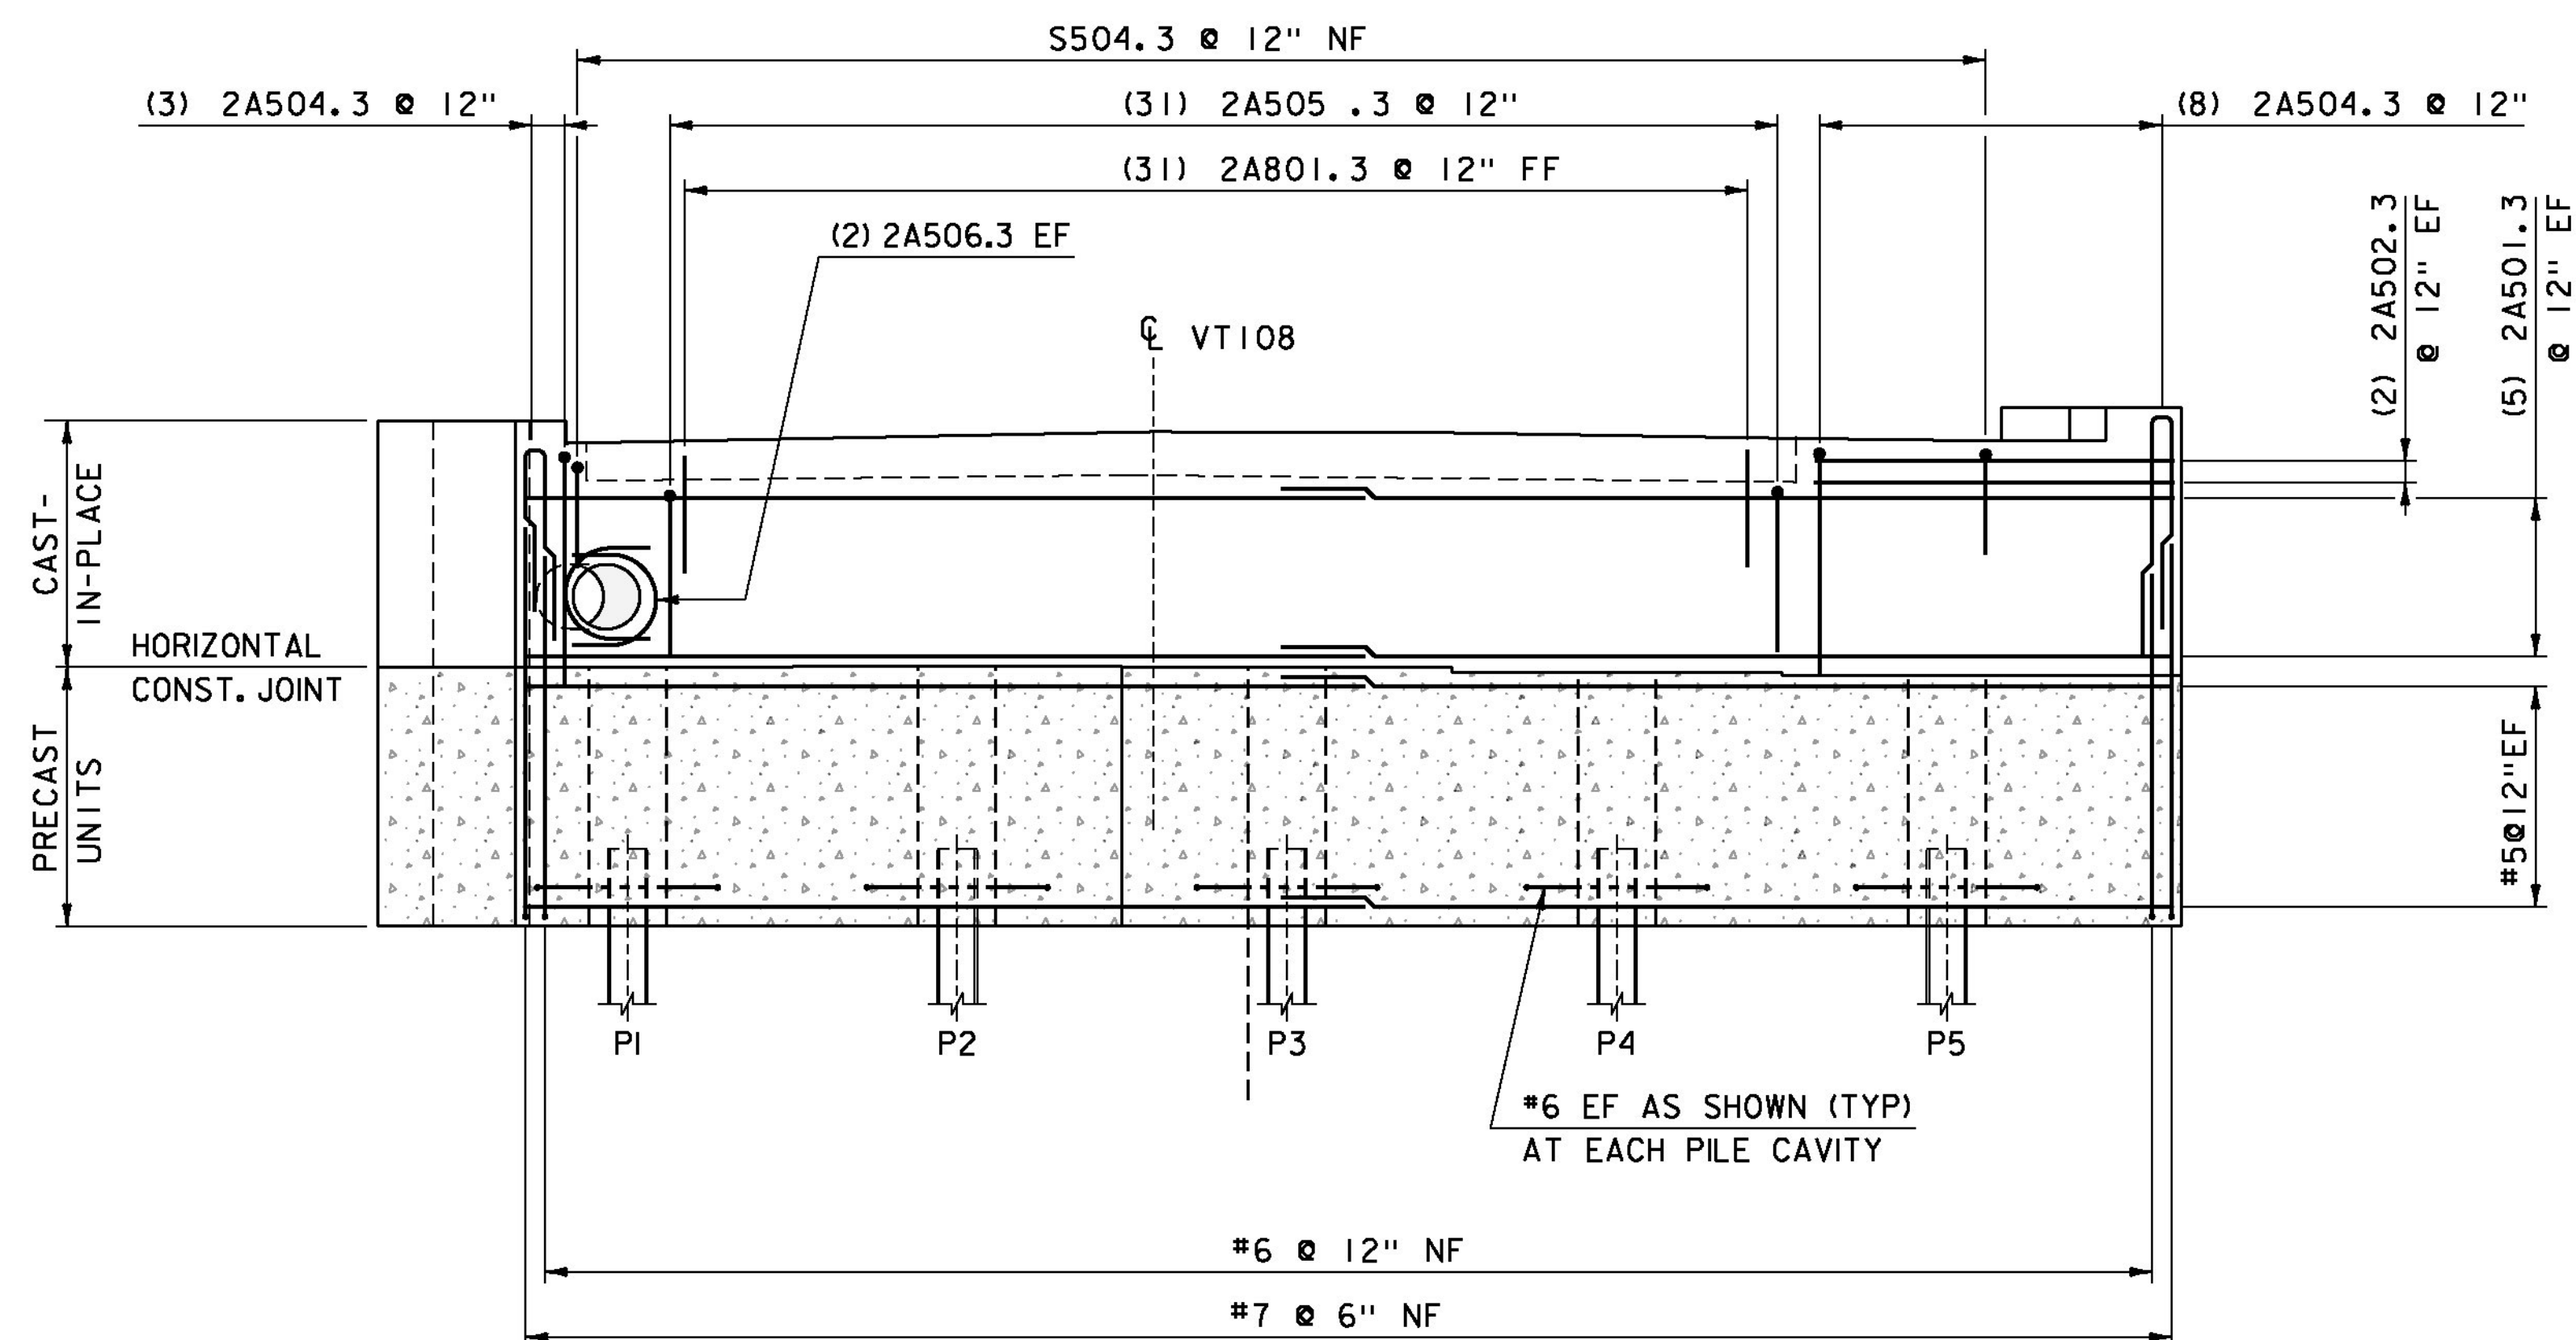

ABUTMENT 2 - REINFORCING ELEVATION

SCALE: 1/4" = 1'-0"

NOTE:

NF = NEAR FACE  
 FF = FAR FACE  
 EF = EACH FACE  
 ▲ = CUT TO FIT IN FIELD  
 3" CLEAR, UNLESS OTHERWISE  
 SPECIFIED ON THE PLANS.  
 2'-2" BAR LAP UNLESS OTHERWISE  
 SPECIFIED ON THE PLANS.

PROJECT NAME: STOWE  
 PROJECT NUMBER: BRF 0235 (II)

FILE NAME: s87e052sub.dgn PLOT DATE: 28-JUL-2014  
 PROJECT LEADER: C. CARLSON DRAWN BY: D. KARABEGOVIC  
 DESIGNED BY: D. PETERSON CHECKED BY: M. LONGSTREET  
 ABUTMENT #2 REINFORCING DETAILS SHEET 41 OF 64