



2+50

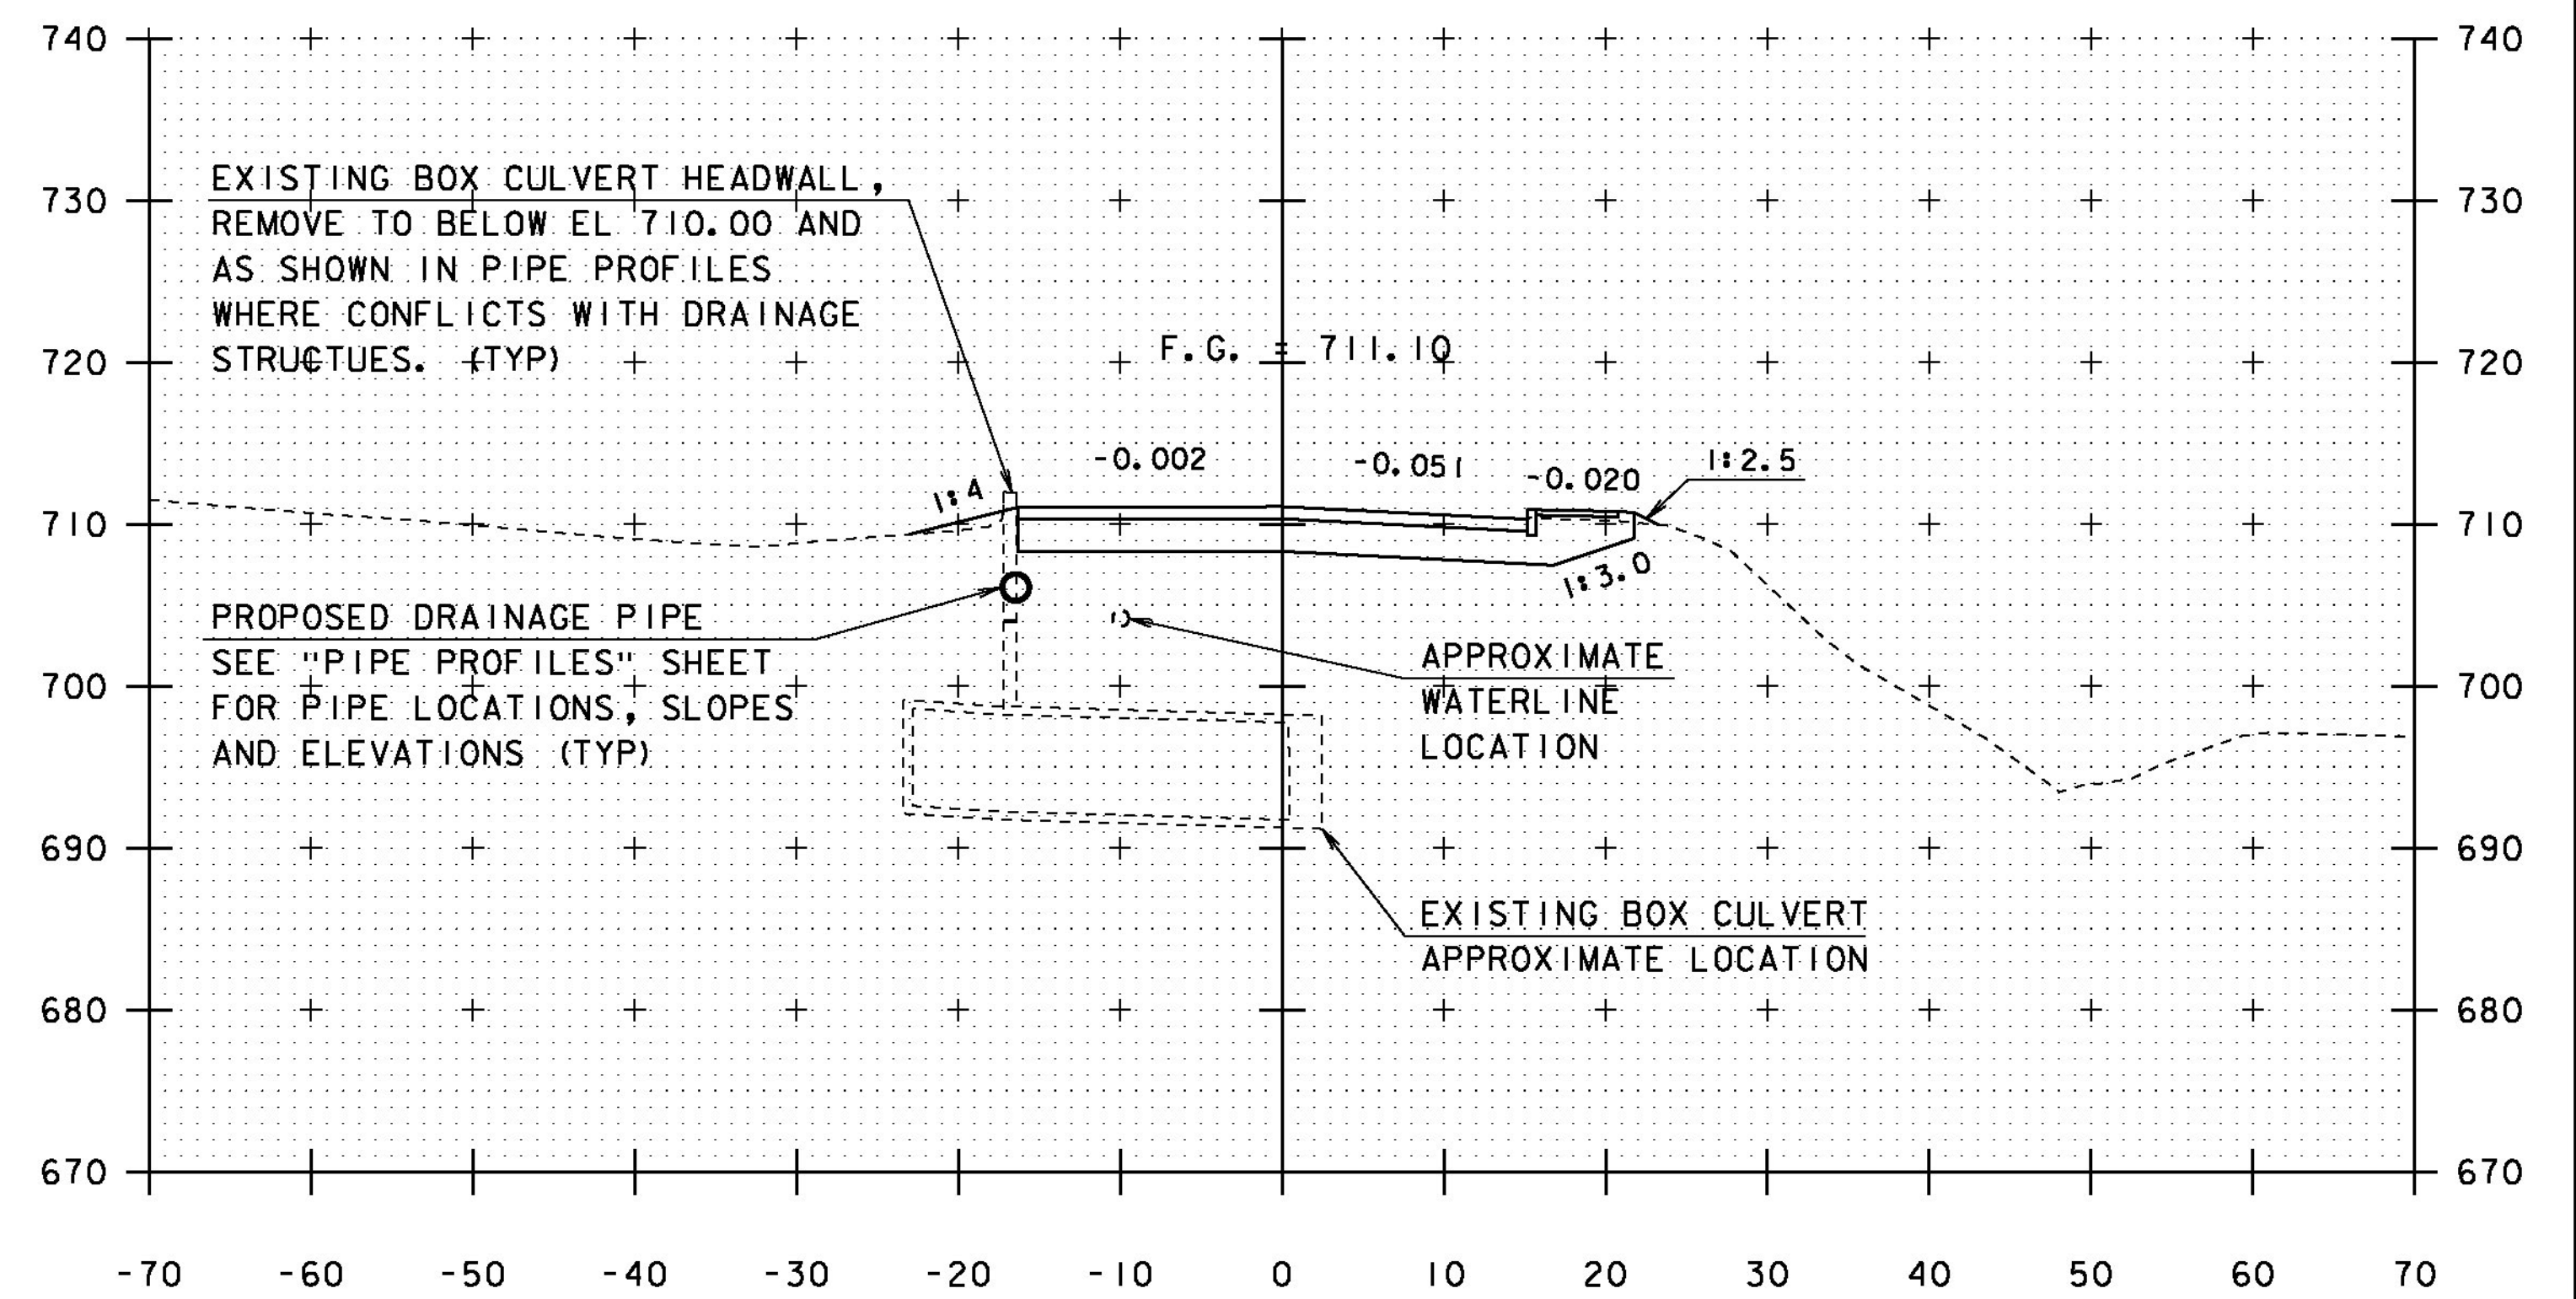


2+90

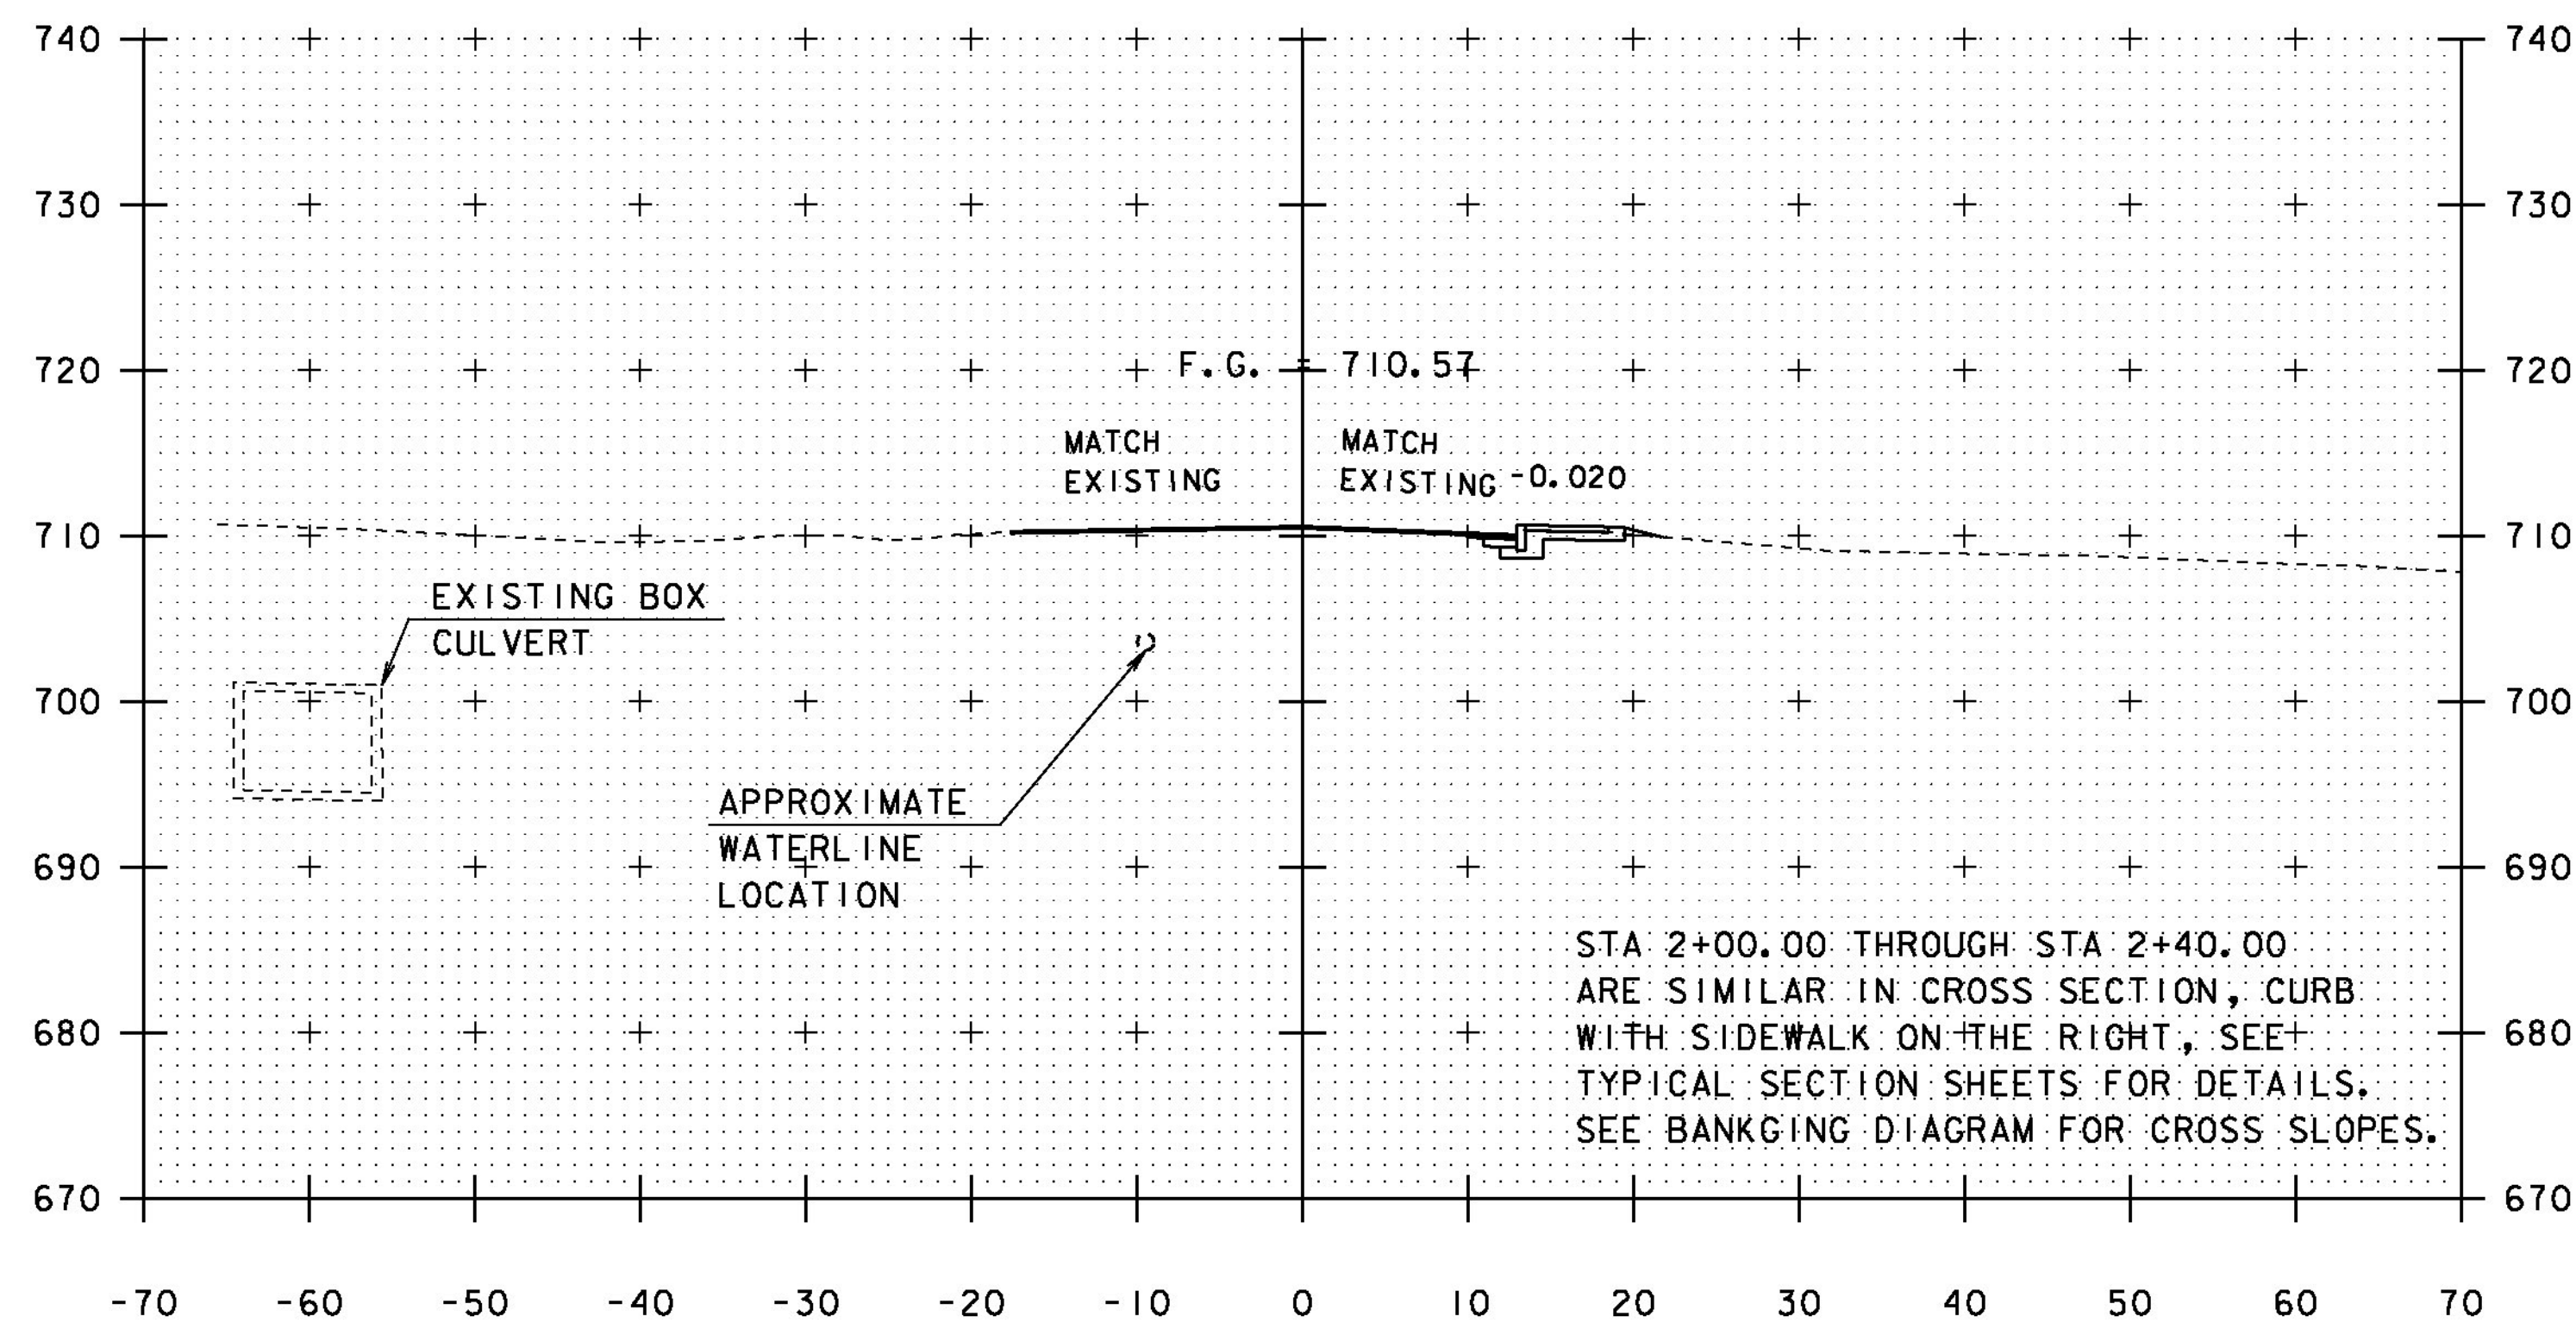

2+40

BEGIN APPROACH
STA 2+00.00
(MATCH EXISTING)

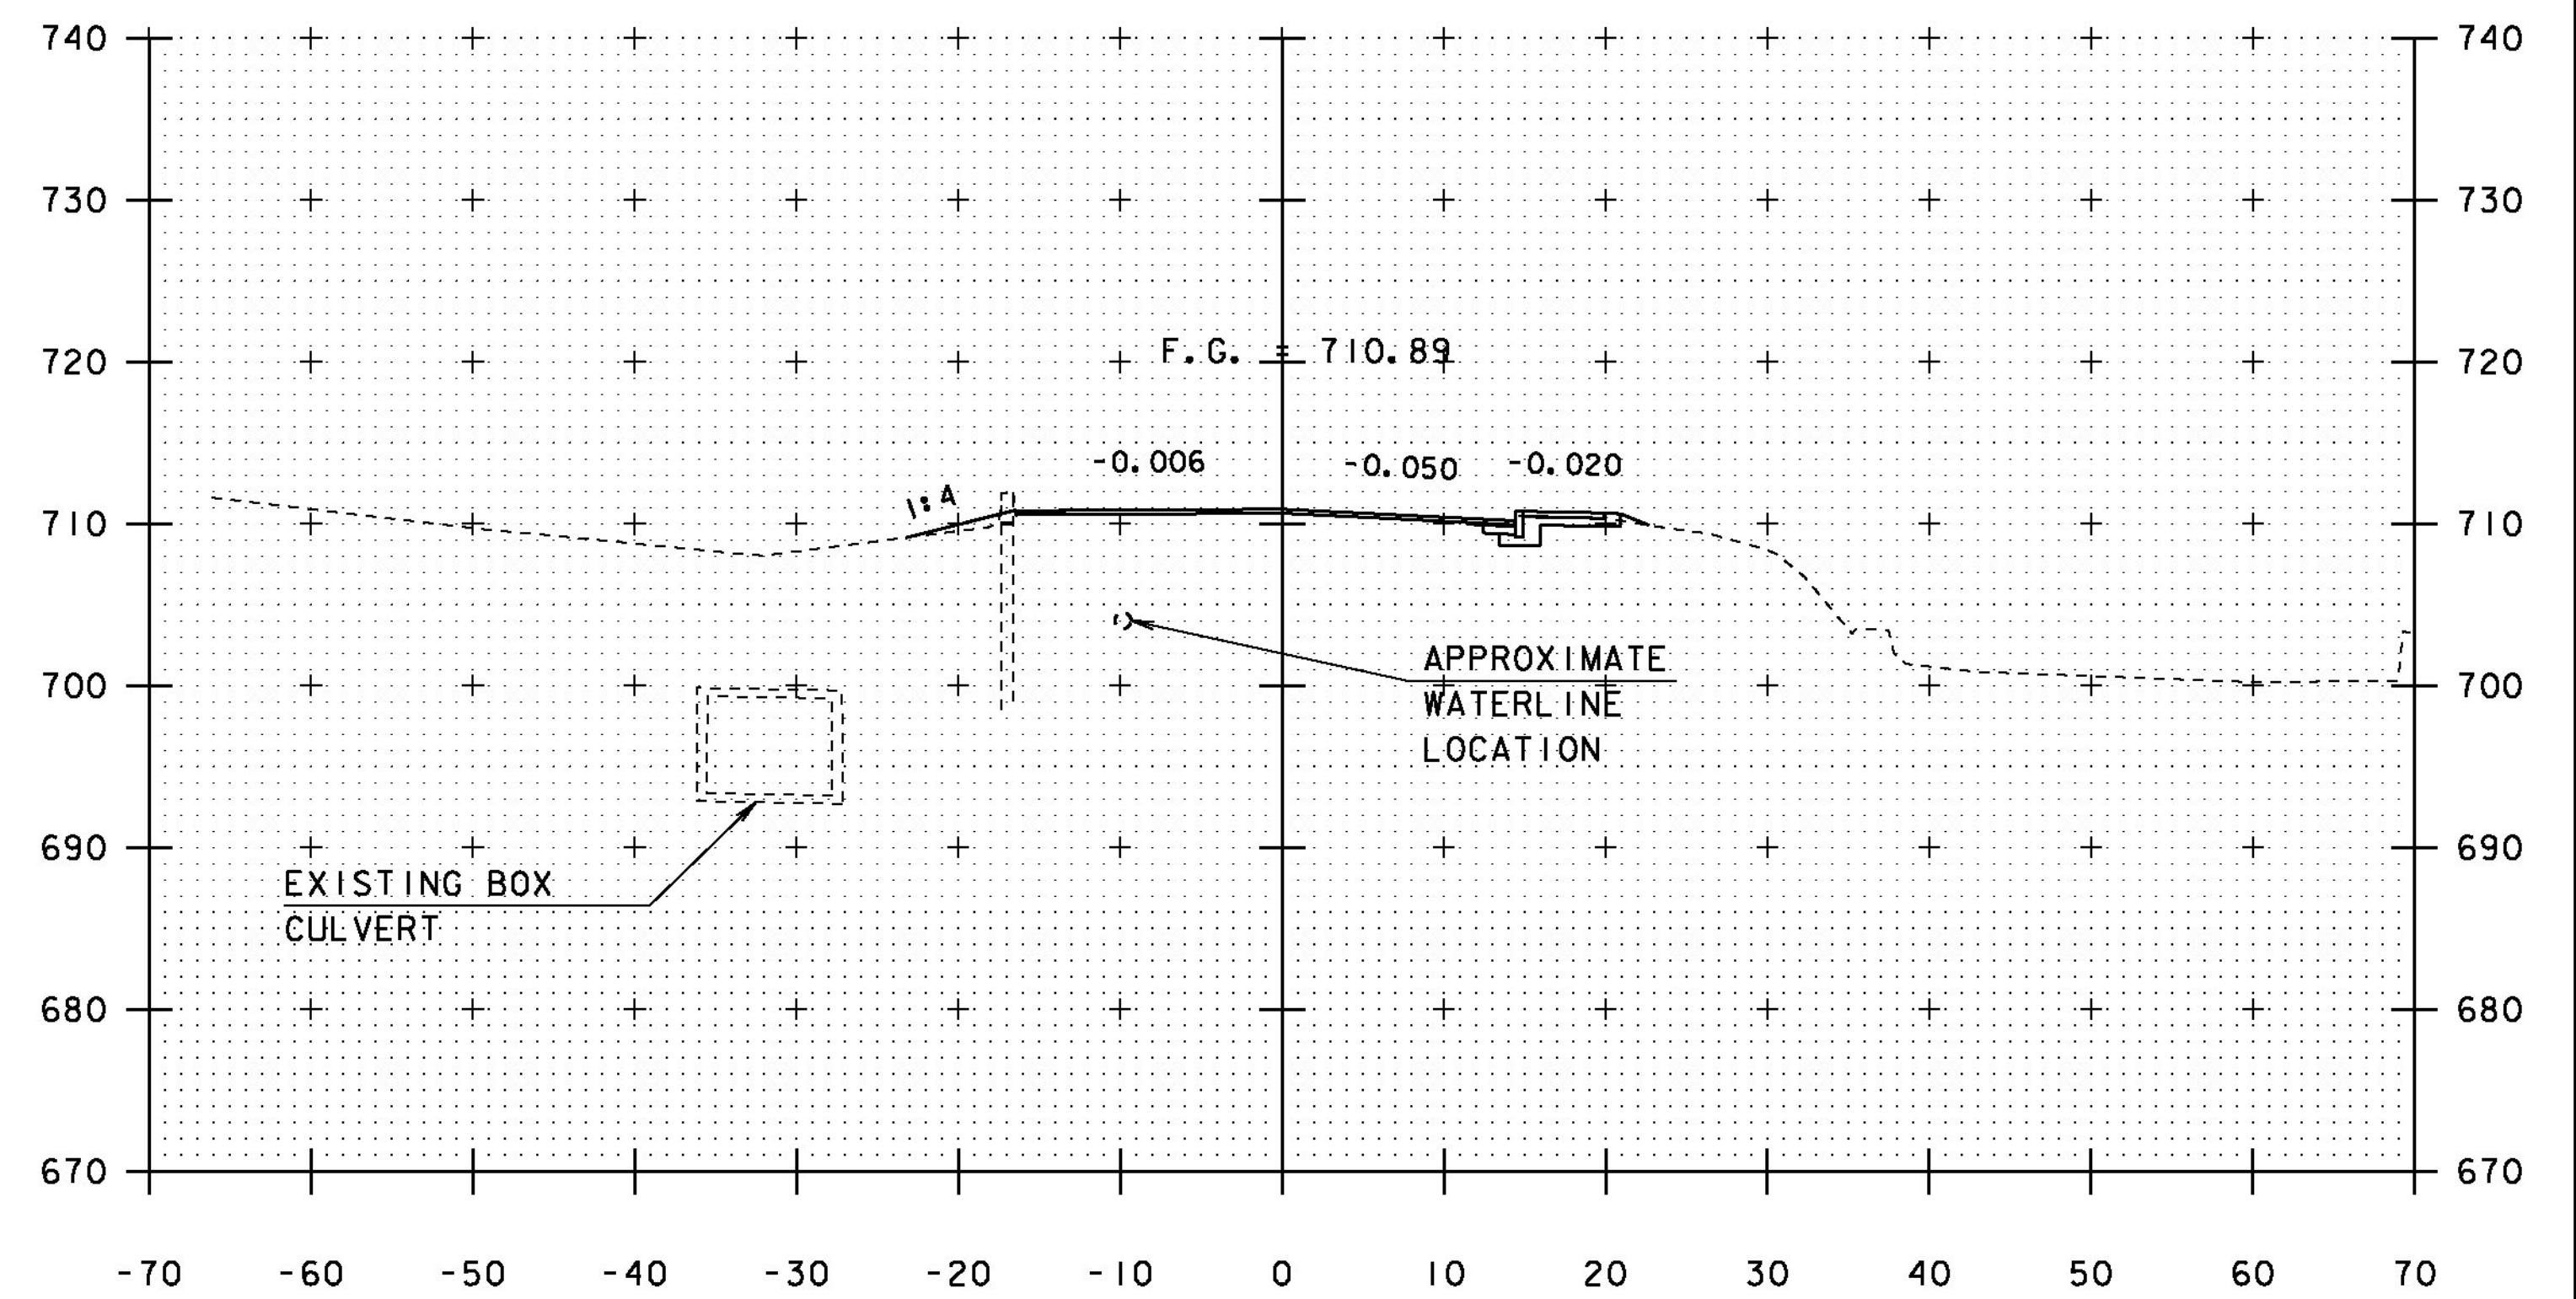

2+75

STA. 2+40 TO STA. 2+90

PROJECT NAME:	STOWE	FILE NAME:	s87e052xsl.dgn	PLOT DATE:	28-JUL-2014
PROJECT NUMBER:	BRF 0235 (11)	PROJECT LEADER:	C. CARLSON	DRAWN BY:	M. LONGSTREET
		DESIGNED BY:	D. PETERSON	CHECKED BY:	J. LACROIX
			VT 108 CROSS SECTIONS SHEET 1	SHEET	46 OF 64