


10+50

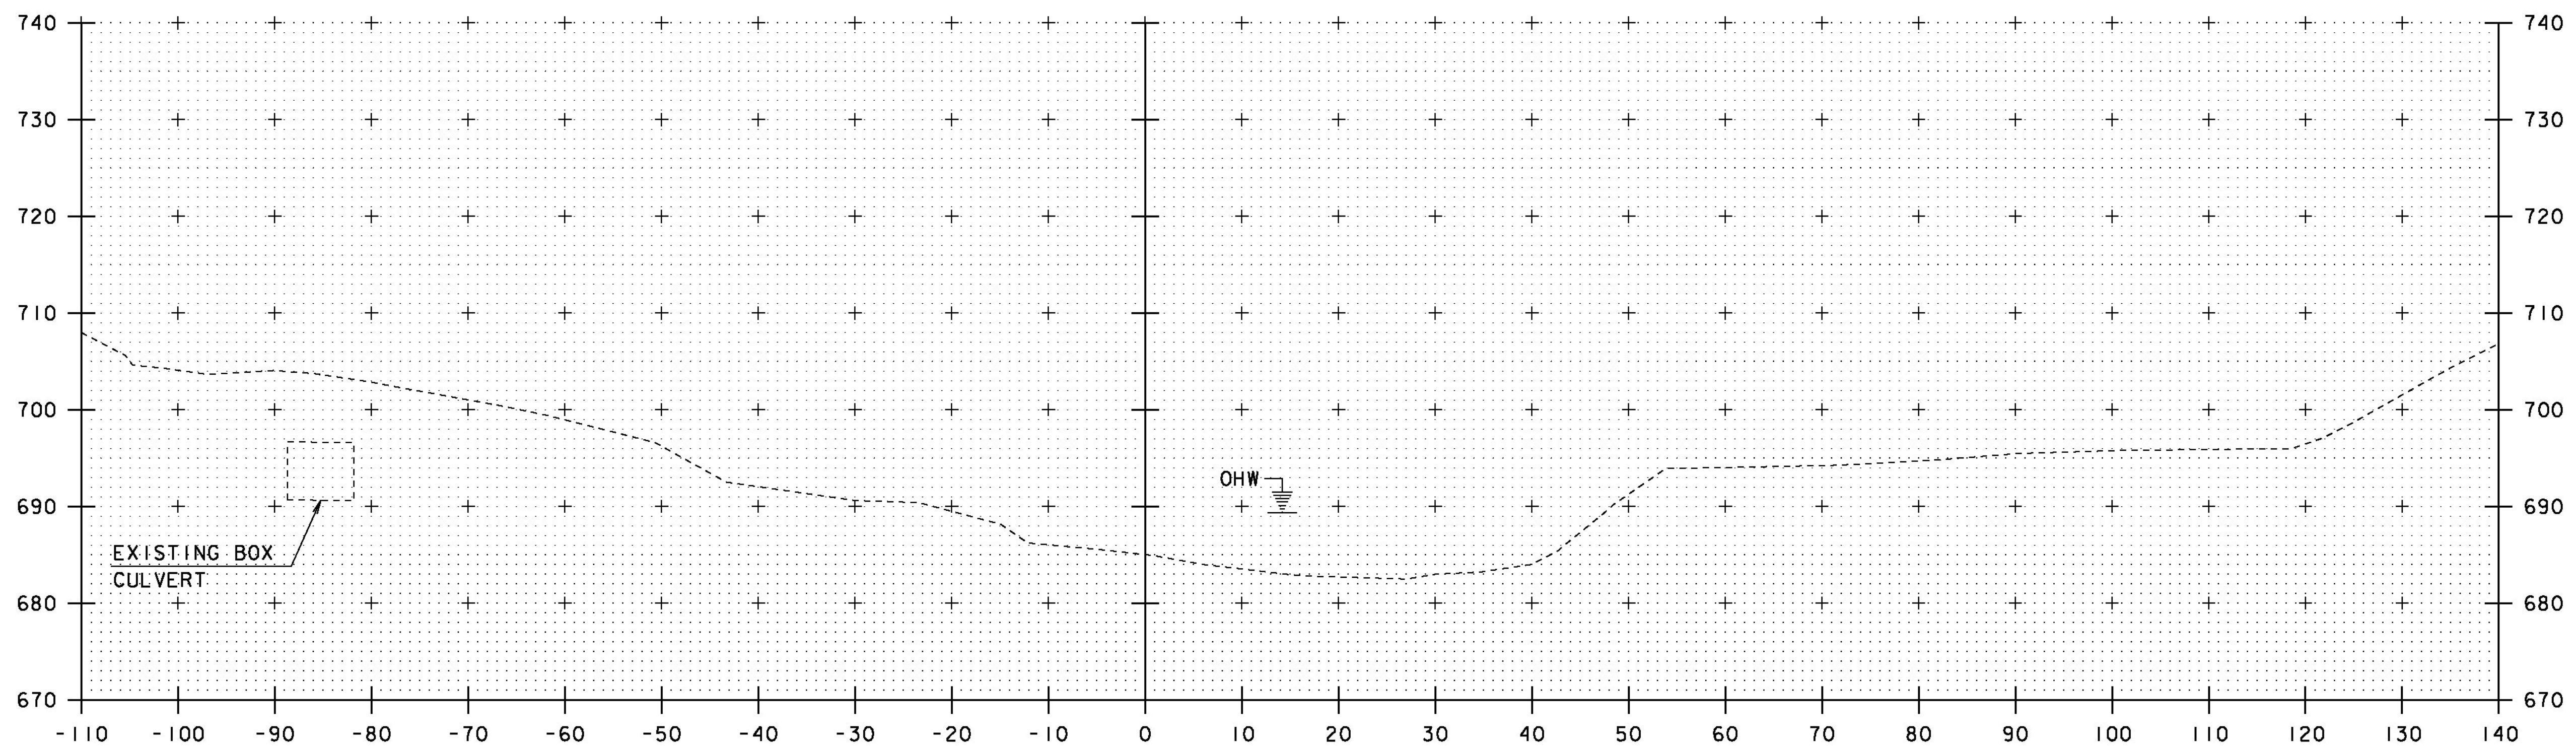

10+40

PROJECT NAME:	STOWE	PLOT DATE:	28-JUL-2014
PROJECT NUMBER:	BRF 0235 (11)	DRAWN BY:	M. LONGSTREET
FILE NAME:	s87e052xsl.dgn	DESIGNED BY:	D. PETERSON
PROJECT LEADER:	C. CARLSON	CHECKED BY:	J. LACROIX
CHANNEL CROSS SECTIONS SHEET 1		SHEET	51 OF 64

STA. 10+40 TO STA. 10+50