


10+70

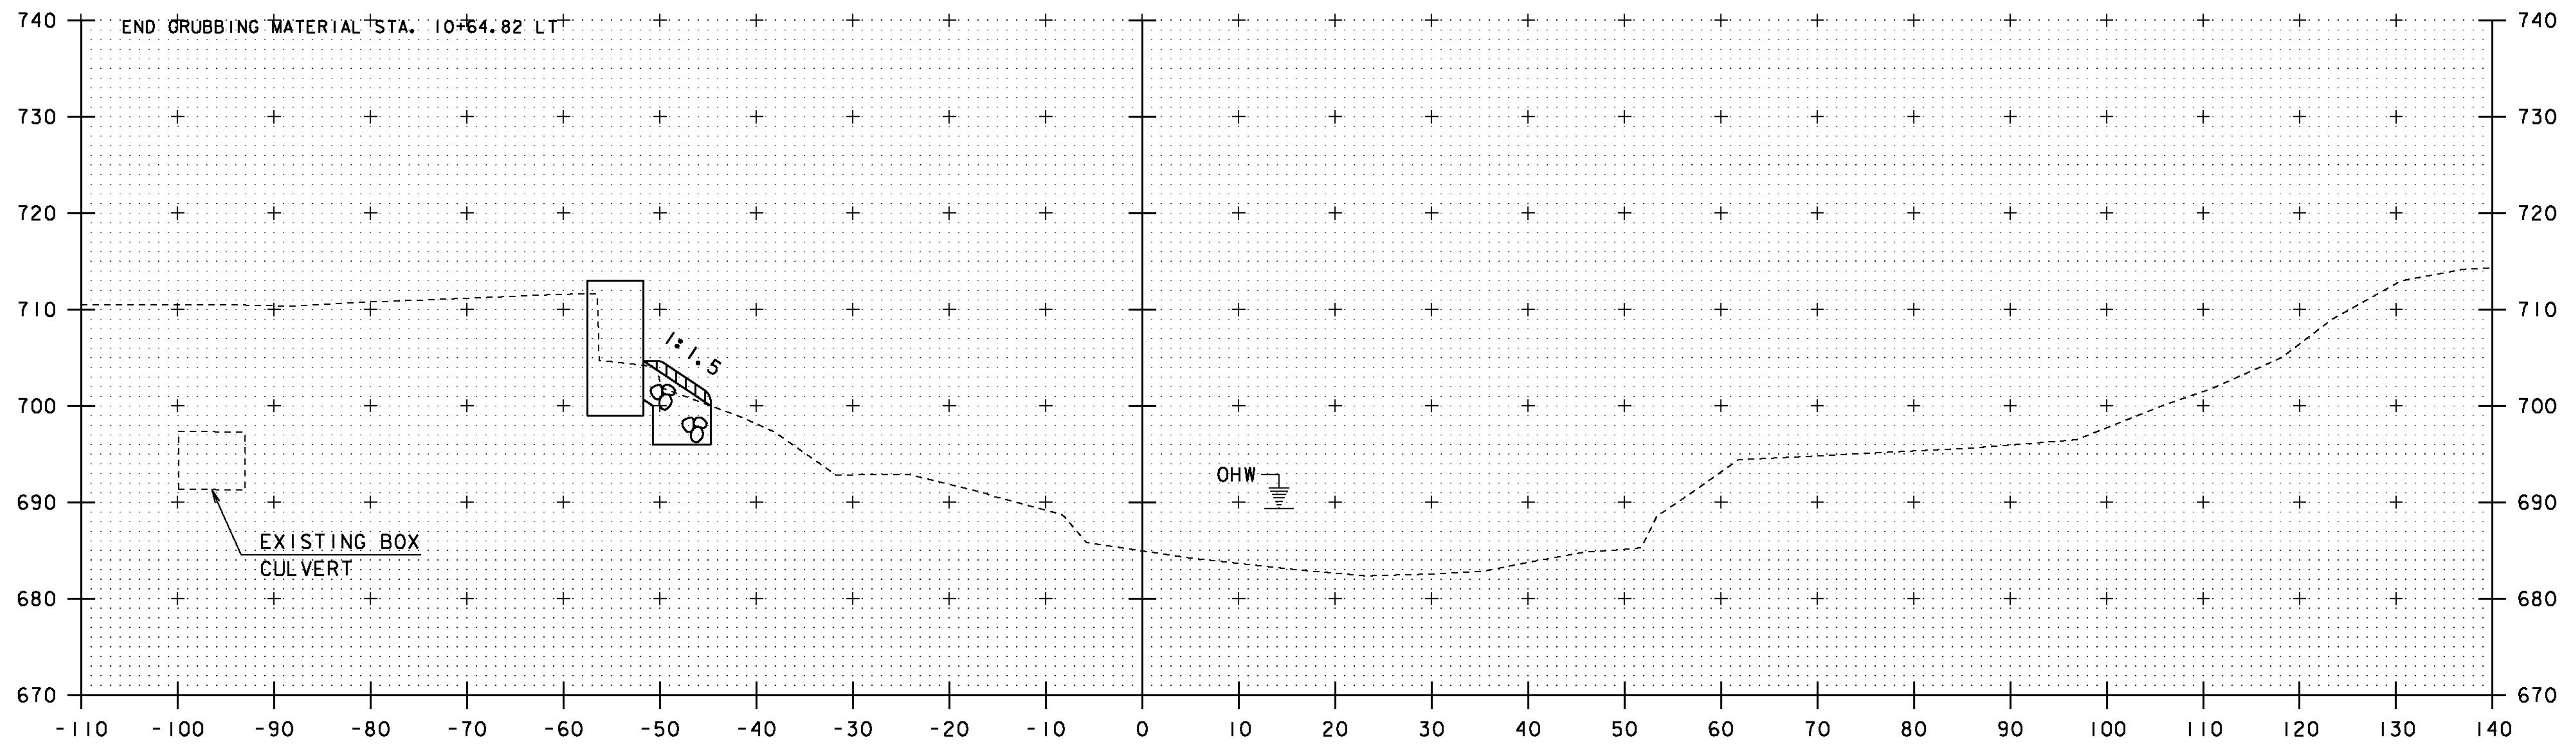

10+60

PROJECT NAME: STOWE	
PROJECT NUMBER: BRF 0235 (II)	
FILE NAME: s87e052xsl.dgn	PLOT DATE: 28-JUL-2014
PROJECT LEADER: C. CARLSON	DRAWN BY: M. LONGSTREET
DESIGNED BY: D. PETERSON	CHECKED BY: J. LACROIX
CHANNEL CROSS SECTIONS SHEET 2	SHEET 52 OF 64

STA. 10+60 TO STA. 10+70