


10+90

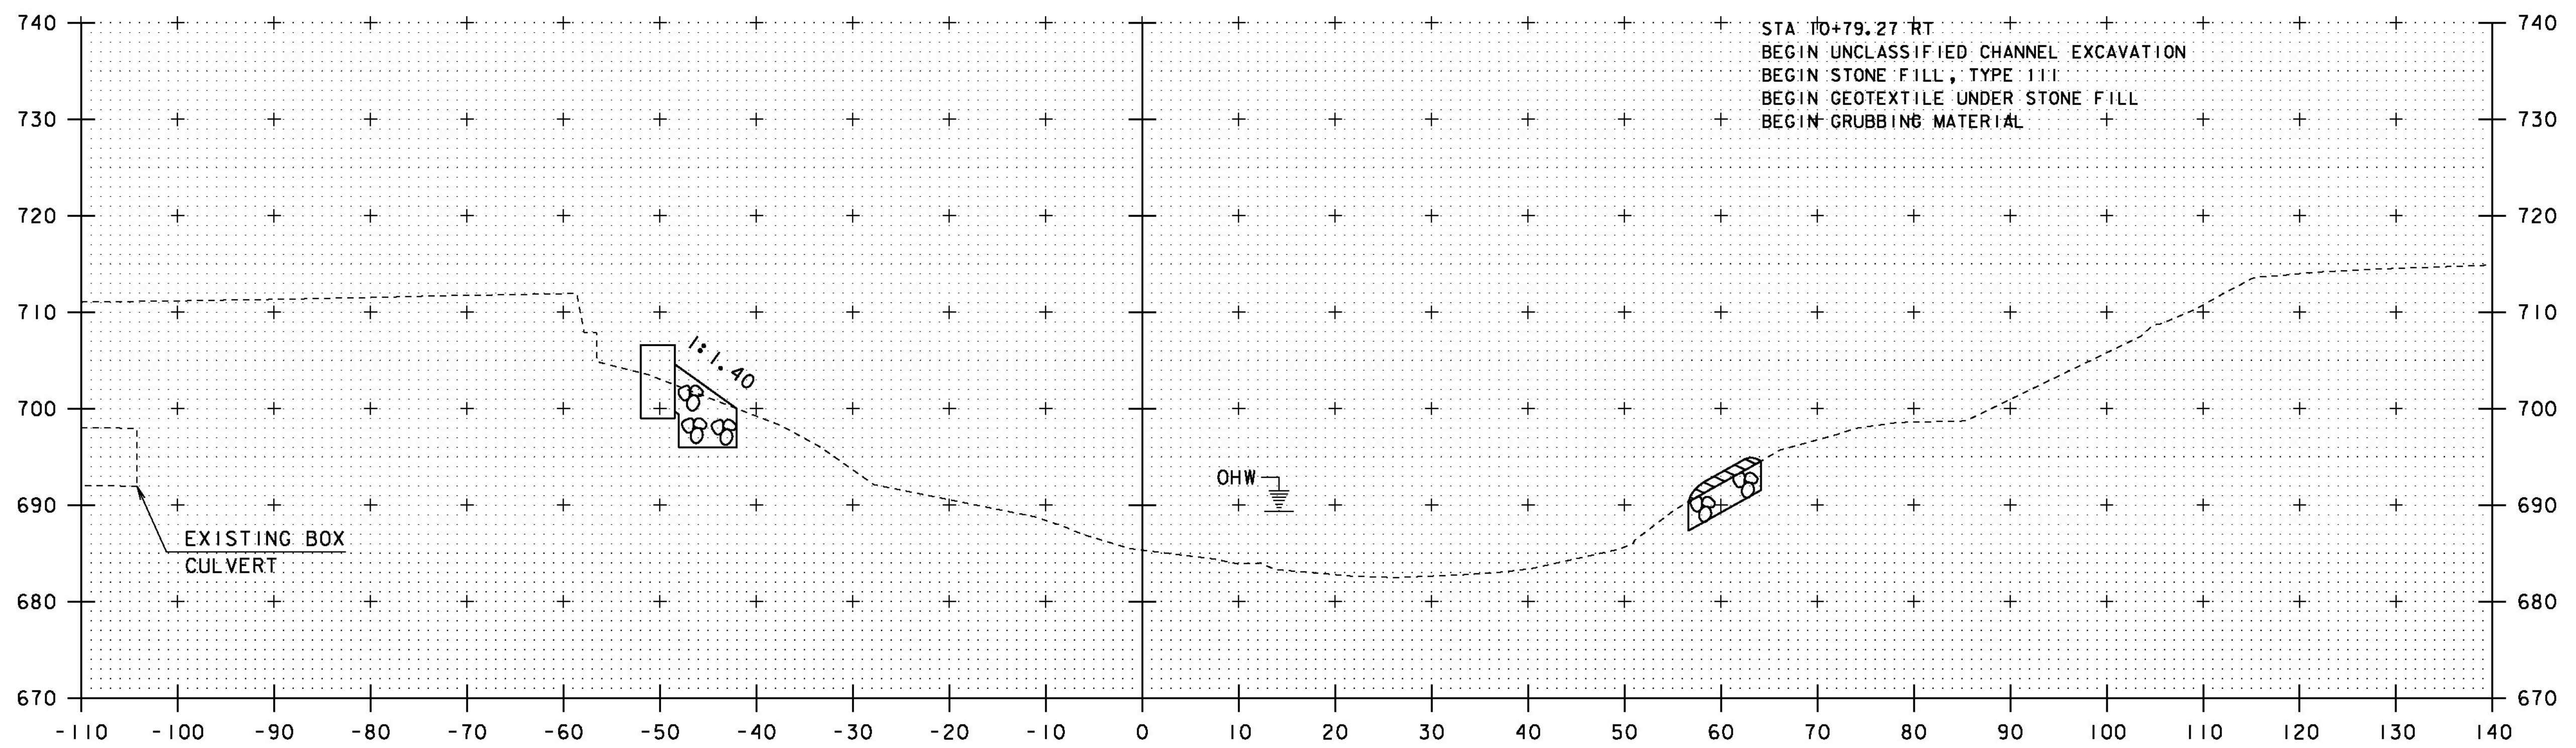

10+80

STA. 10+80 TO STA. 10+90

PROJECT NAME: STOWE	
PROJECT NUMBER: BRF 0235 (11)	
FILE NAME: s87e052xsl.dgn	PLOT DATE: 28-JUL-2014
PROJECT LEADER: C. CARLSON	DRAWN BY: M. LONGSTREET
DESIGNED BY: D. PETERSON	CHECKED BY: J. LACROIX
CHANNEL CROSS SECTIONS SHEET 3	SHEET 53 OF 64