


11+30

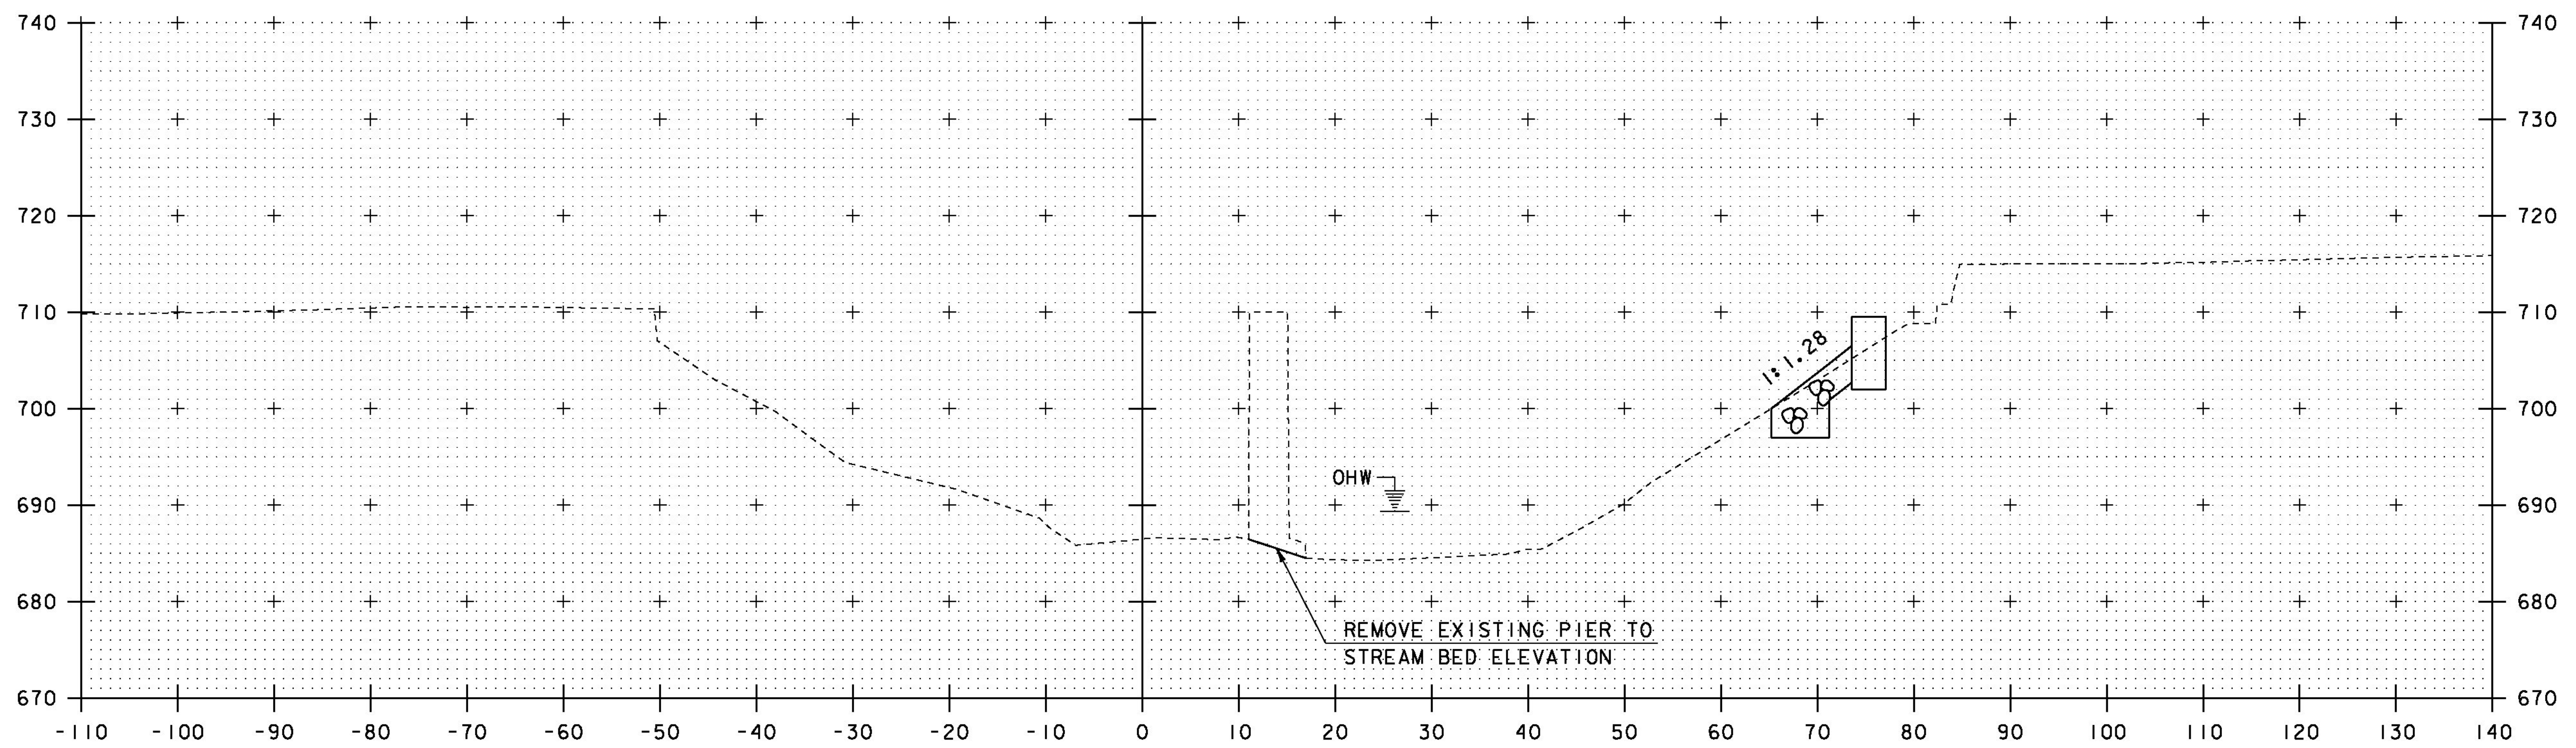

11+20

STA. 11+20 TO STA. 11+30

PROJECT NAME:	STOWE	PLOT DATE:	28-JUL-2014
PROJECT NUMBER:	BRF 0235 (11)	DRAWN BY:	M. LONGSTREET
FILE NAME:	s87e052xsl.dgn	DESIGNED BY:	D. PETERSON
PROJECT LEADER:	C. CARLSON	CHECKED BY:	J. LACROIX
CHANNEL CROSS SECTIONS SHEET 5		SHEET	55 OF 64