


**Approach Slab 1 & 2 Rebar at closure pour**

\*See Dimension Fabricators Drawings A & B for bar type, size & schedule

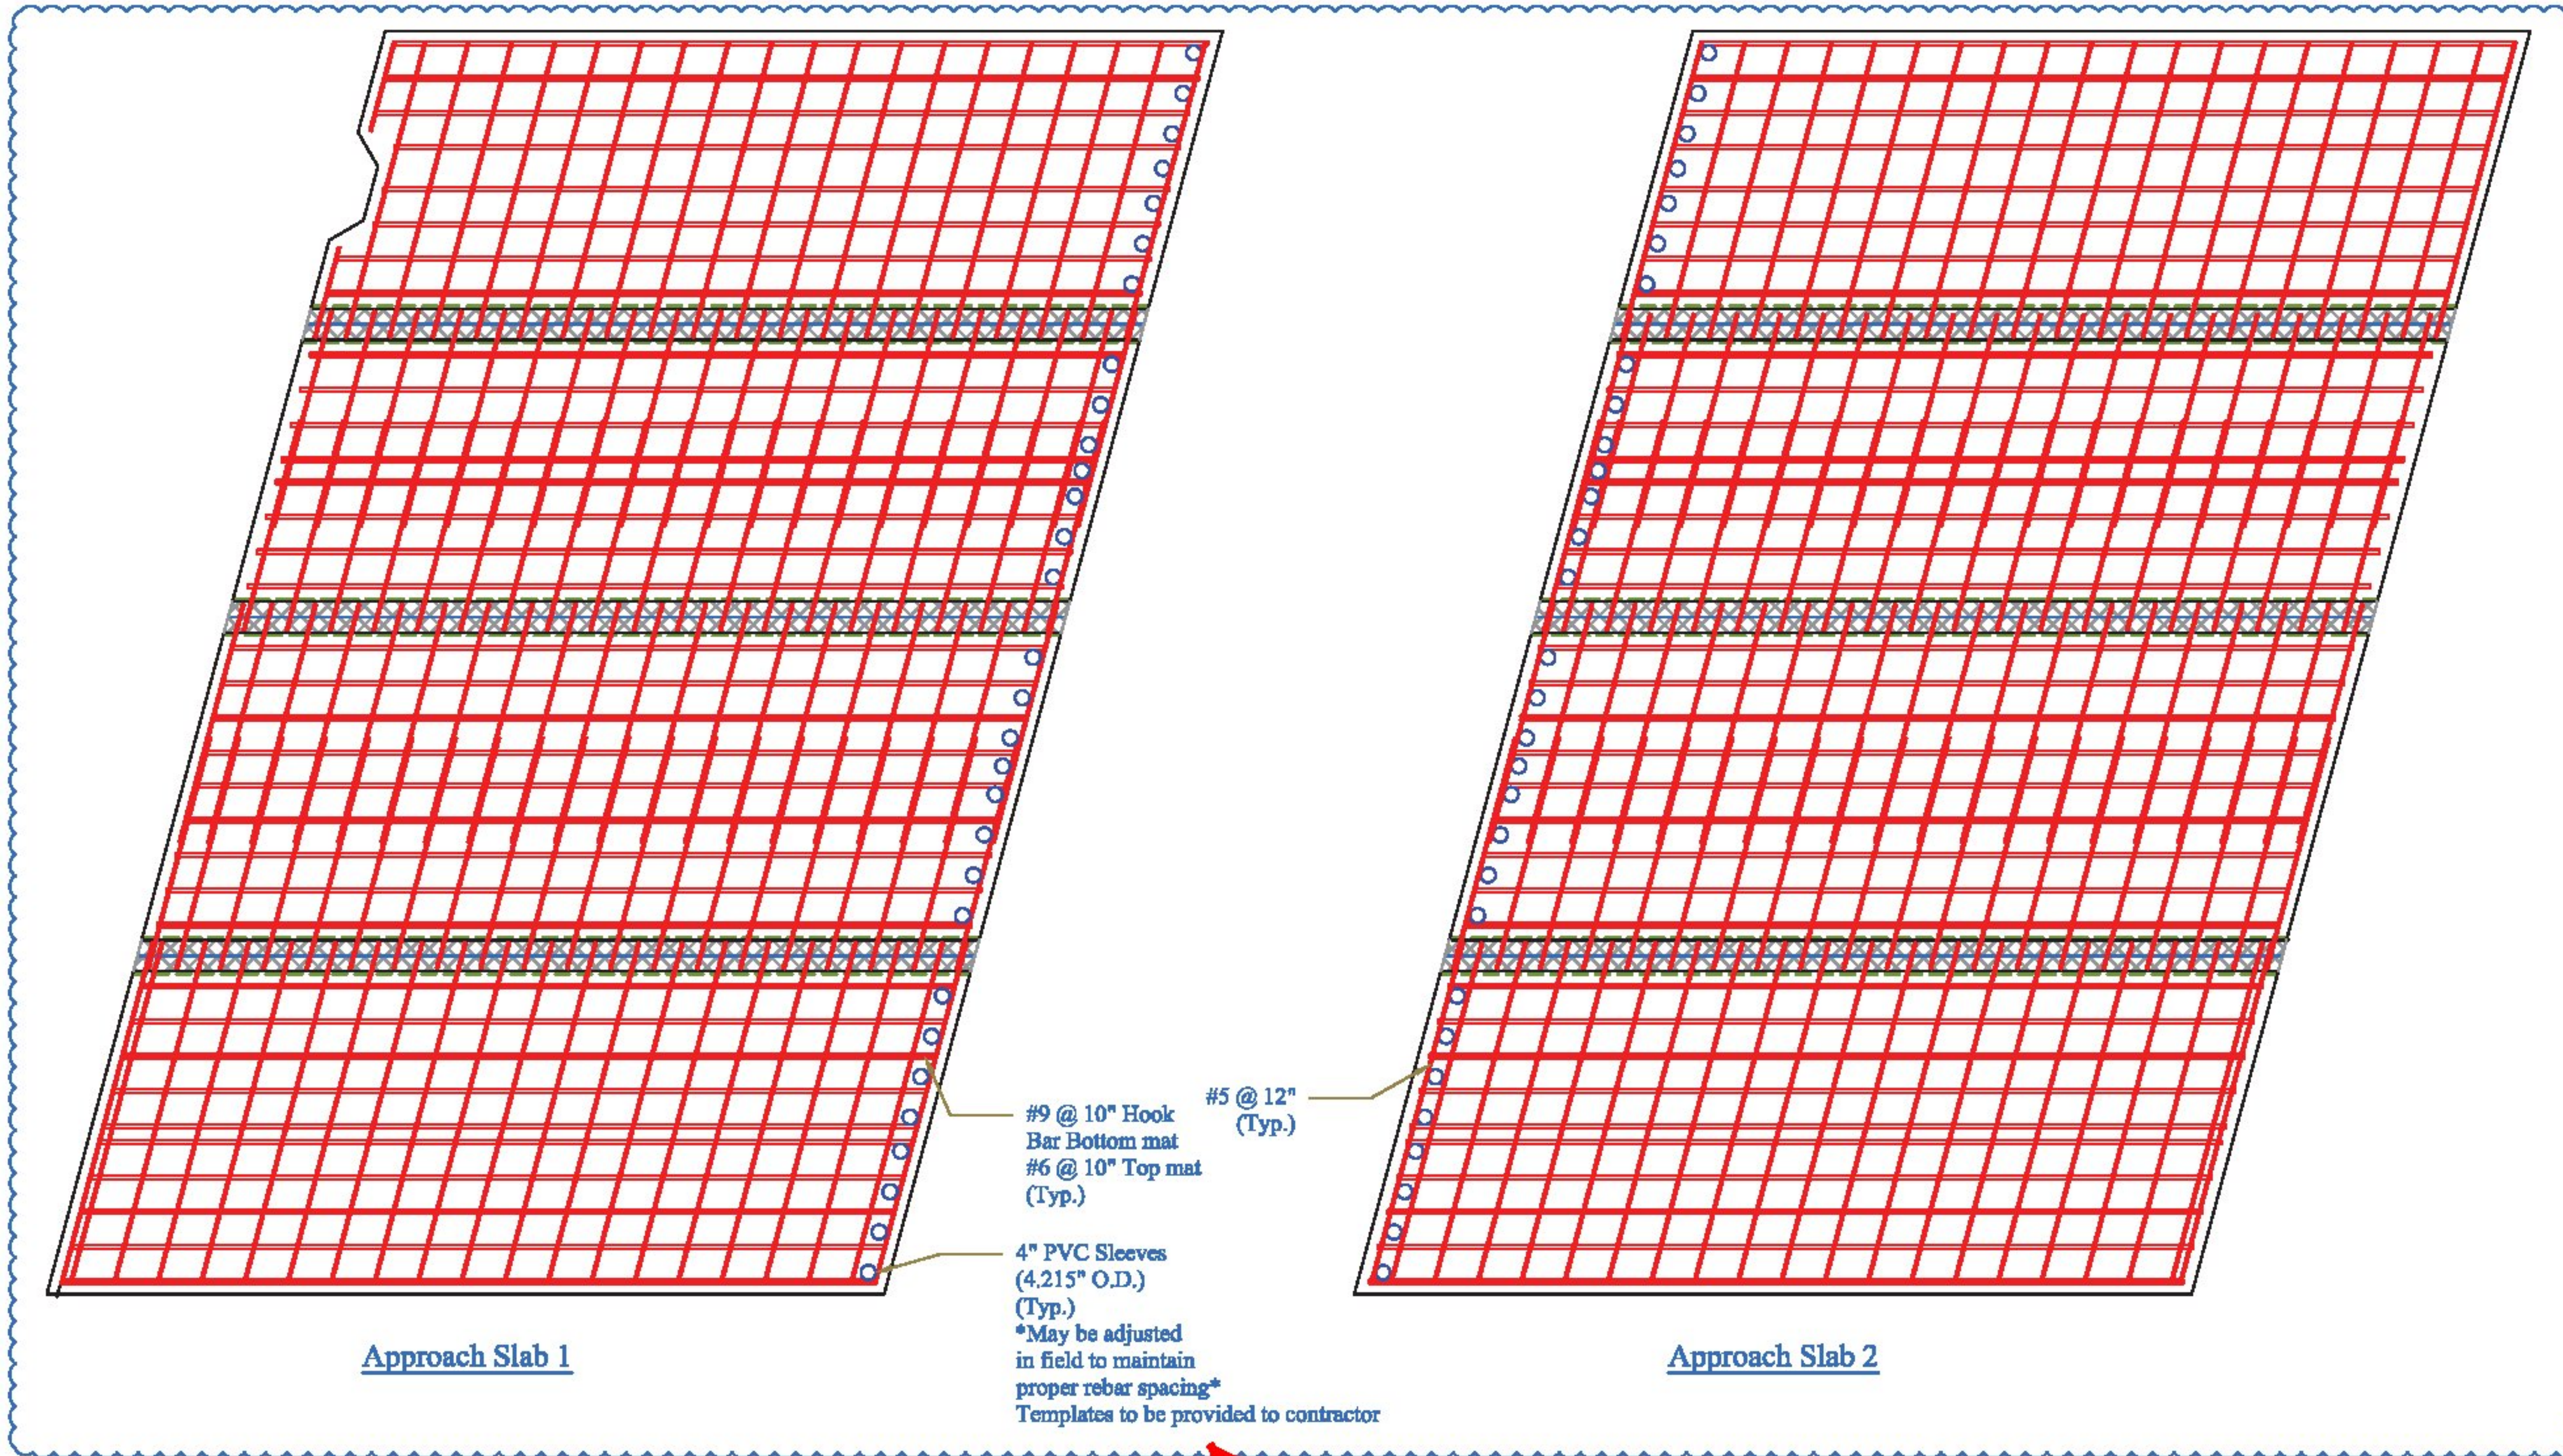

Vermont Agency of Transportation

**RECEIVED**

CK'D BY CLB

OK'D BY DRP

January 13, 2015

RESUBMIT NO  
BY C. CARLSON

Approved AsNoted  
DATE 01/15/15

PRECAST CONCRETE APPROACH SLAB SHOP DRAWINGS (SDI JOB #15163)		INSTALLER: CCS Construction 138 Munson Ave Morrisville, VT 05661 Ph: 802-888-7701	FABRICATOR: 193 INDUSTRIAL AVE. WILLISTON, VT 05495 Ph: (802) 658-0201
SUPERVISOR: M. WHEELER DETAILER: I. ADAMS CHECKER: E. Barendse ENGINEER:	PROJECT NAME: Stowe BRF 0235 (II) PROJECT #: 0235 (II) LOCATION: Stowe, VT	12/05/14	Rebar at Closure Pour

Vertical #8 bars in the cast-in-place closure pour of the abutments can be adjusted to match the pvc sleeves if necessary, but pvc sleeves cannot be adjusted once cast in the approach slab.