
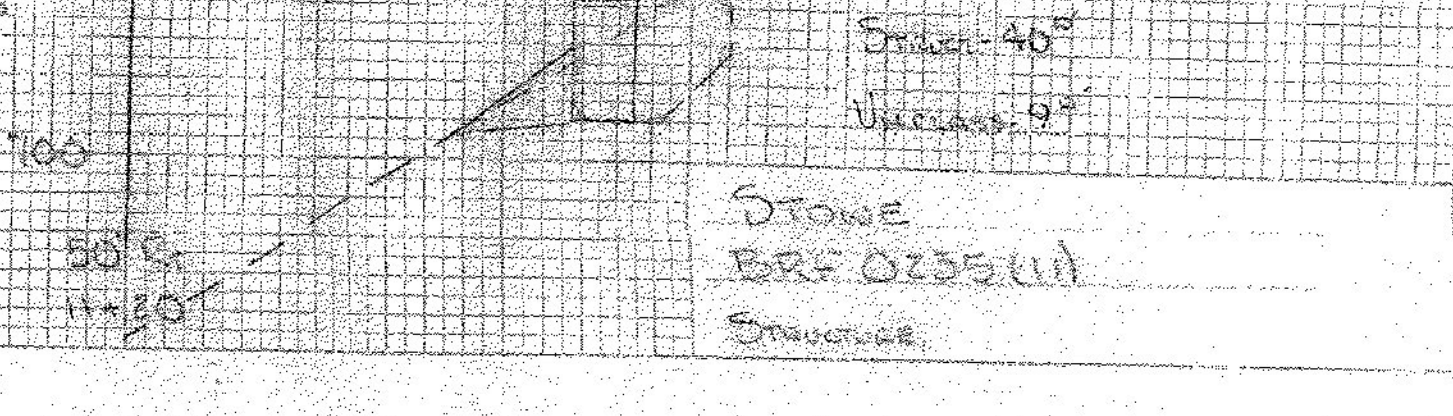
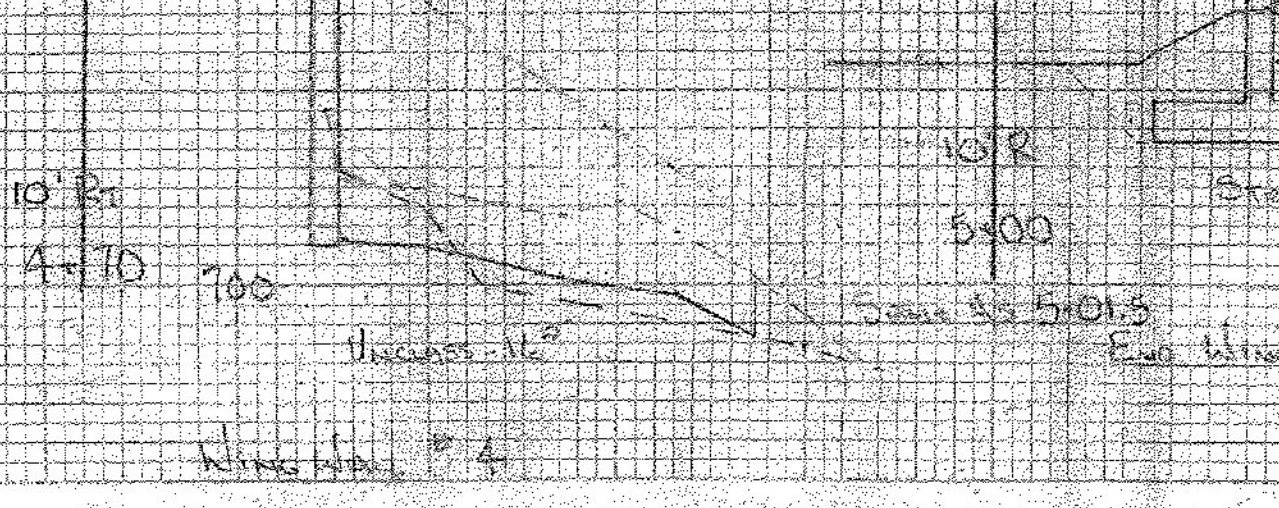
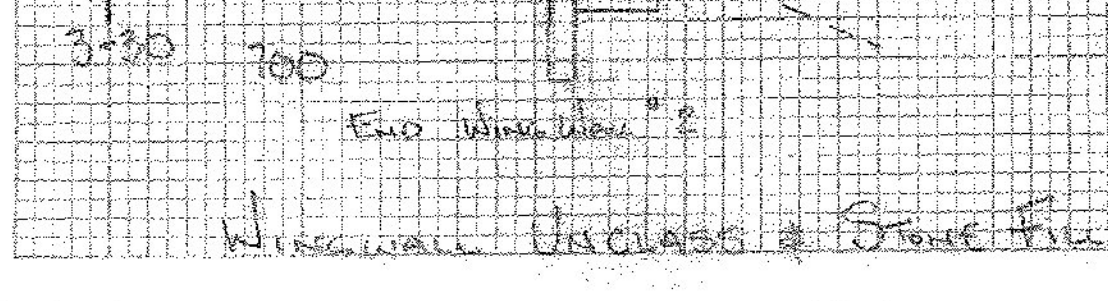
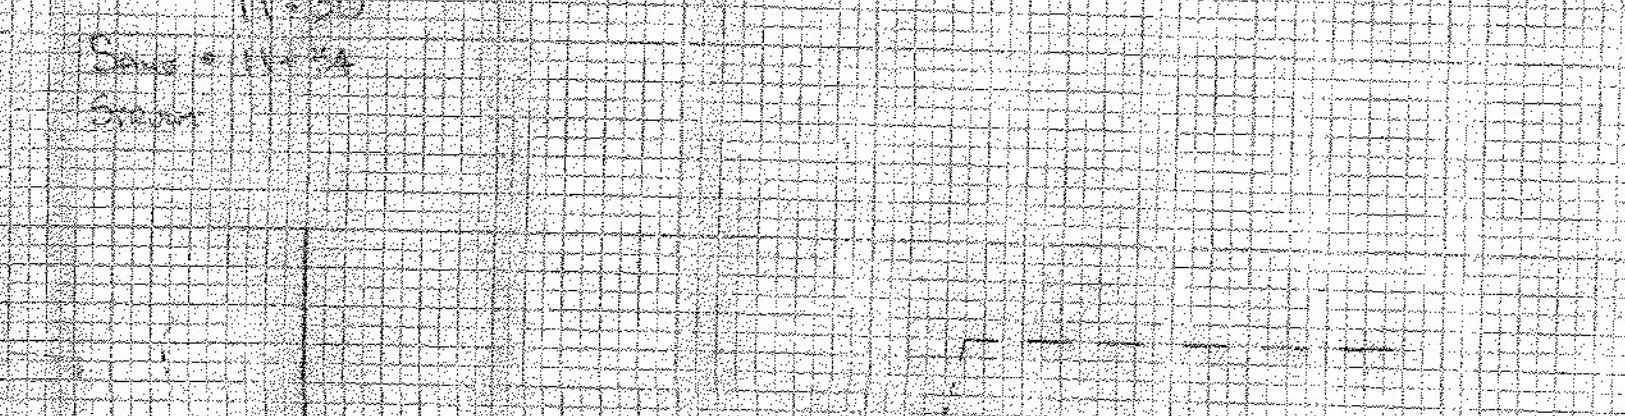
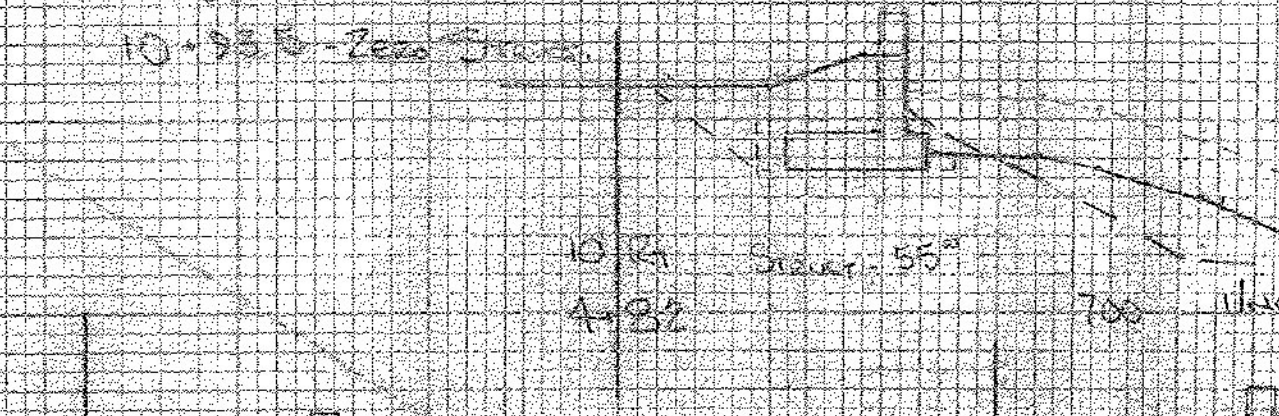
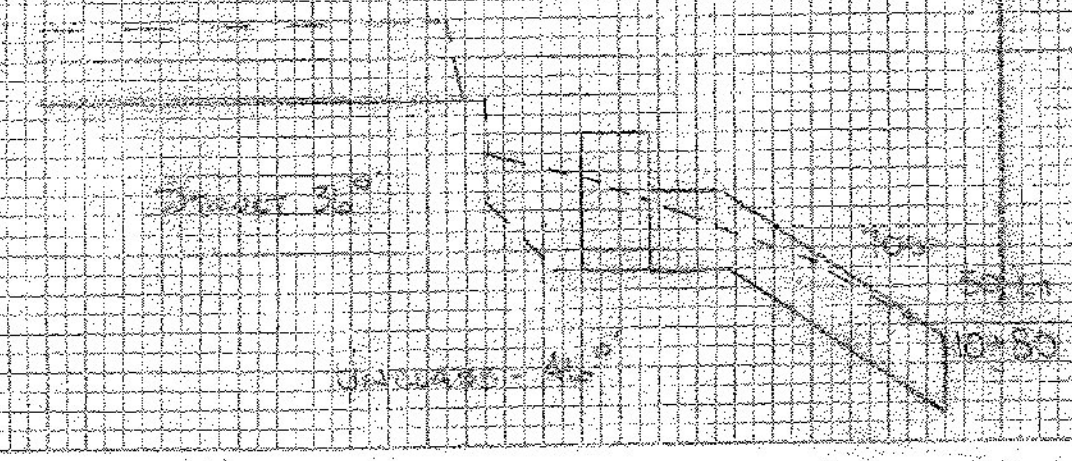
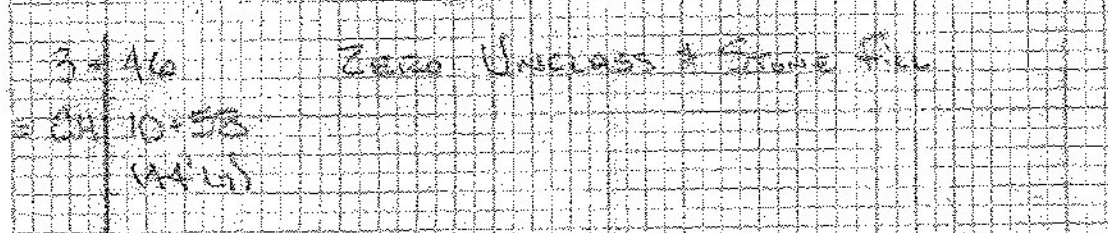
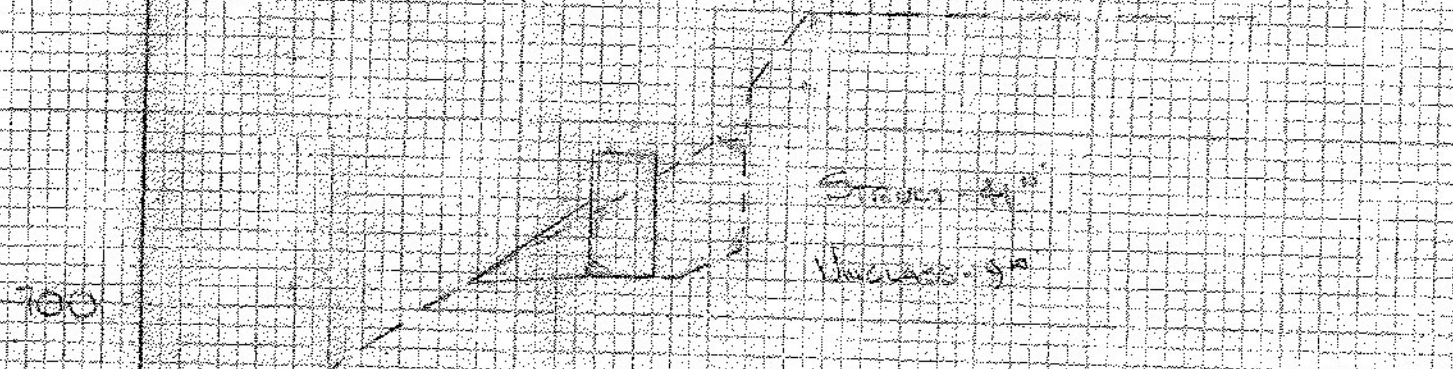
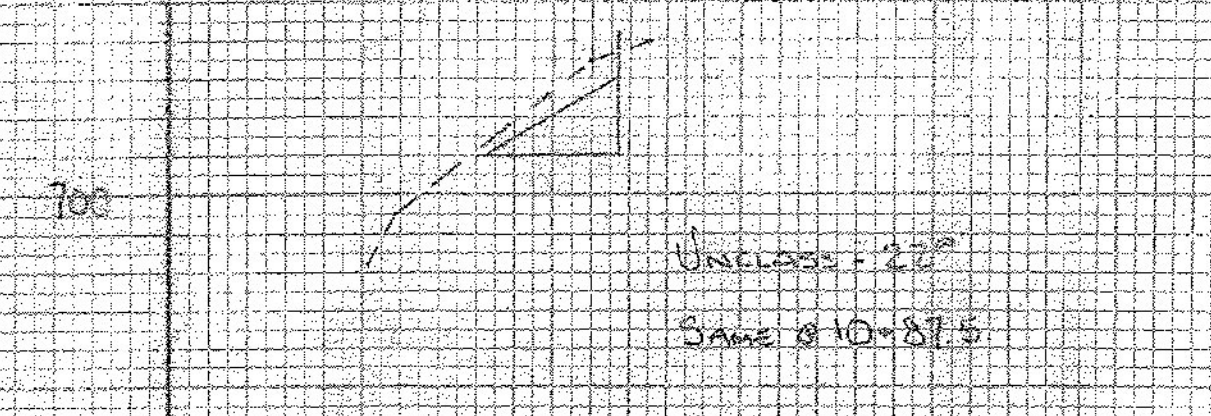
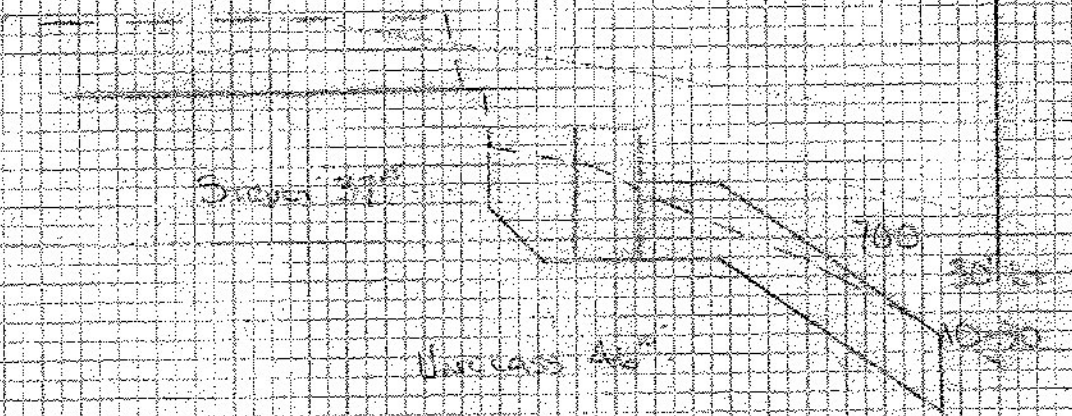
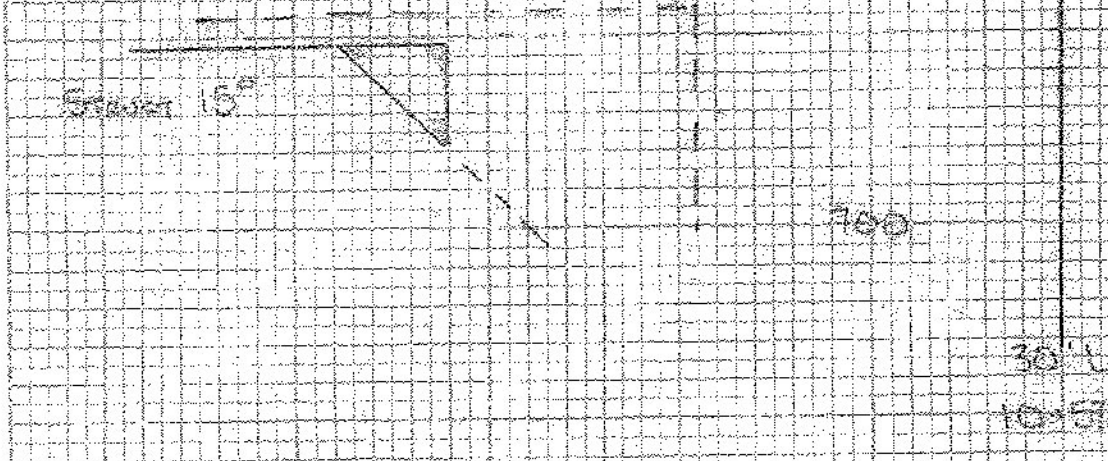
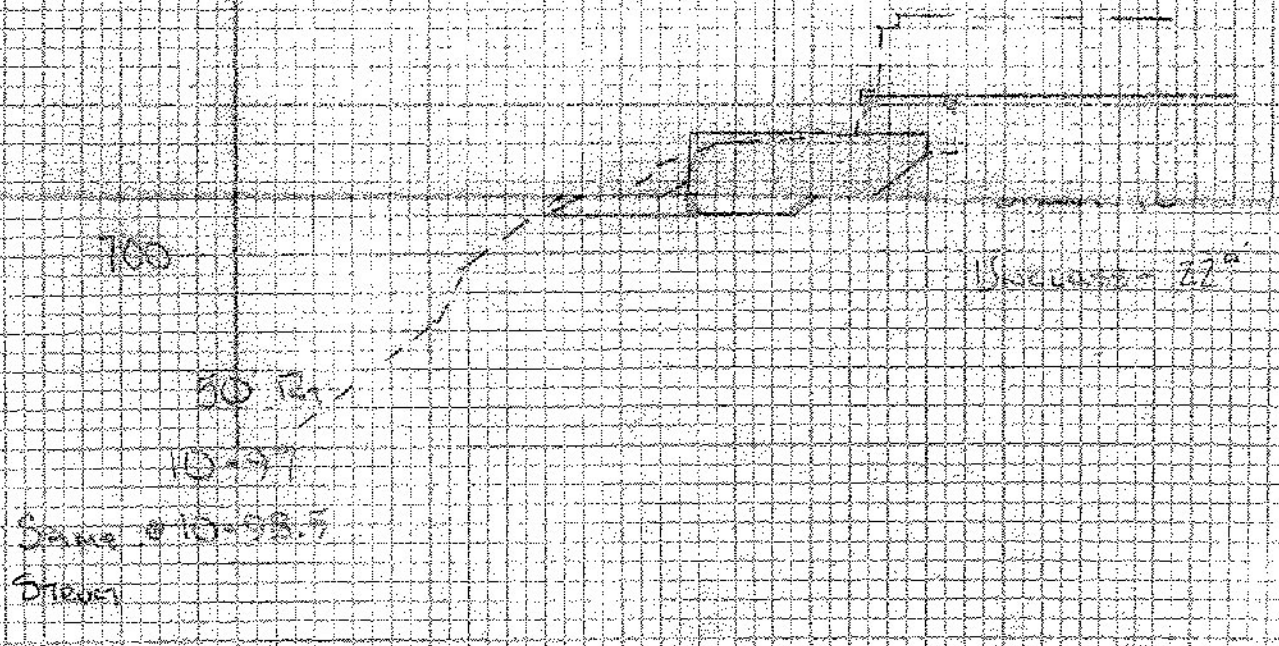
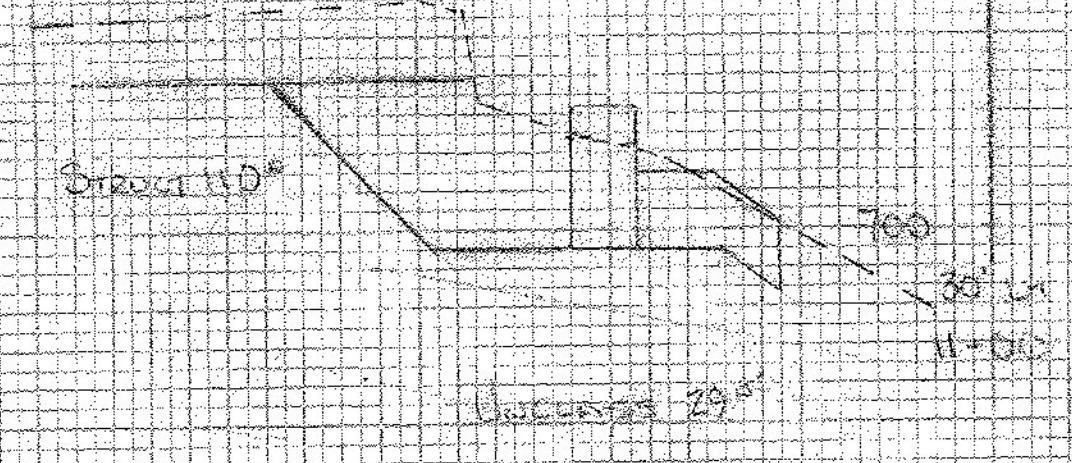
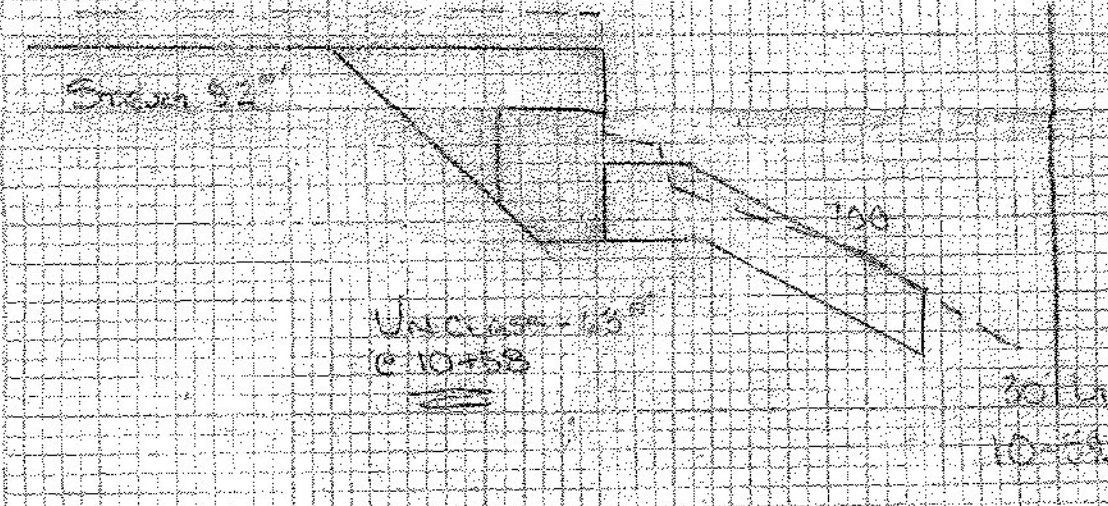
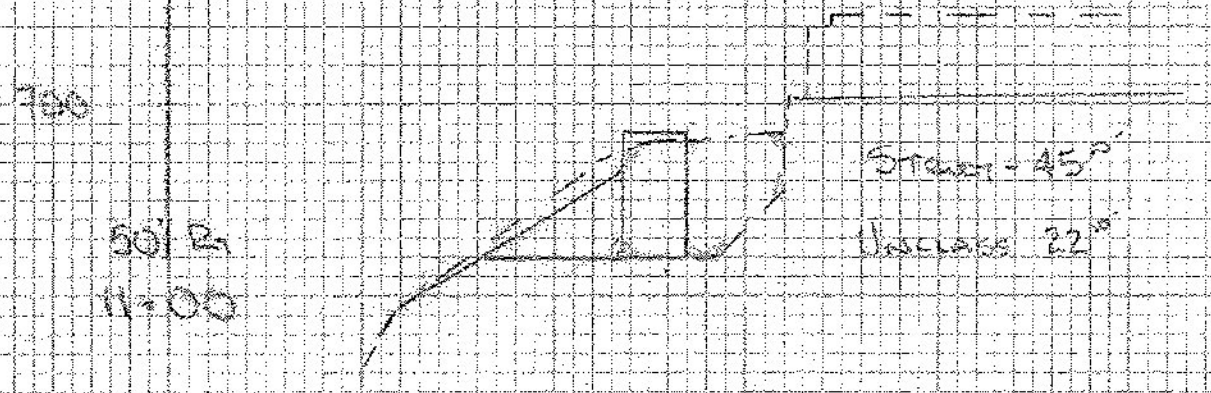
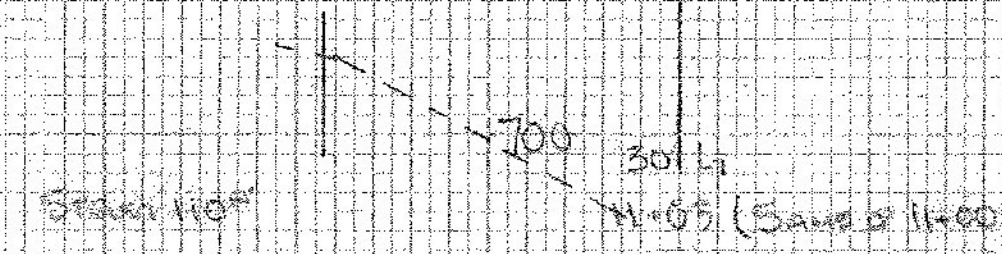
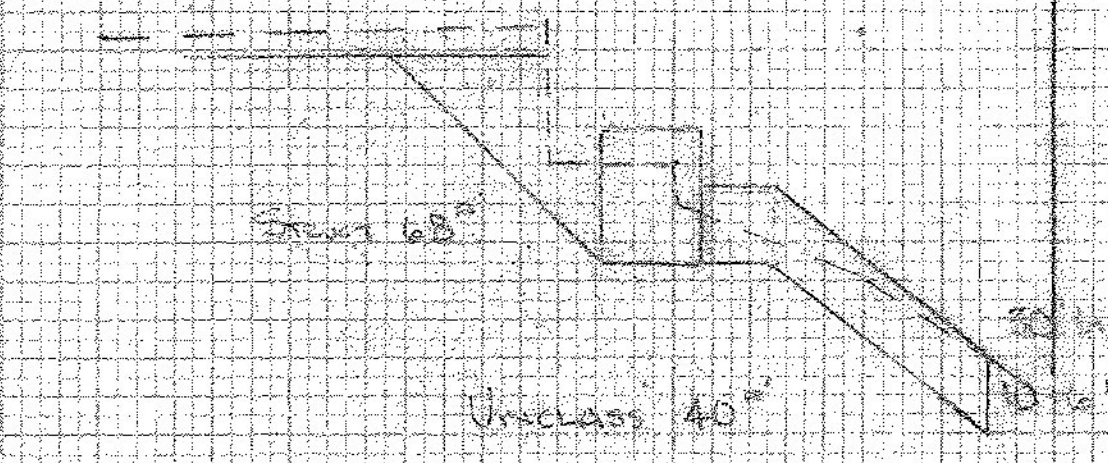
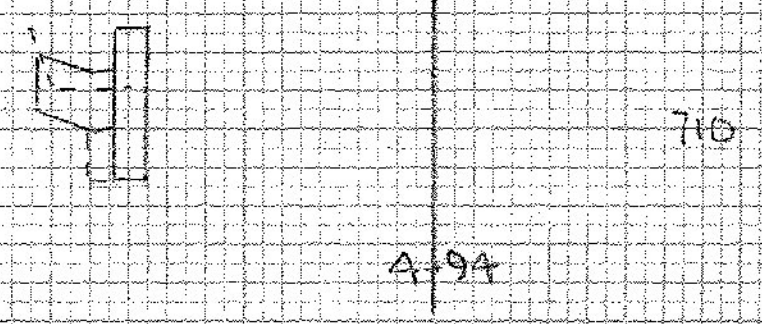
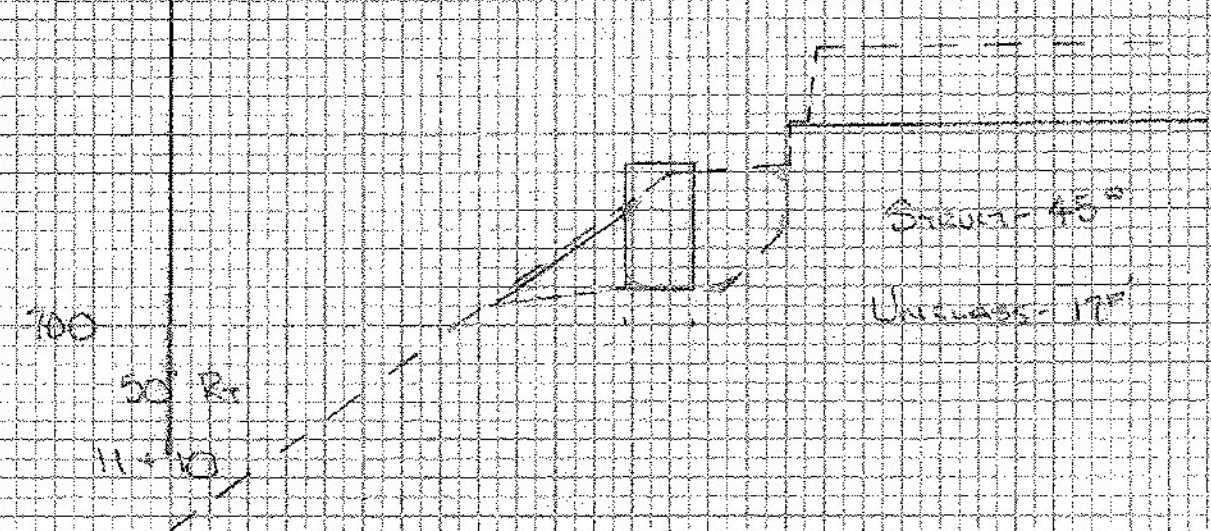
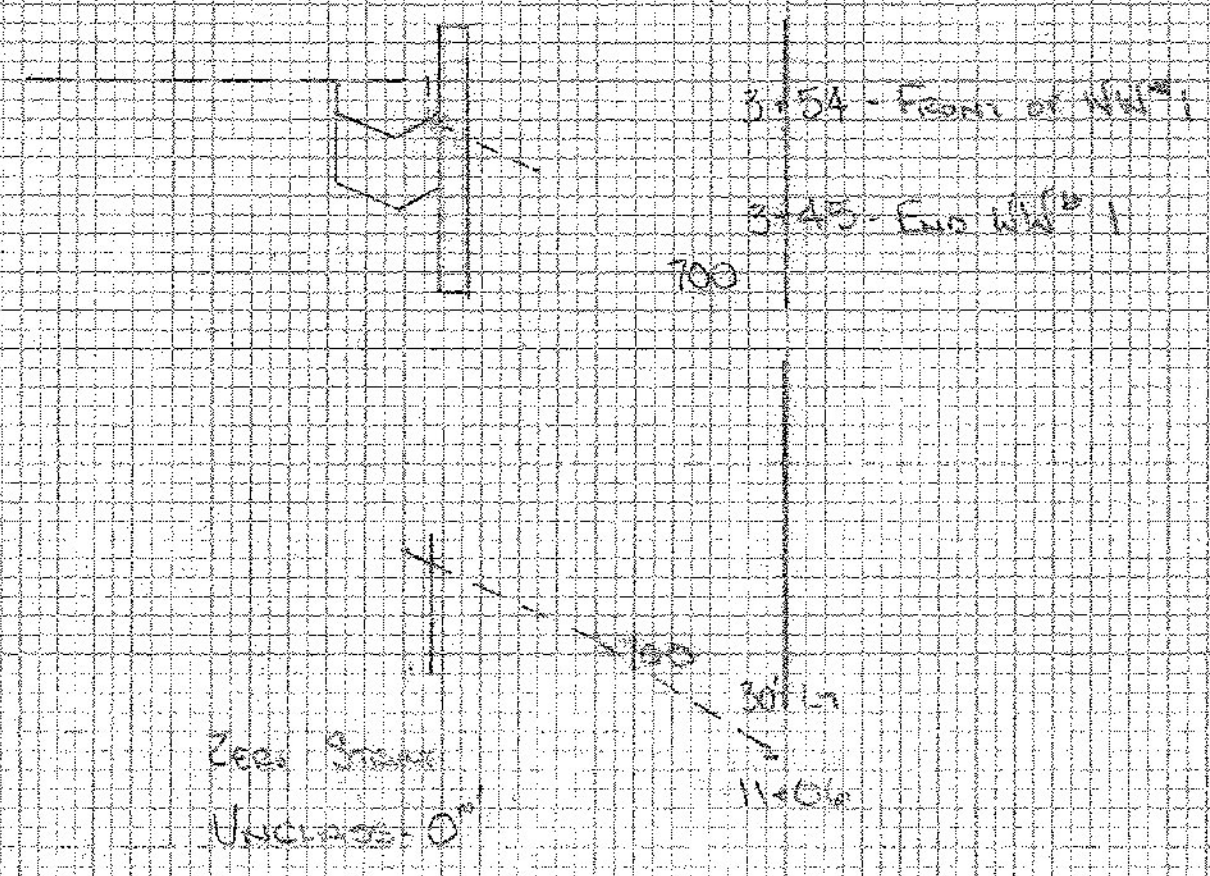


DATE	
BY	
CHECKED	
APPROVED	
SCALE	

NO. OF RIBS	
SPACING	
WIDTH	
DEPTH	
REINFORCEMENT	
SCALE	

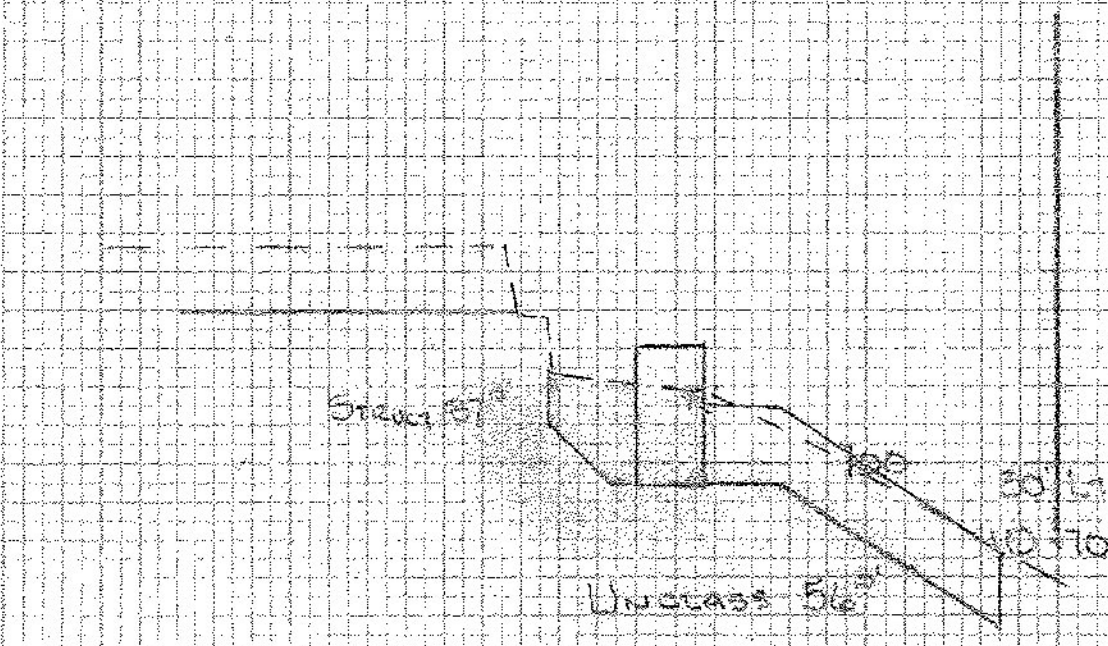

STONE BR 0235(11)
STRUCTURE