


Plan View

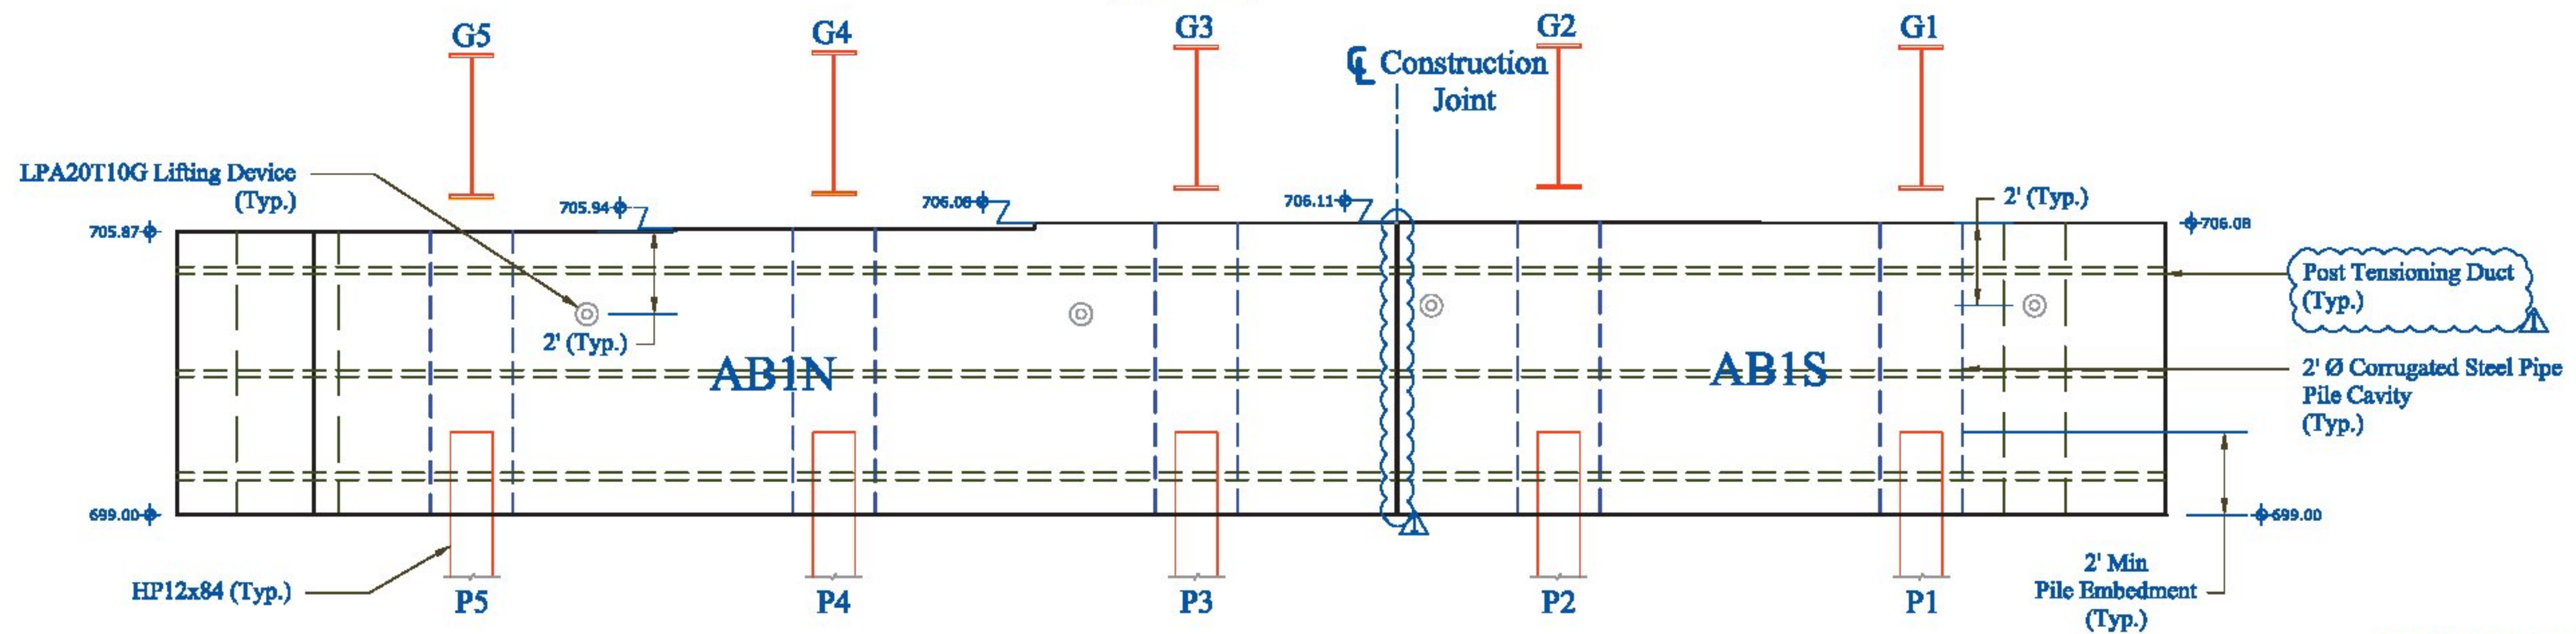

Elevation View


AB1N: 84,926 lbs
AB1S: 62,374 lbs

Vermont Agency of Transportation
RECEIVED

CK'D BY CLB OK'D BY DRP

January 13, 2015

RESUBMIT NO Approved
BY C. CARLSON DATE 01/15/15

:rw	PRECAST CONCRETE ABUTMENT SHOP DRAWINGS (SDI JOB #15163)		INSTALLER: CCS Construction 139 Munson Ave Morrisville, VT 05661 PH: 802-888-7701	FABRICATOR: 193 INDUSTRIAL AVE. WILLISTON, VT 05495 PH: (802) 658-0201
	SUPERVISOR: M. WHEELER	PROJECT NAME: Stowe BR# 0235 (II)	SD  Precast Division	
DETAILER: I. ADAMS	PROJECT # 0235 (II)	01/08/15		
CHECKER: E. Barendse	LOCATION: Stowe, VT	2 of 11		
ENGINEER:				