




Match Cast Joint Detail

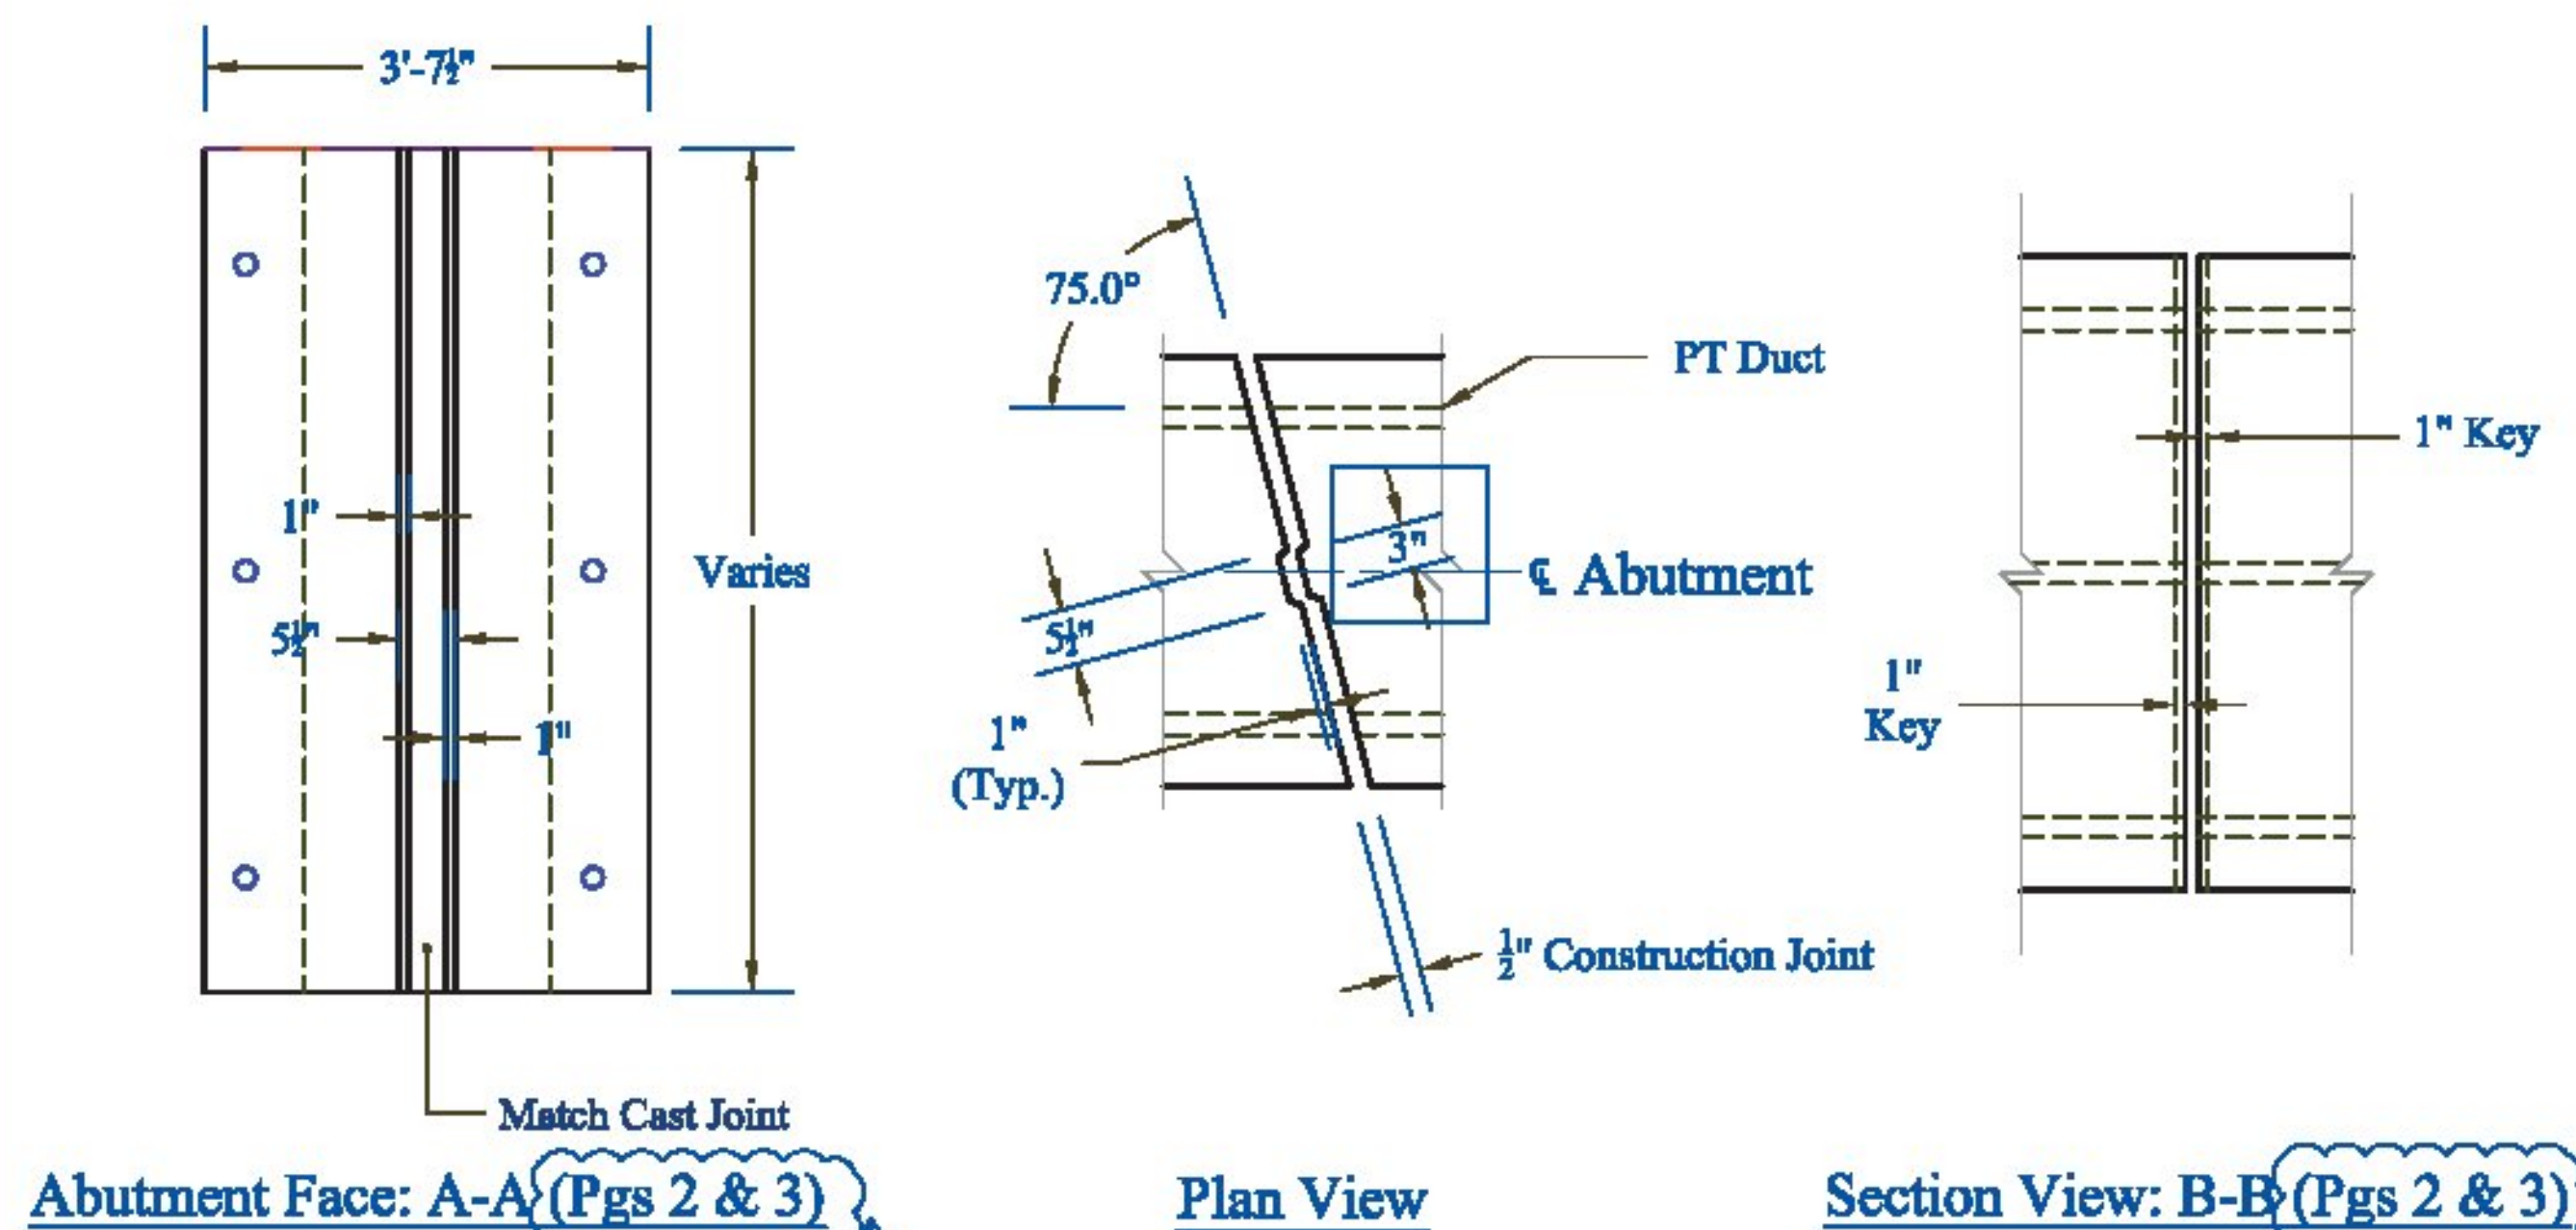


Abutment 1 & 2: Typical Section

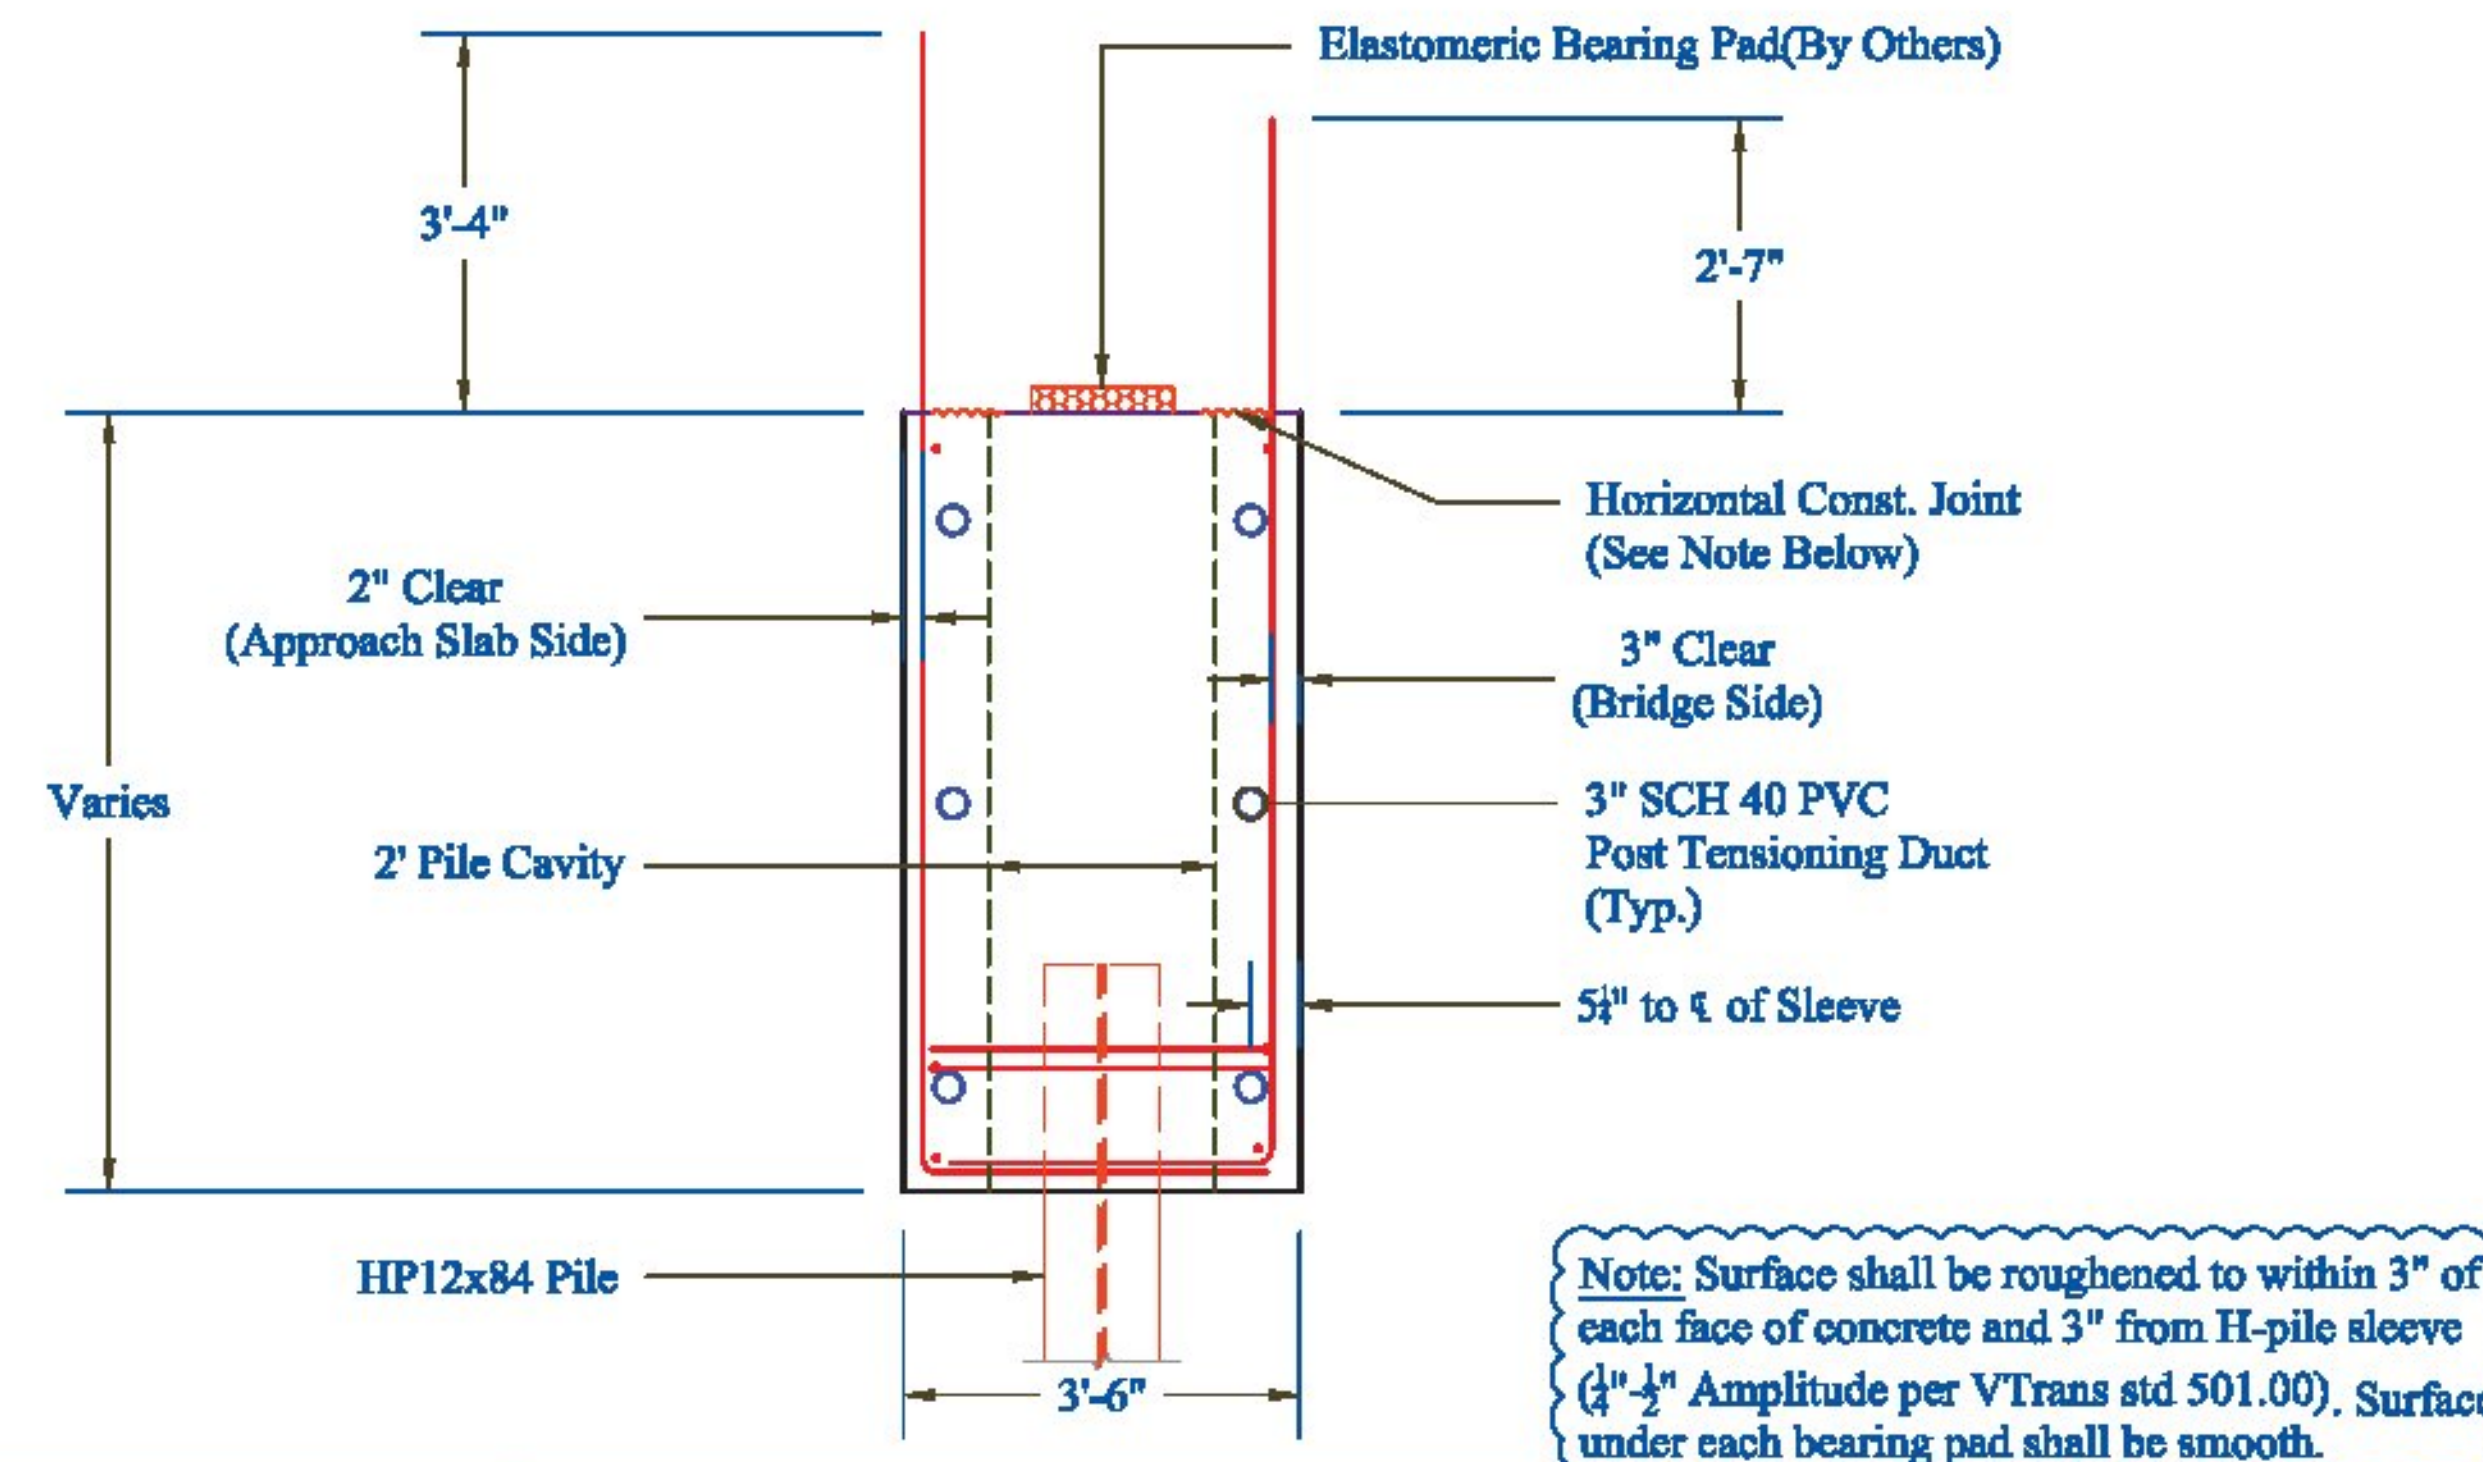

Wingwall Grout Sleeve Detail

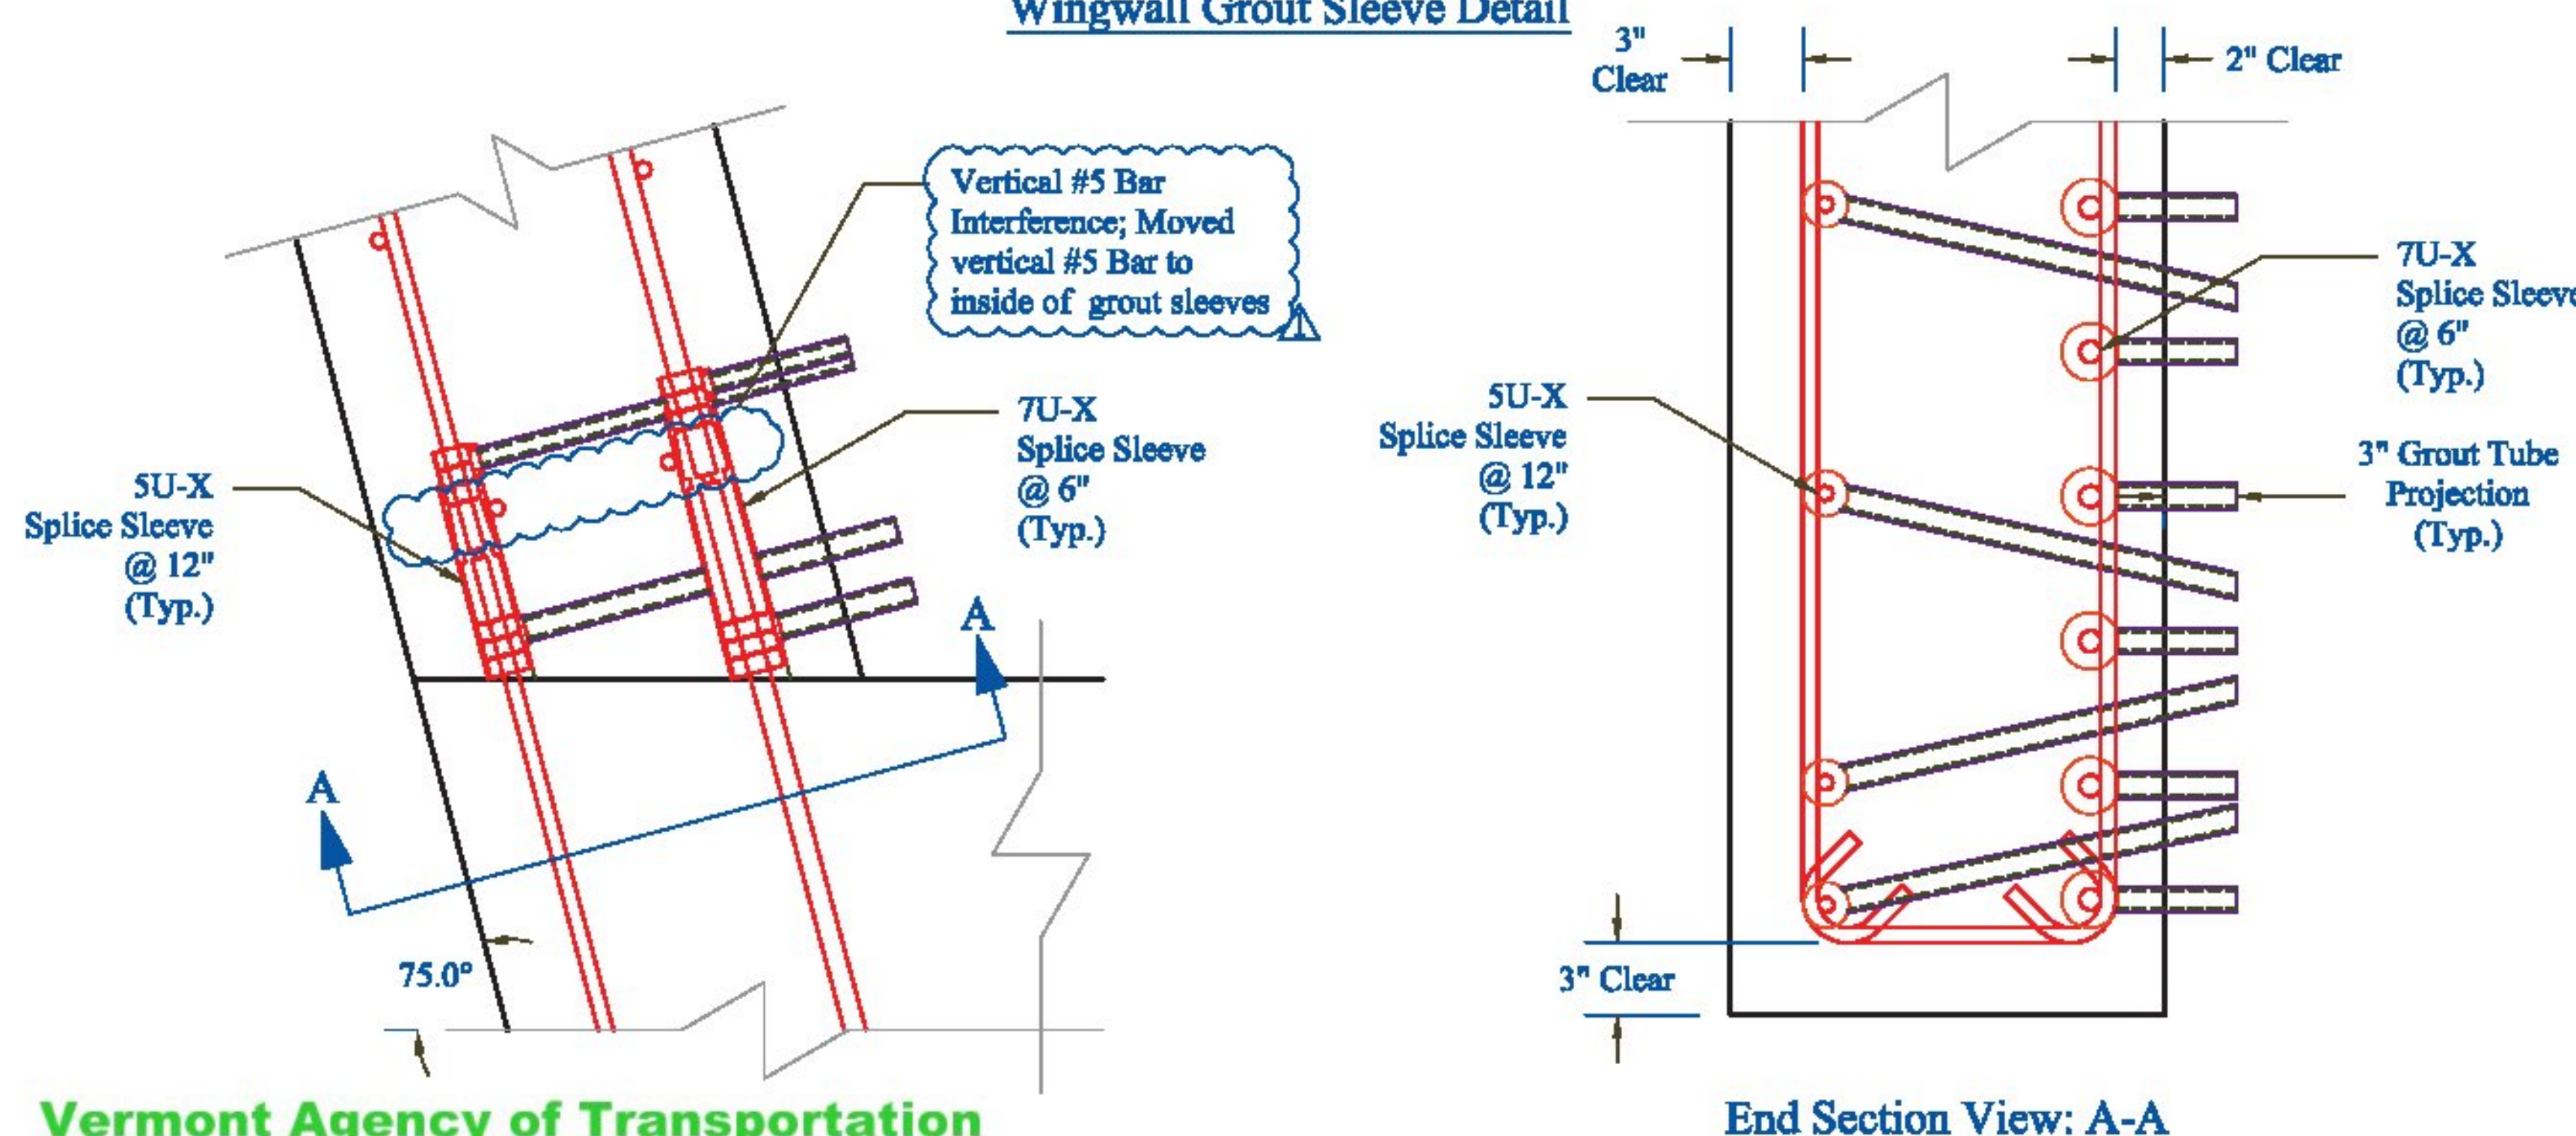

Wingwall 1 - 4: Typical Section

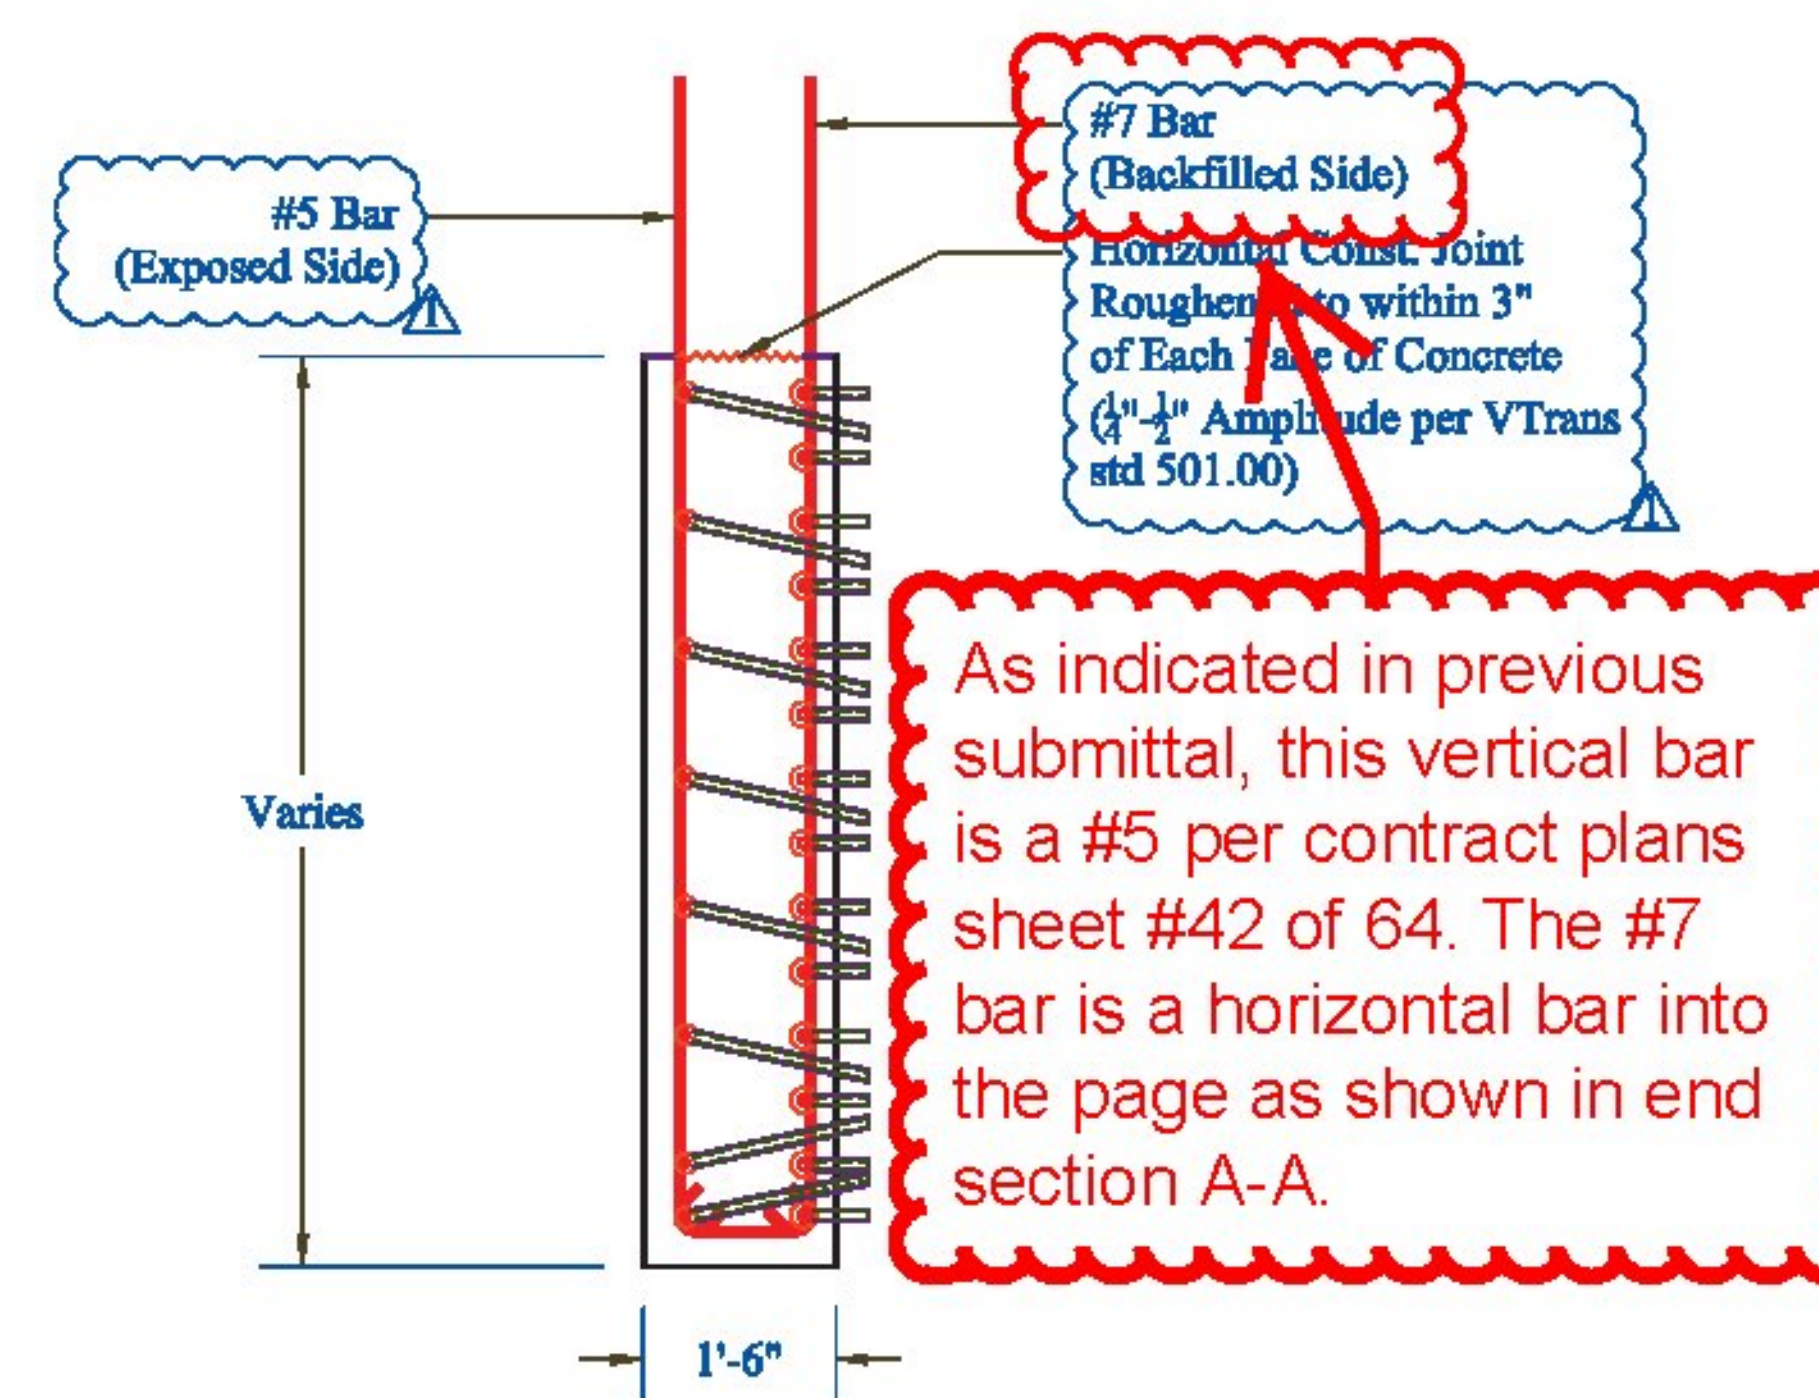

Vermont Agency of Transportation

RECEIVED

CK'D BY CLB OK'D BY DRP

January 13, 2015

RESUBMIT NO Approved AsNoted
BY C. CARLSON DATE 01/15/15

Review	PRECAST CONCRETE ABUTMENT SHOP DRAWINGS (SDI JOB #15163) SUPERVISOR: M. WHEELER DETAILER: I. ADAMS CHECKER: E. Barendse ENGINEER:	PROJECT NAME: Stowe BR# 0235 (II) PROJECT # 0235 (II) LOCATION: Stowe, VT	INSTALLER: CCS Construction 138 Munson Ave Morrisville, VT 05661 PH: 802-888-7701 01/08/15	FABRICATOR: 193 INDUSTRIAL AVE. WILLISTON, VT 05495 PH: (802) 658-0201 Wing Wall & Abutment Details	6 of 11
--------	---	--	---	---	---------

