



Retaining Wall Elevation

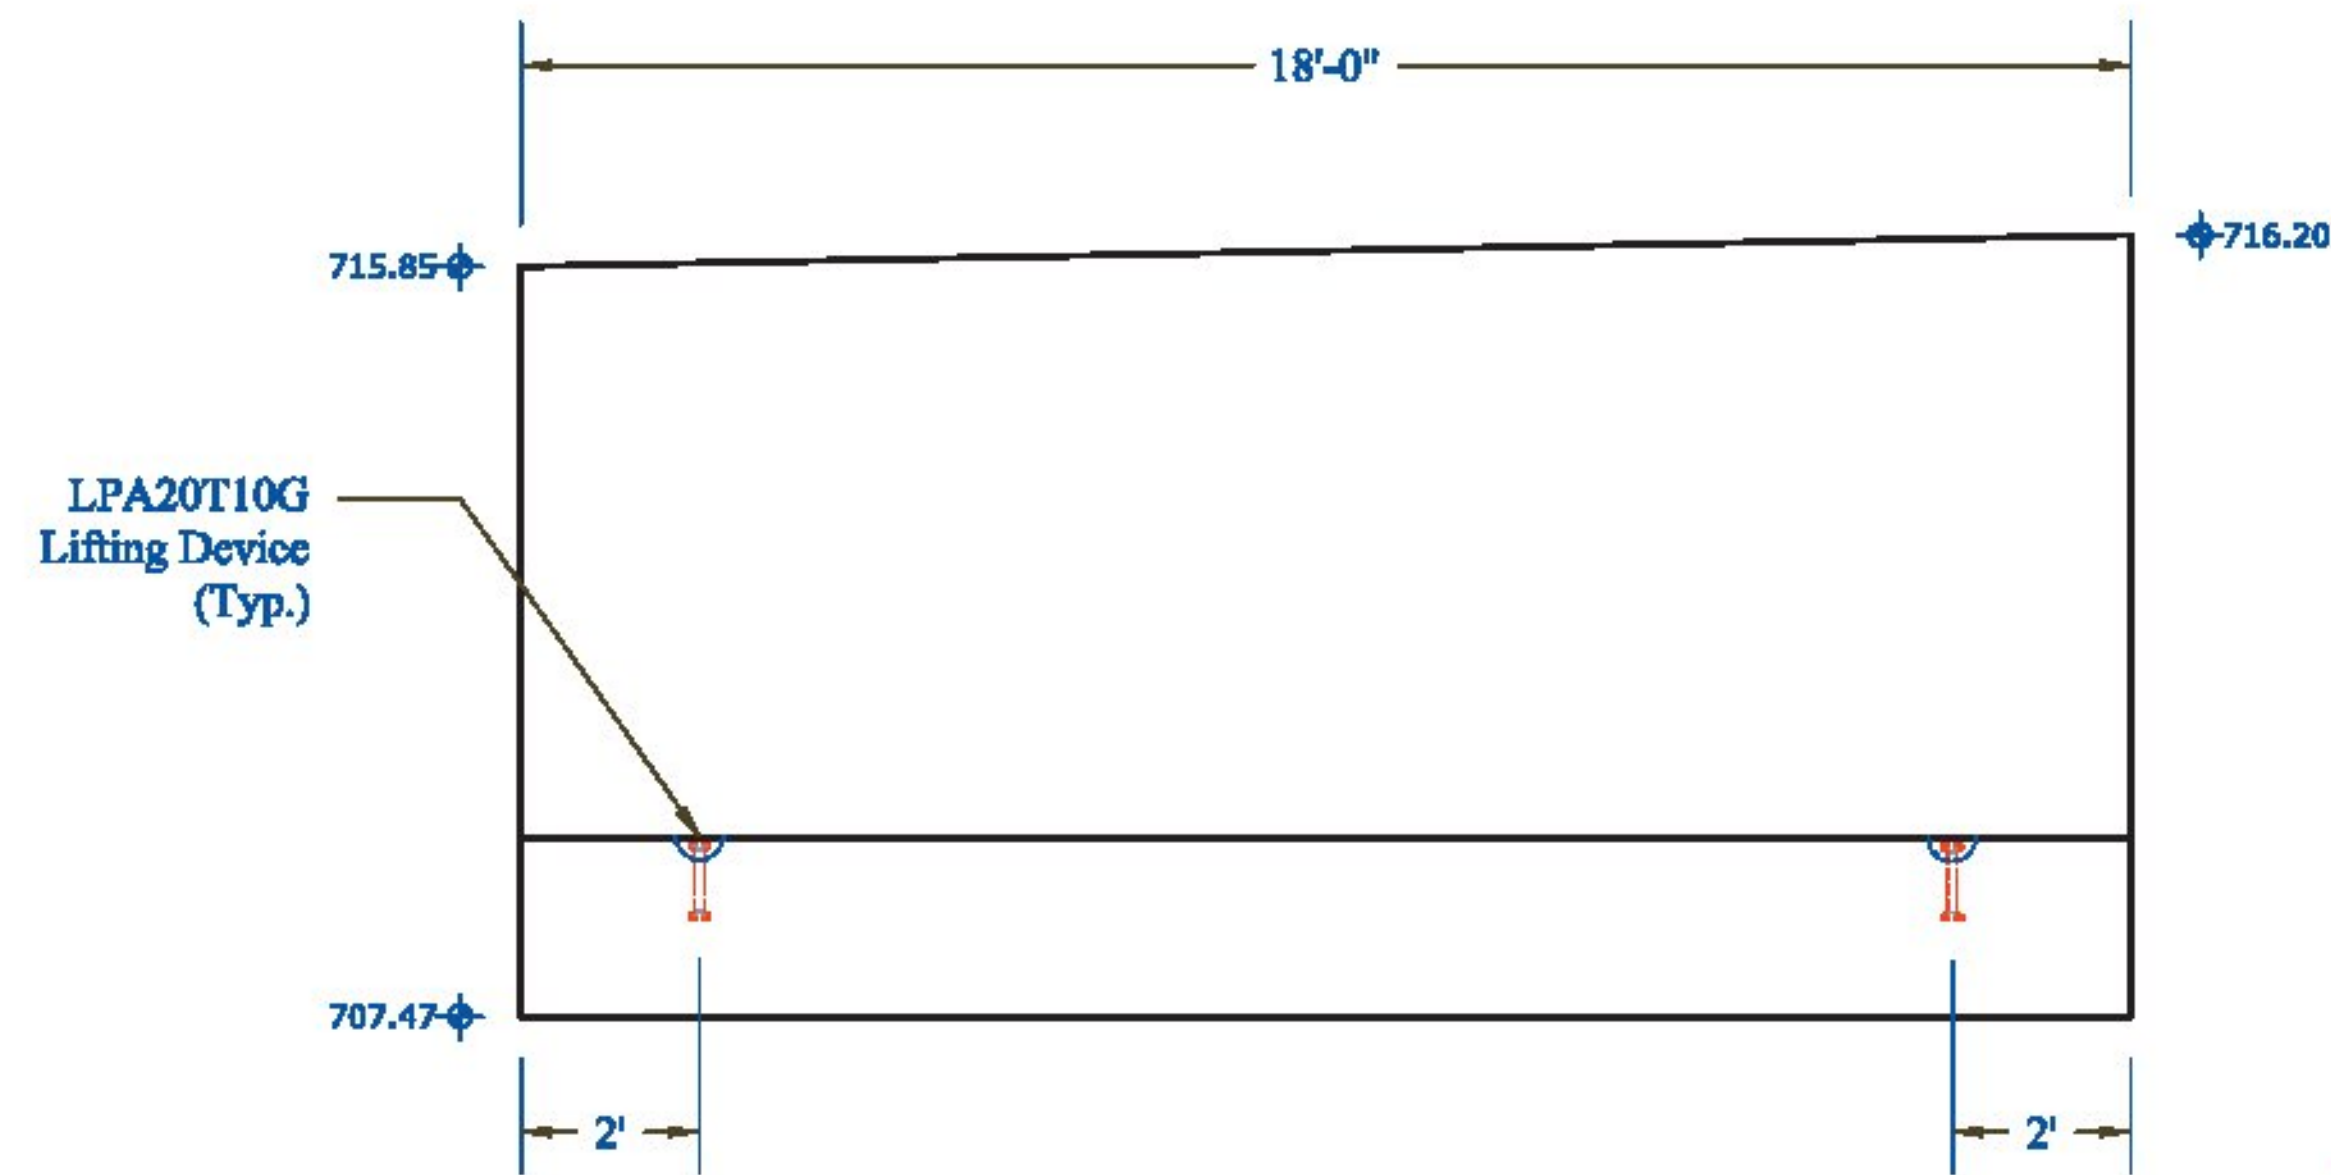


Retaining Wall Typical Section

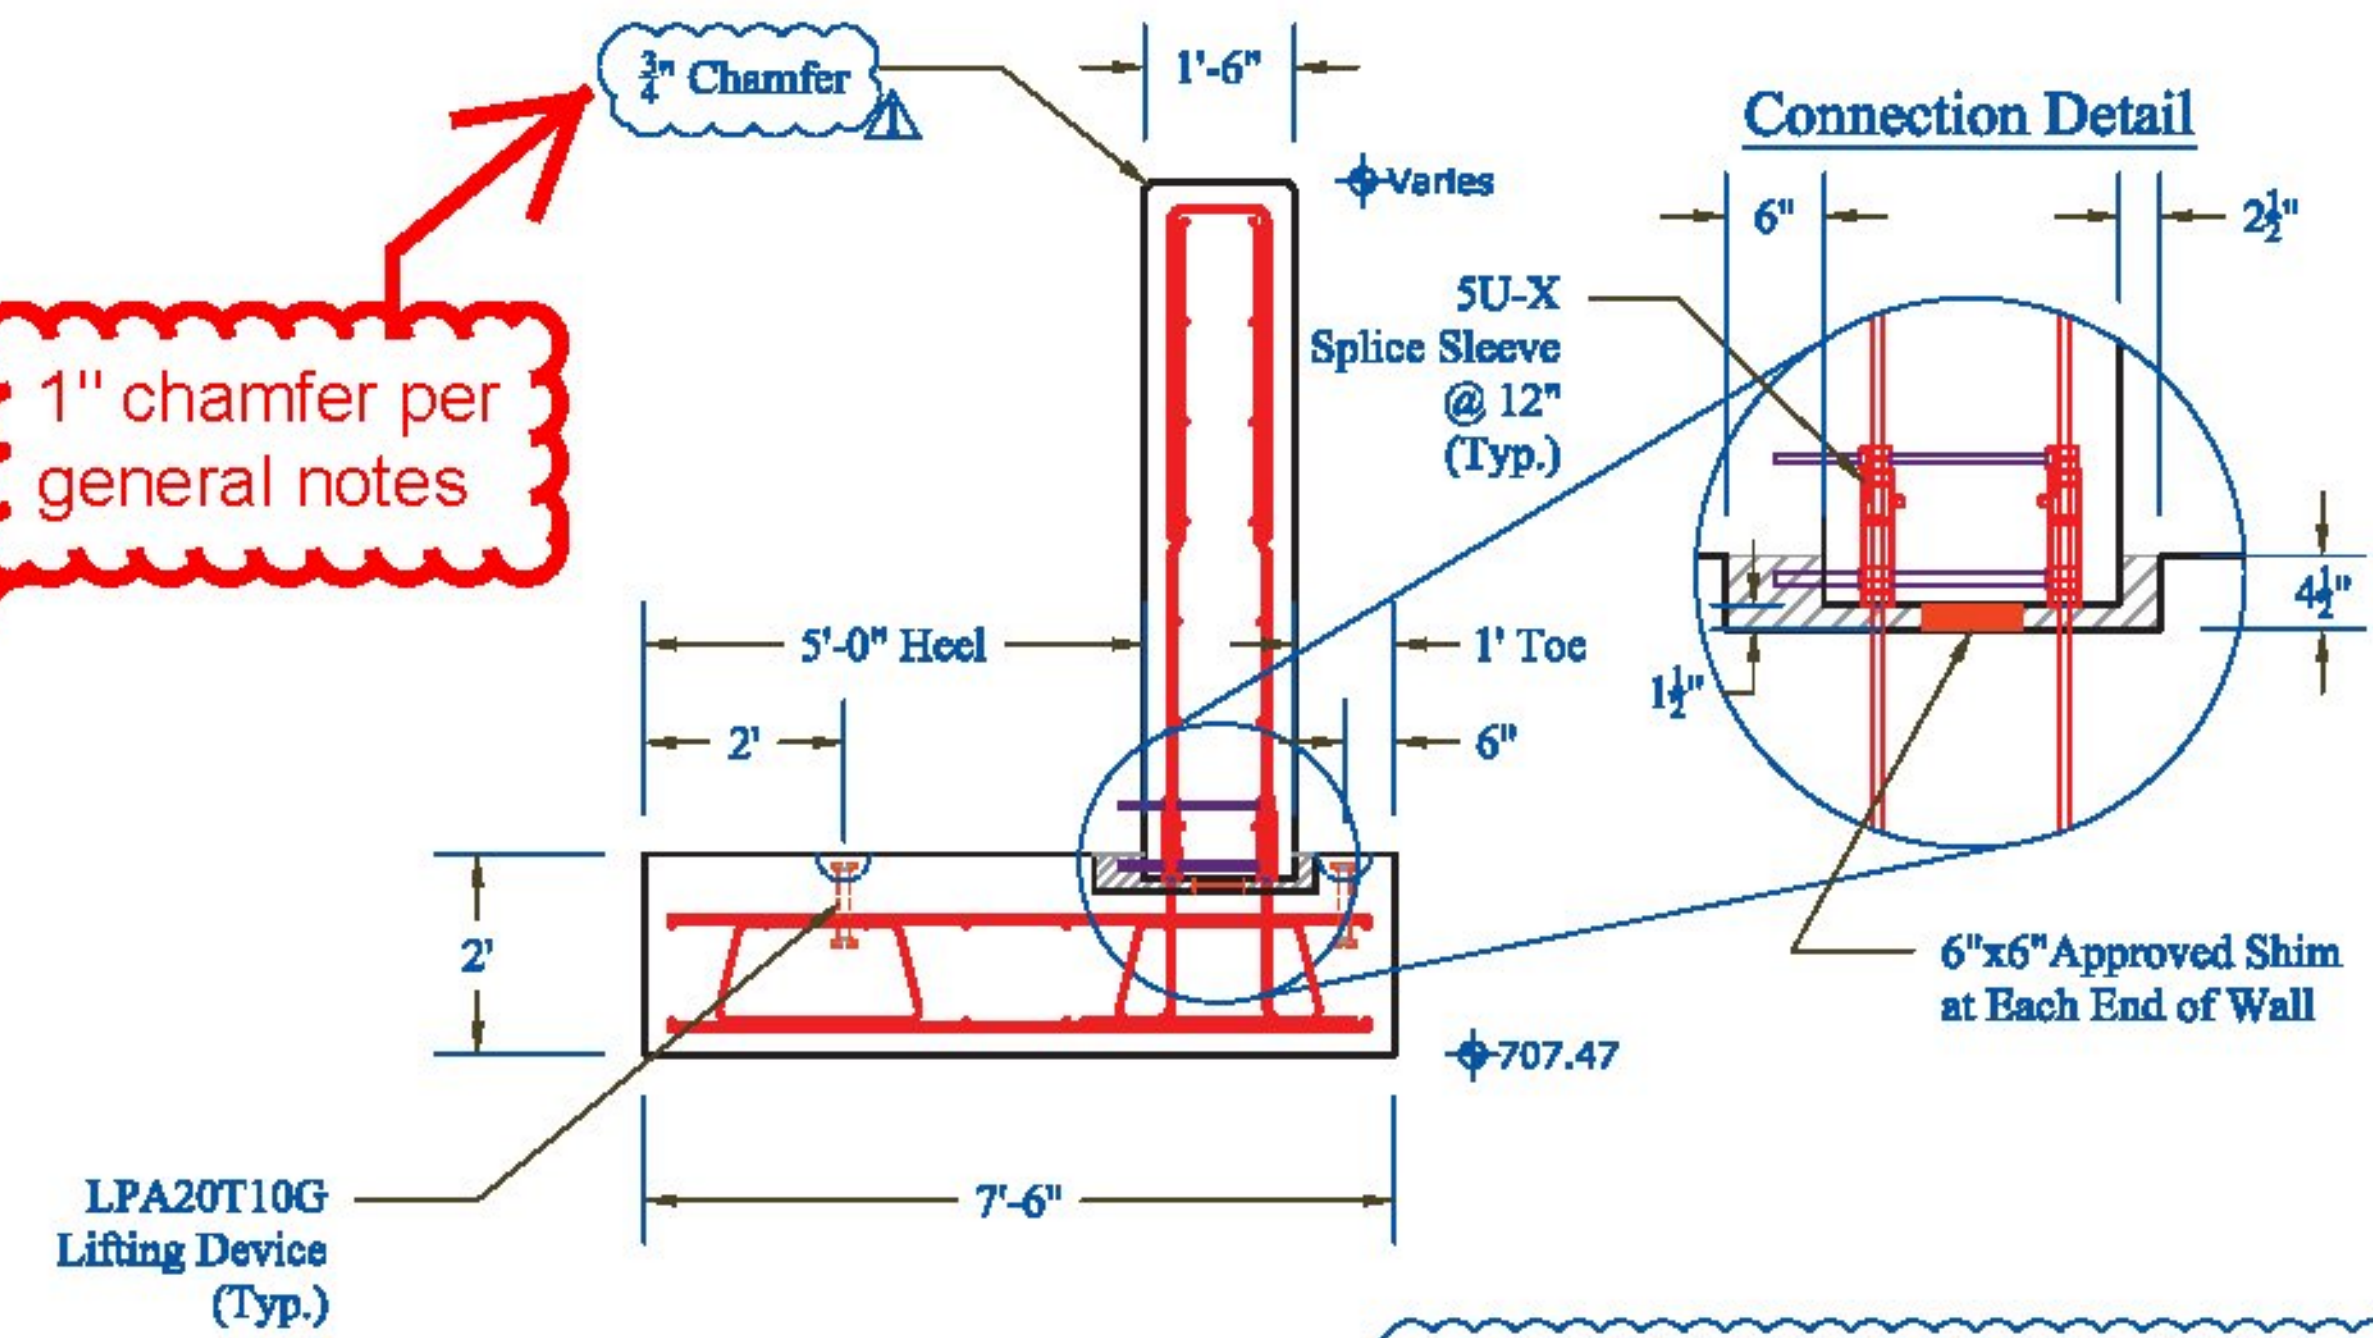


\*See reinforcing sheet K for bar size/I.D.\*

Retaining Wall Stem

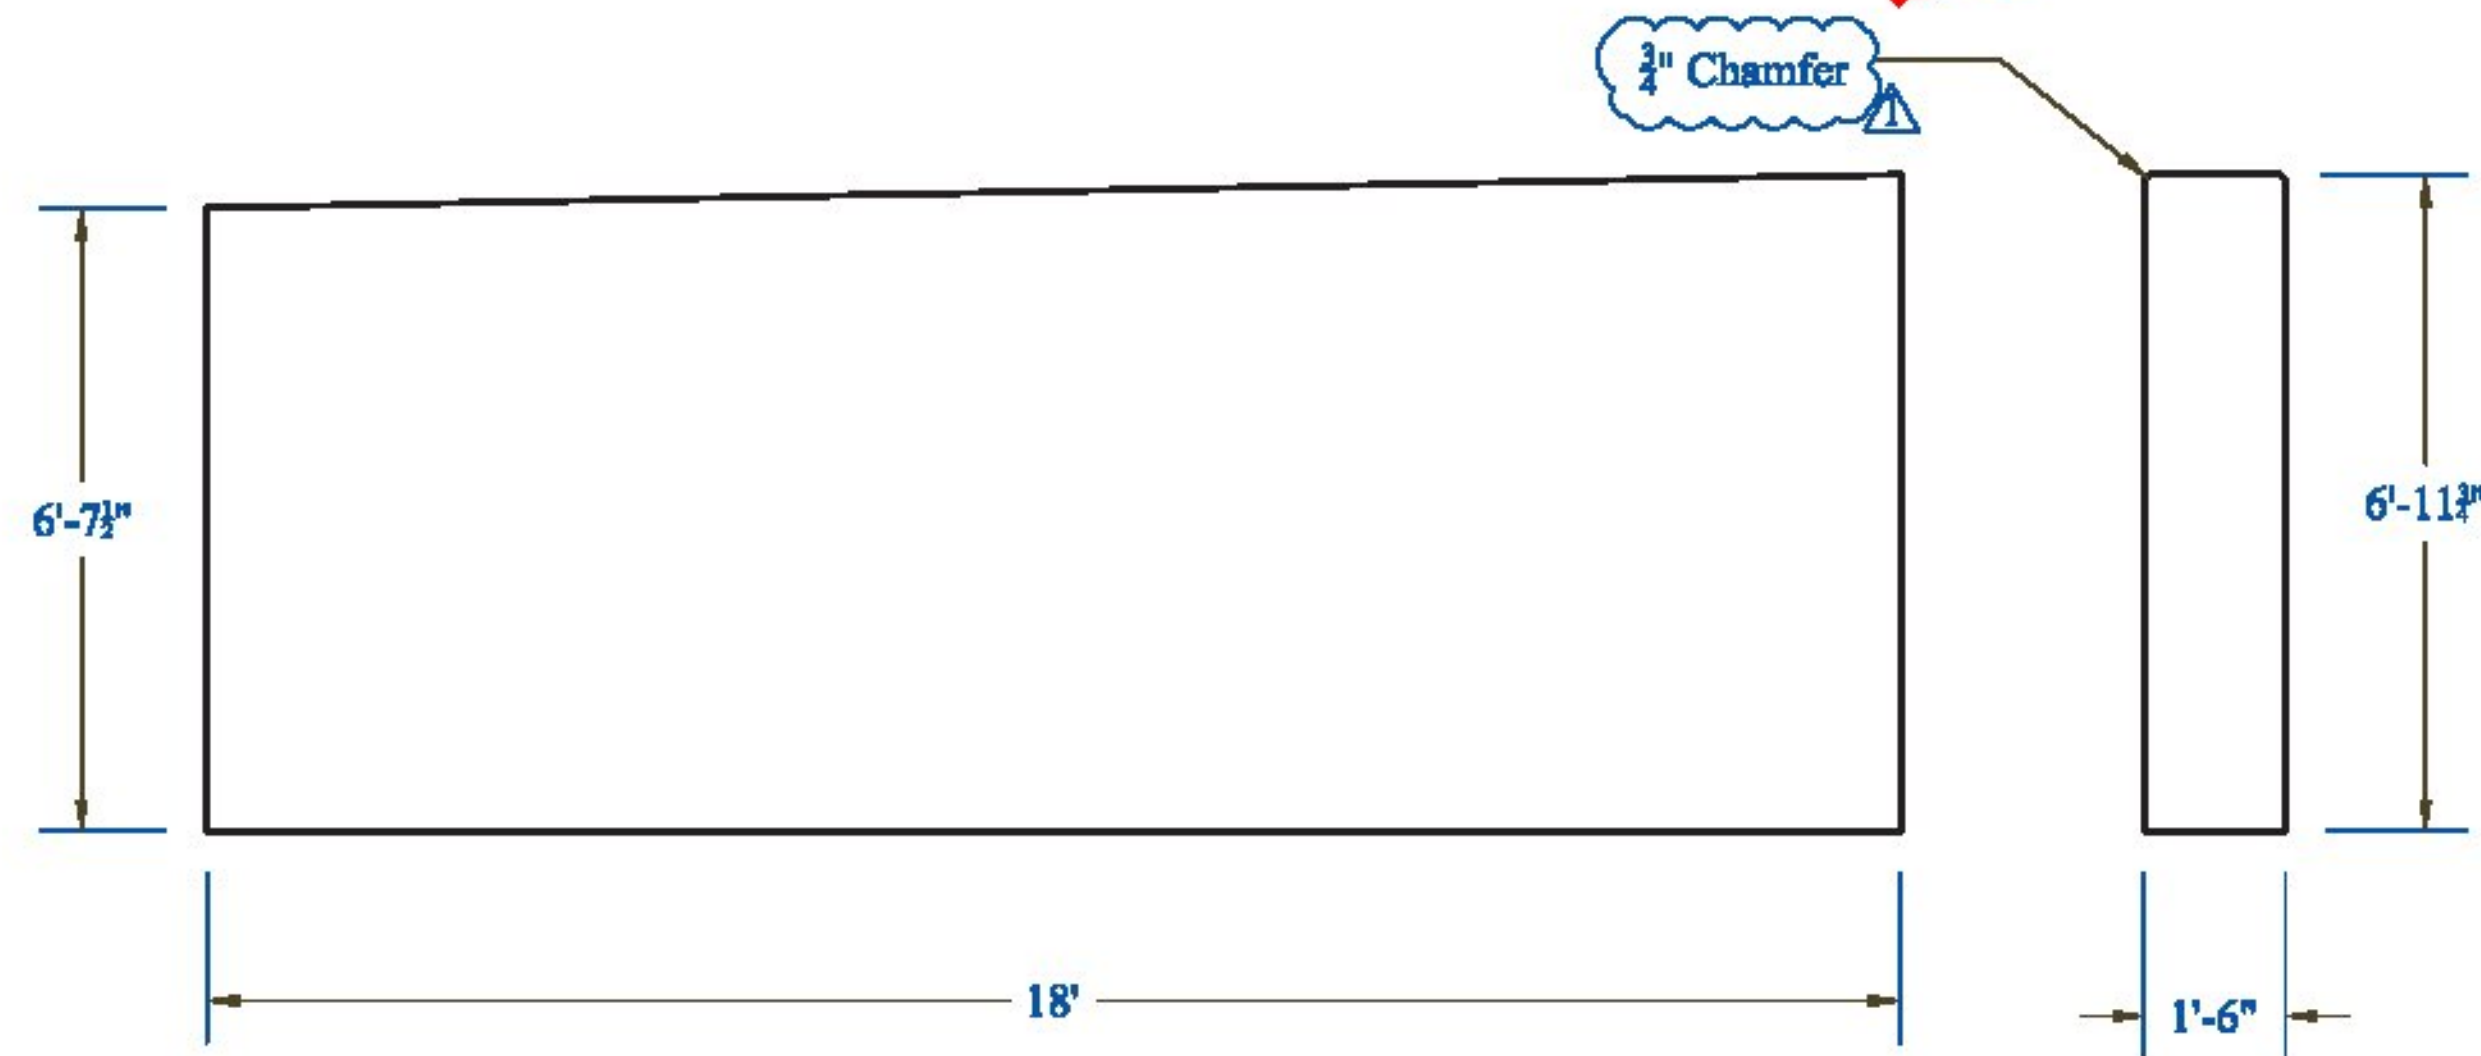

Retaining Wall Footing

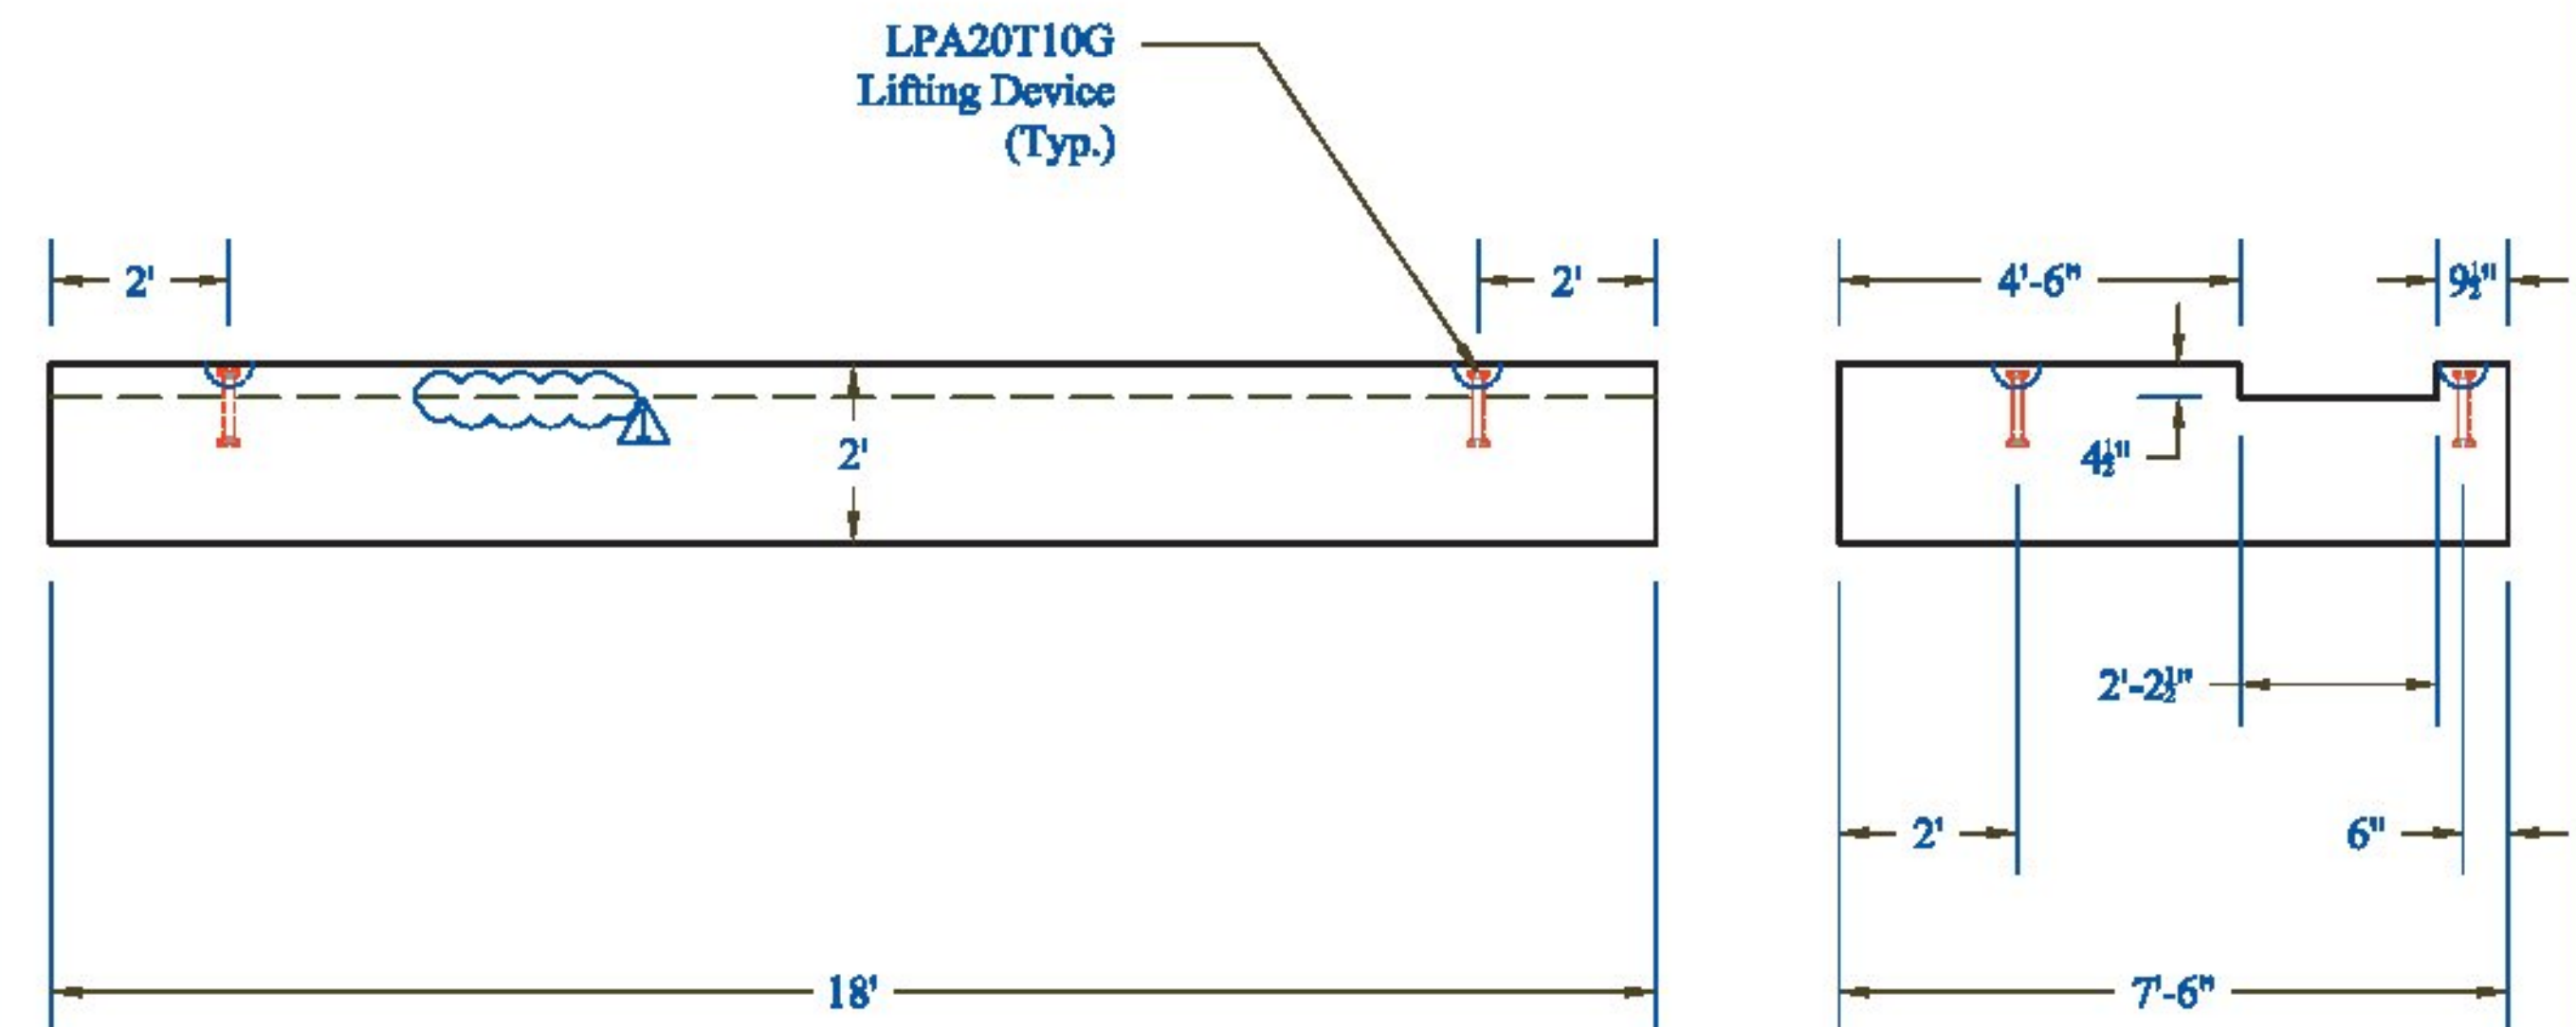

Vermont Agency of Transportation

**RECEIVED**

CK'D BY CLB OK'D BY DRP

January 13, 2015

RESUBMIT NO Approved AsNoted  
BY C. CARLSON DATE 01/15/15

Review

PRECAST CONCRETE ABUTMENT SHOP DRAWINGS (SDI JOB #15163)

SUPERVISOR: M. WHEELER  
DETAILER: I. ADAMS  
CHECKER: E. Barendse  
ENGINEER:

PROJECT NAME:  
Stowe BR# 0235 (II)  
PROJECT #: 0235 (II)  
LOCATION: Stowe, VT

INSTALLER:  
CCS Construction  
135 Munson Ave  
Morrisonville, VT 05661  
PH: 802-888-7701

01/08/15

FABRICATOR:  
193 INDUSTRIAL AVE.  
WILLISTON, VT 05495  
PH: (802) 658-0201



Retaining Wall Details

7 of 11